



**1** EXISTING ENTRY LEVEL FLOOR PLAN  
1,062 SQFT GROSS MEASURED AREA  
98 SQFT MEASURED EXTERIOR SURFACES

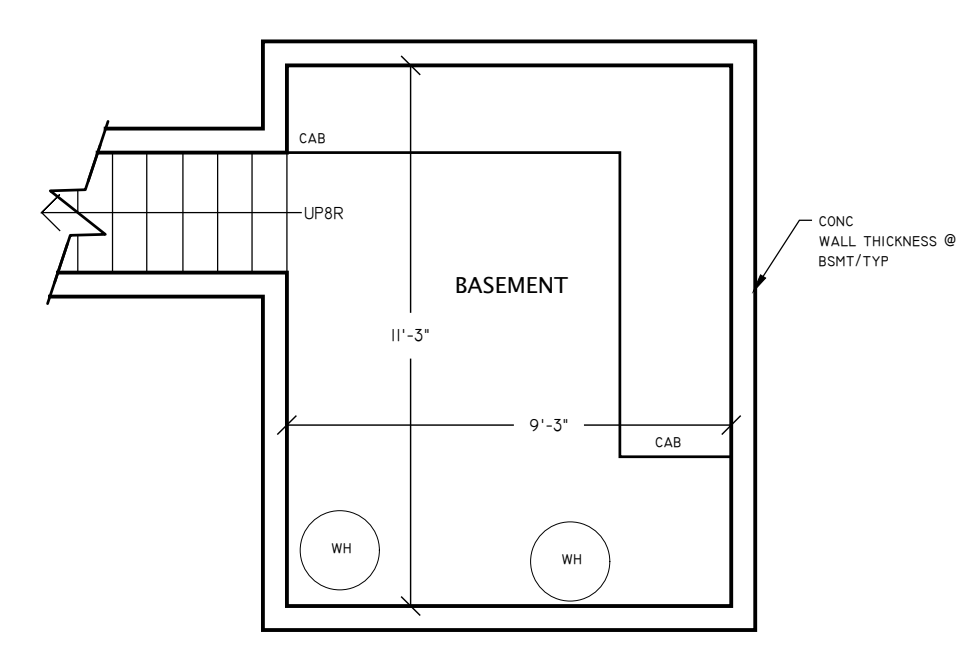

**2** EXISTING BASEMENT LEVEL FLOOR PLAN  
142 SQFT GROSS MEASURED AREA

156 CRESCENT AVENUE SUNNYVALE, CA 94087		
<small>THIS DRAWING IS A RECORD OF REAL PROPERTY THAT IS GENERALLY ACCEPTED TO BE SUITABLE FOR USE IN PLANNING, DESIGN, LEASE, AND GENERAL ASSET MANAGEMENT. IT SHOULD NOT BE USED TO DETERMINE EXACT MEASUREMENTS OF SPACES OR ARTIFACTS FOUND HEREIN FOR ANY PURPOSE.</small> <small>EXTERIOR ELEMENTS HAVE BEEN MEASURED AND DRAFTED FOR REFERENCE ONLY - THIS IS NOT A SURVEY.</small>		
		
<b>EXISTING FLOOR PLAN</b>		
REF: 156f_South_SFD REV: 0 DRAWN BY: AL AUDITED BY: TL	SHEET SIZE: 24x36 SCALE: 1/4"=1'-0" FIELD MEASURE: 08/30/2022	<h1>AX-101</h1> <p>1 OF 2</p>

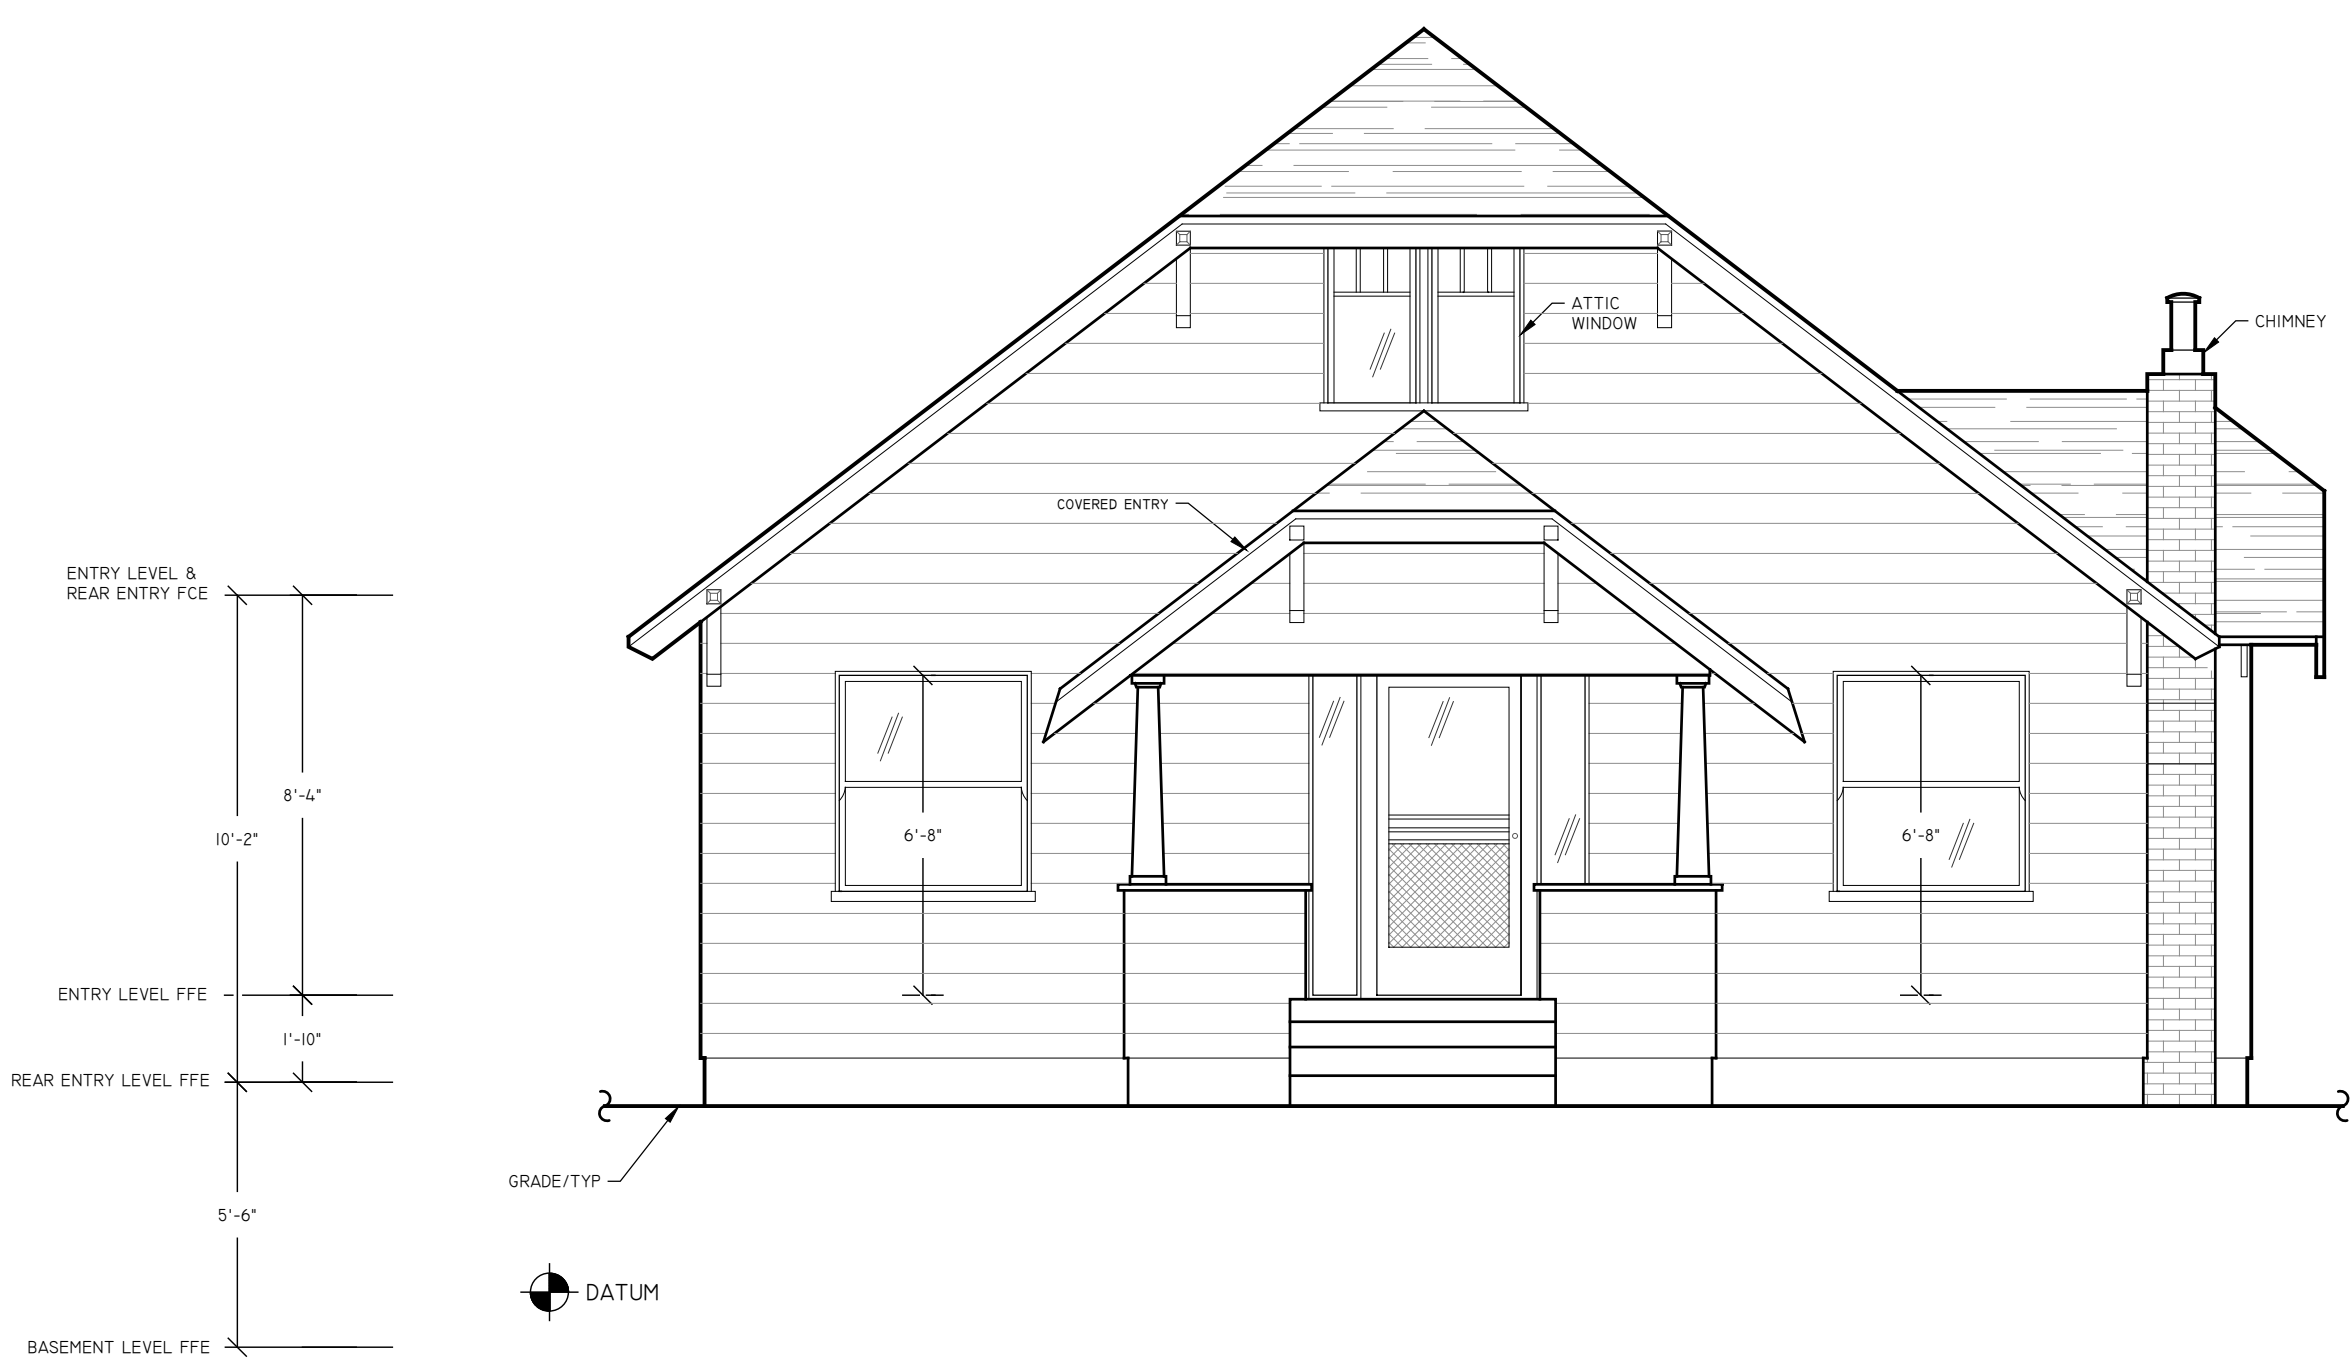


① EXISTING NORTH ELEVATION



② EXISTING EAST ELEVATION



③ EXISTING SOUTH ELEVATION

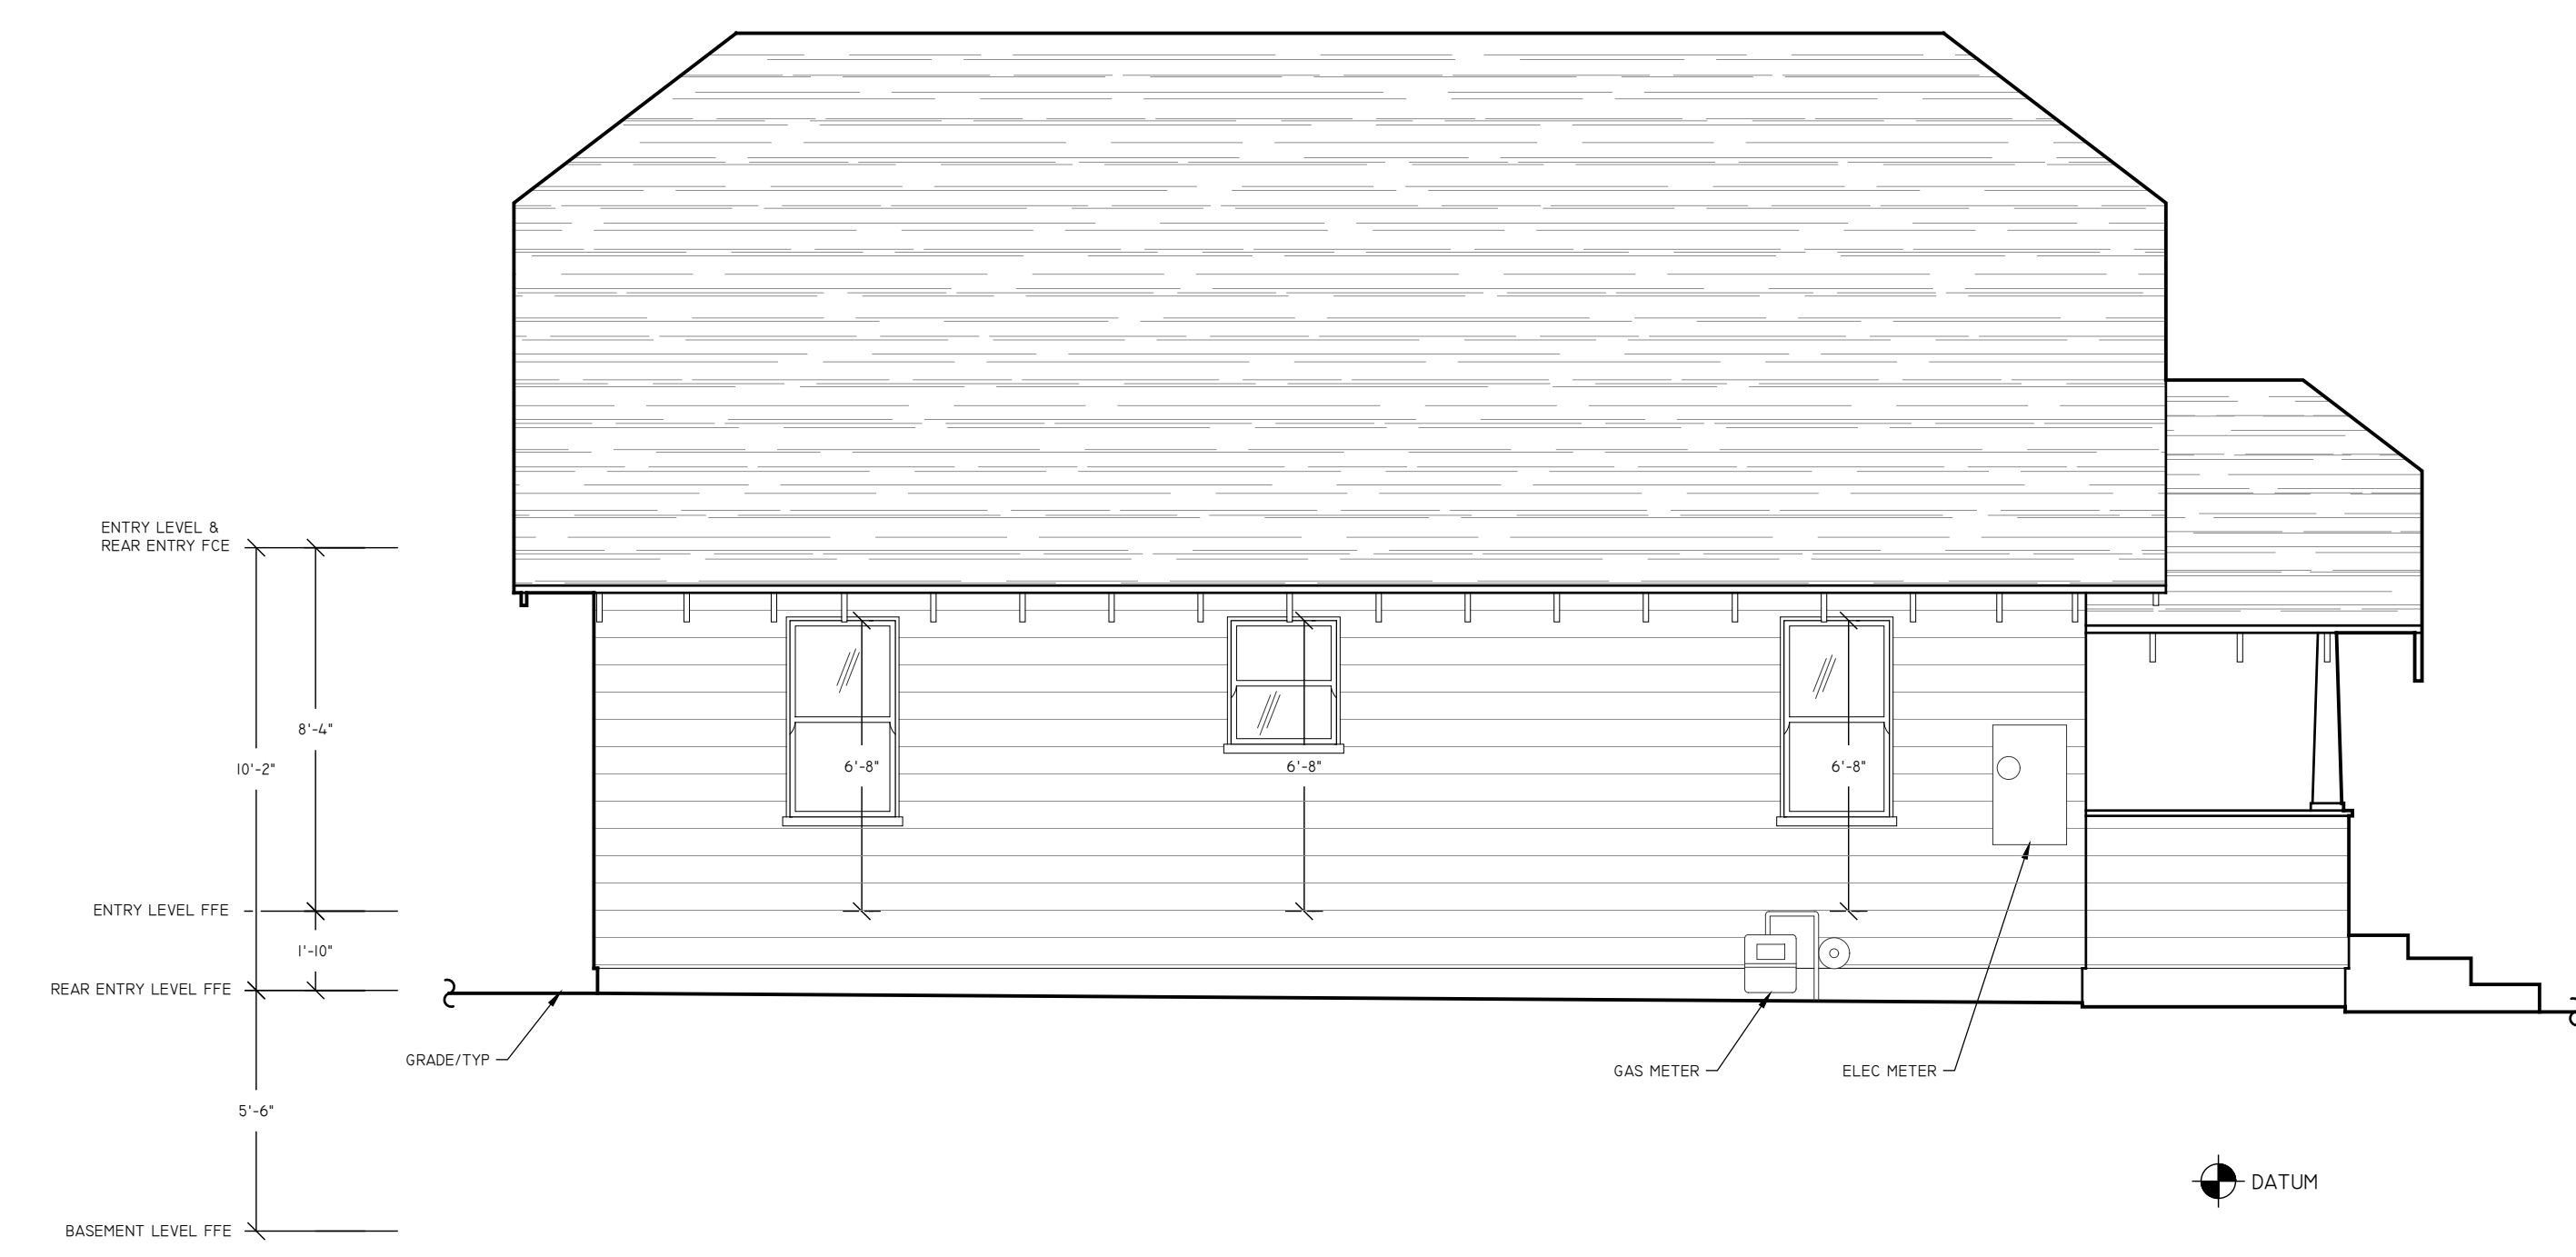

④ EXISTING WEST ELEVATION

<p>156 CRESCENT AVENUE SUNNYVALE, CA 94087</p>	
<p>THIS DRAWING IS A RECORD OF REAL PROPERTY THAT IS GENERALLY ACCEPTED TO BE SUITABLE FOR USE IN PLANNING, DESIGN, LEASE, AND GENERAL ASSET MANAGEMENT. IT SHOULD NOT BE USED TO DETERMINE EXACT MEASUREMENTS OF SPACES OR ARTIFACTS FOUND HEREIN FOR ANY PURPOSE.</p> <p>EXTERIOR ELEMENTS HAVE BEEN MEASURED AND DRAFTED FOR REFERENCE ONLY - THIS IS NOT A SURVEY.</p>	 <p><b>ASBUILT SERVICES</b> FOR THE RECORD SINCE 1990 1-800-318-0099 ASBUILTSERVICES.COM</p>
<p>EXISTING EXTERIOR ELEVATIONS</p>	
<p>REF: 156f_South_SFD REV: 0 DRAWN BY: AL AUDITED BY: TL</p>	<p>SHEET SIZE: 24x36 SCALE: 1/4"=1'-0" FIELD MEASURE: 08/30/2022</p>
<p><b>AX-201</b> 2 OF 2</p>	