

Addendum - As Built Changes



EXISTING APPROVED WINDOW VIEWS




NEW VIEW FROM BALCONY




NEW LOFT AND BALCONY ACCESS

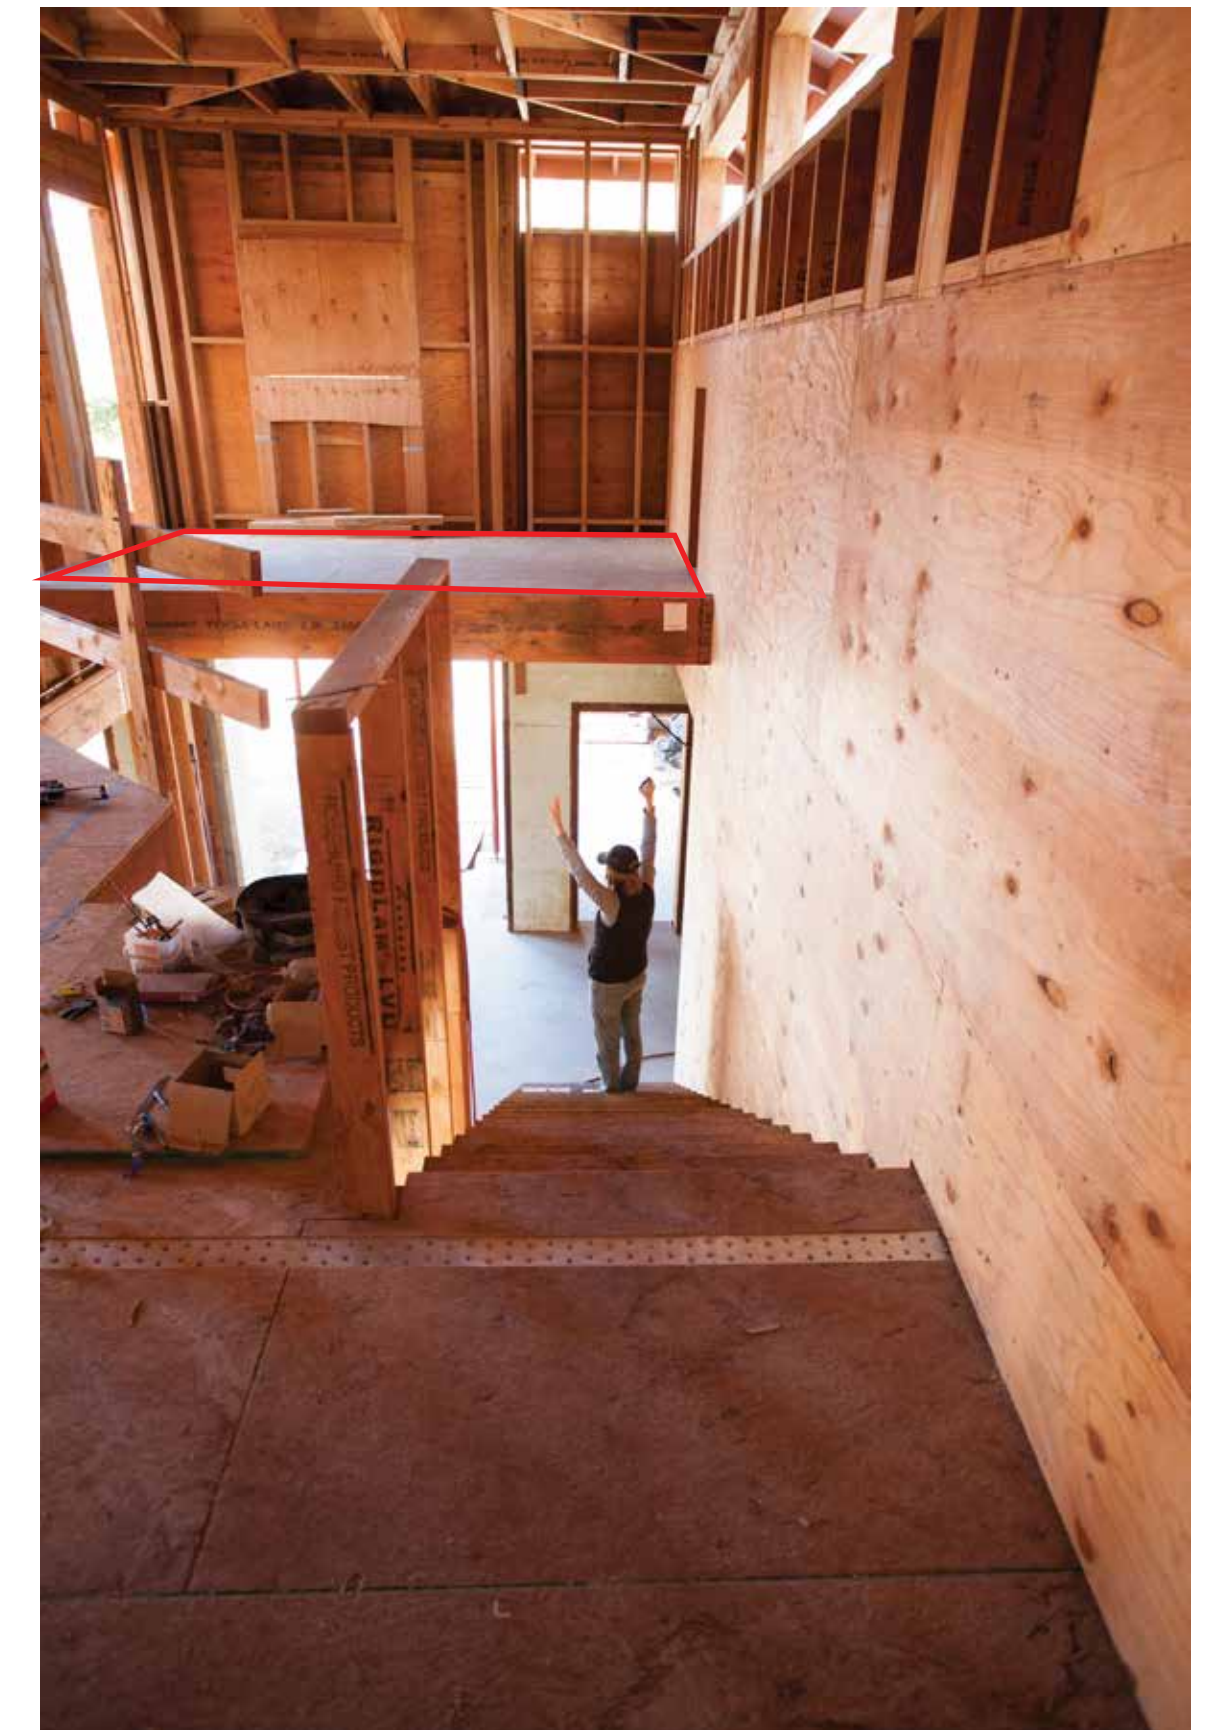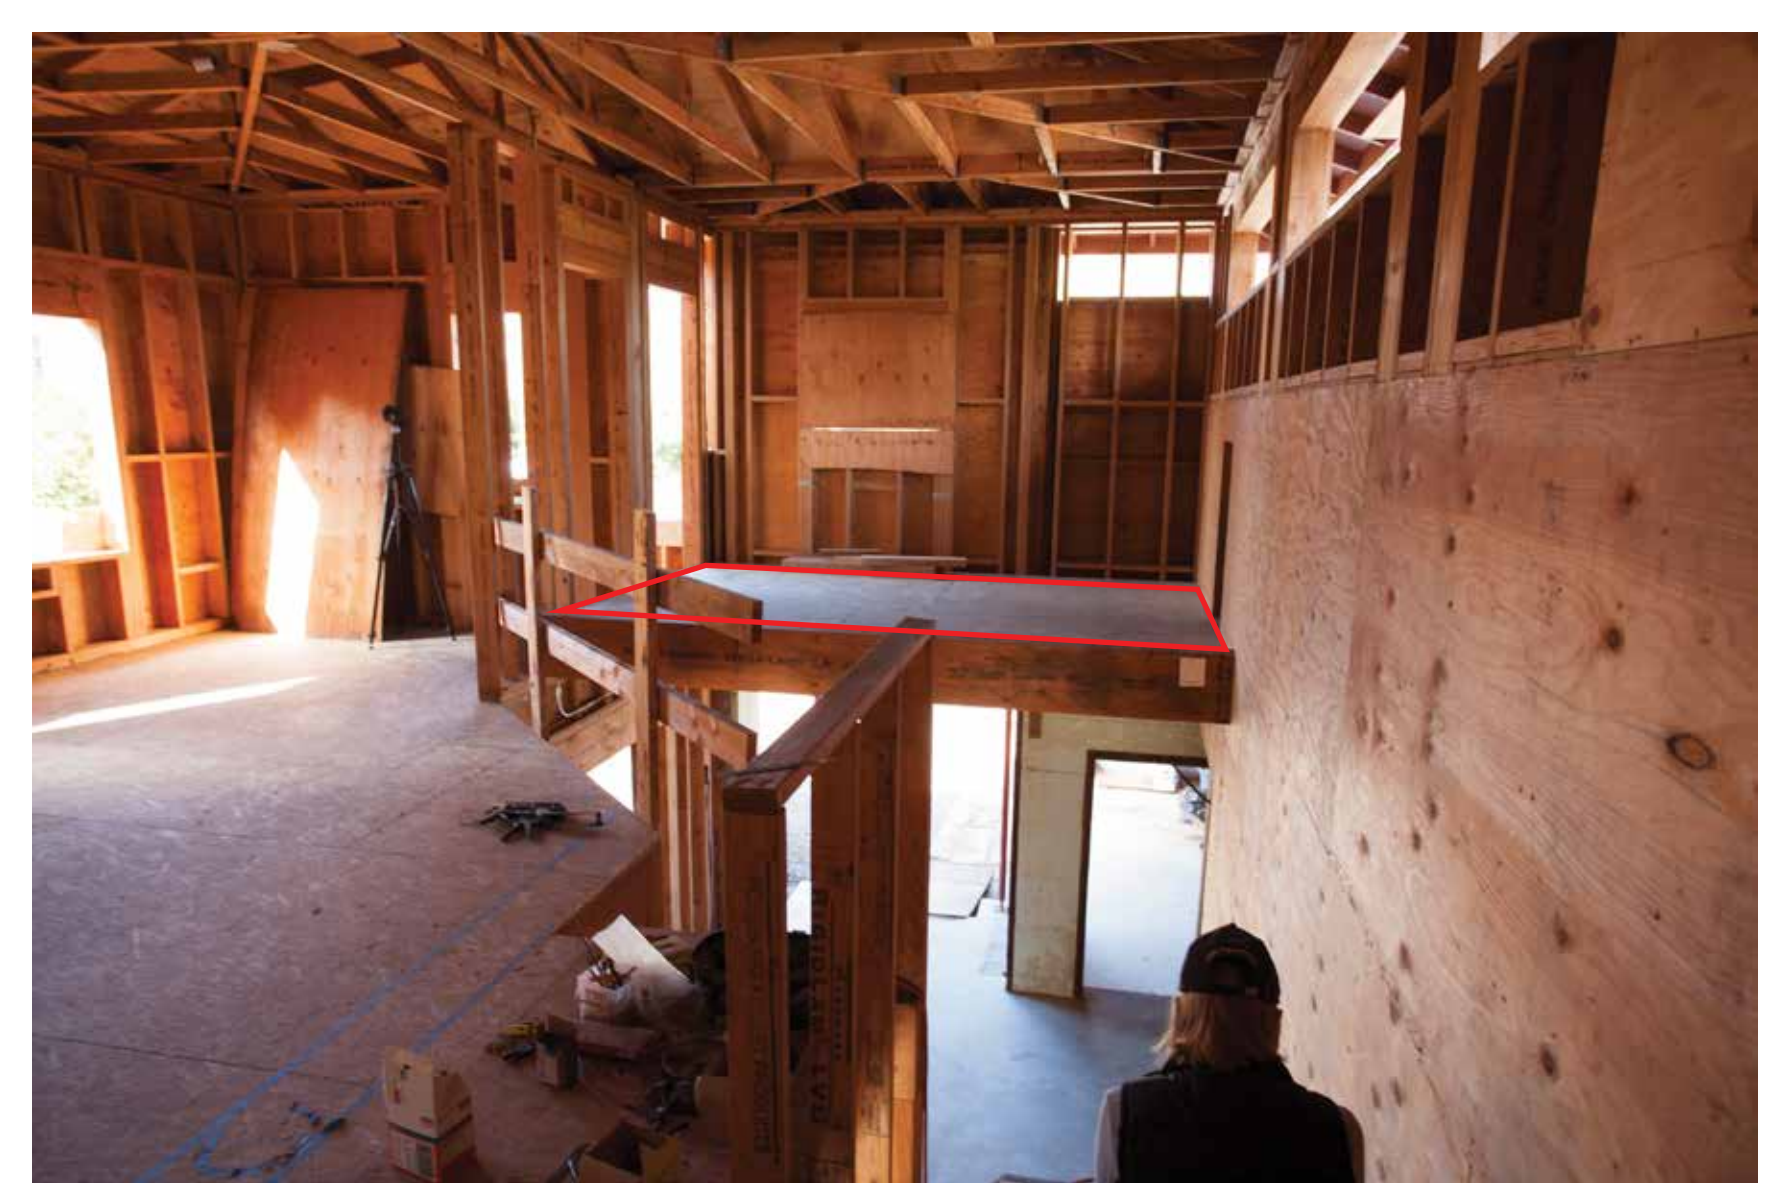[illegible]

Addendum - As Built Changes

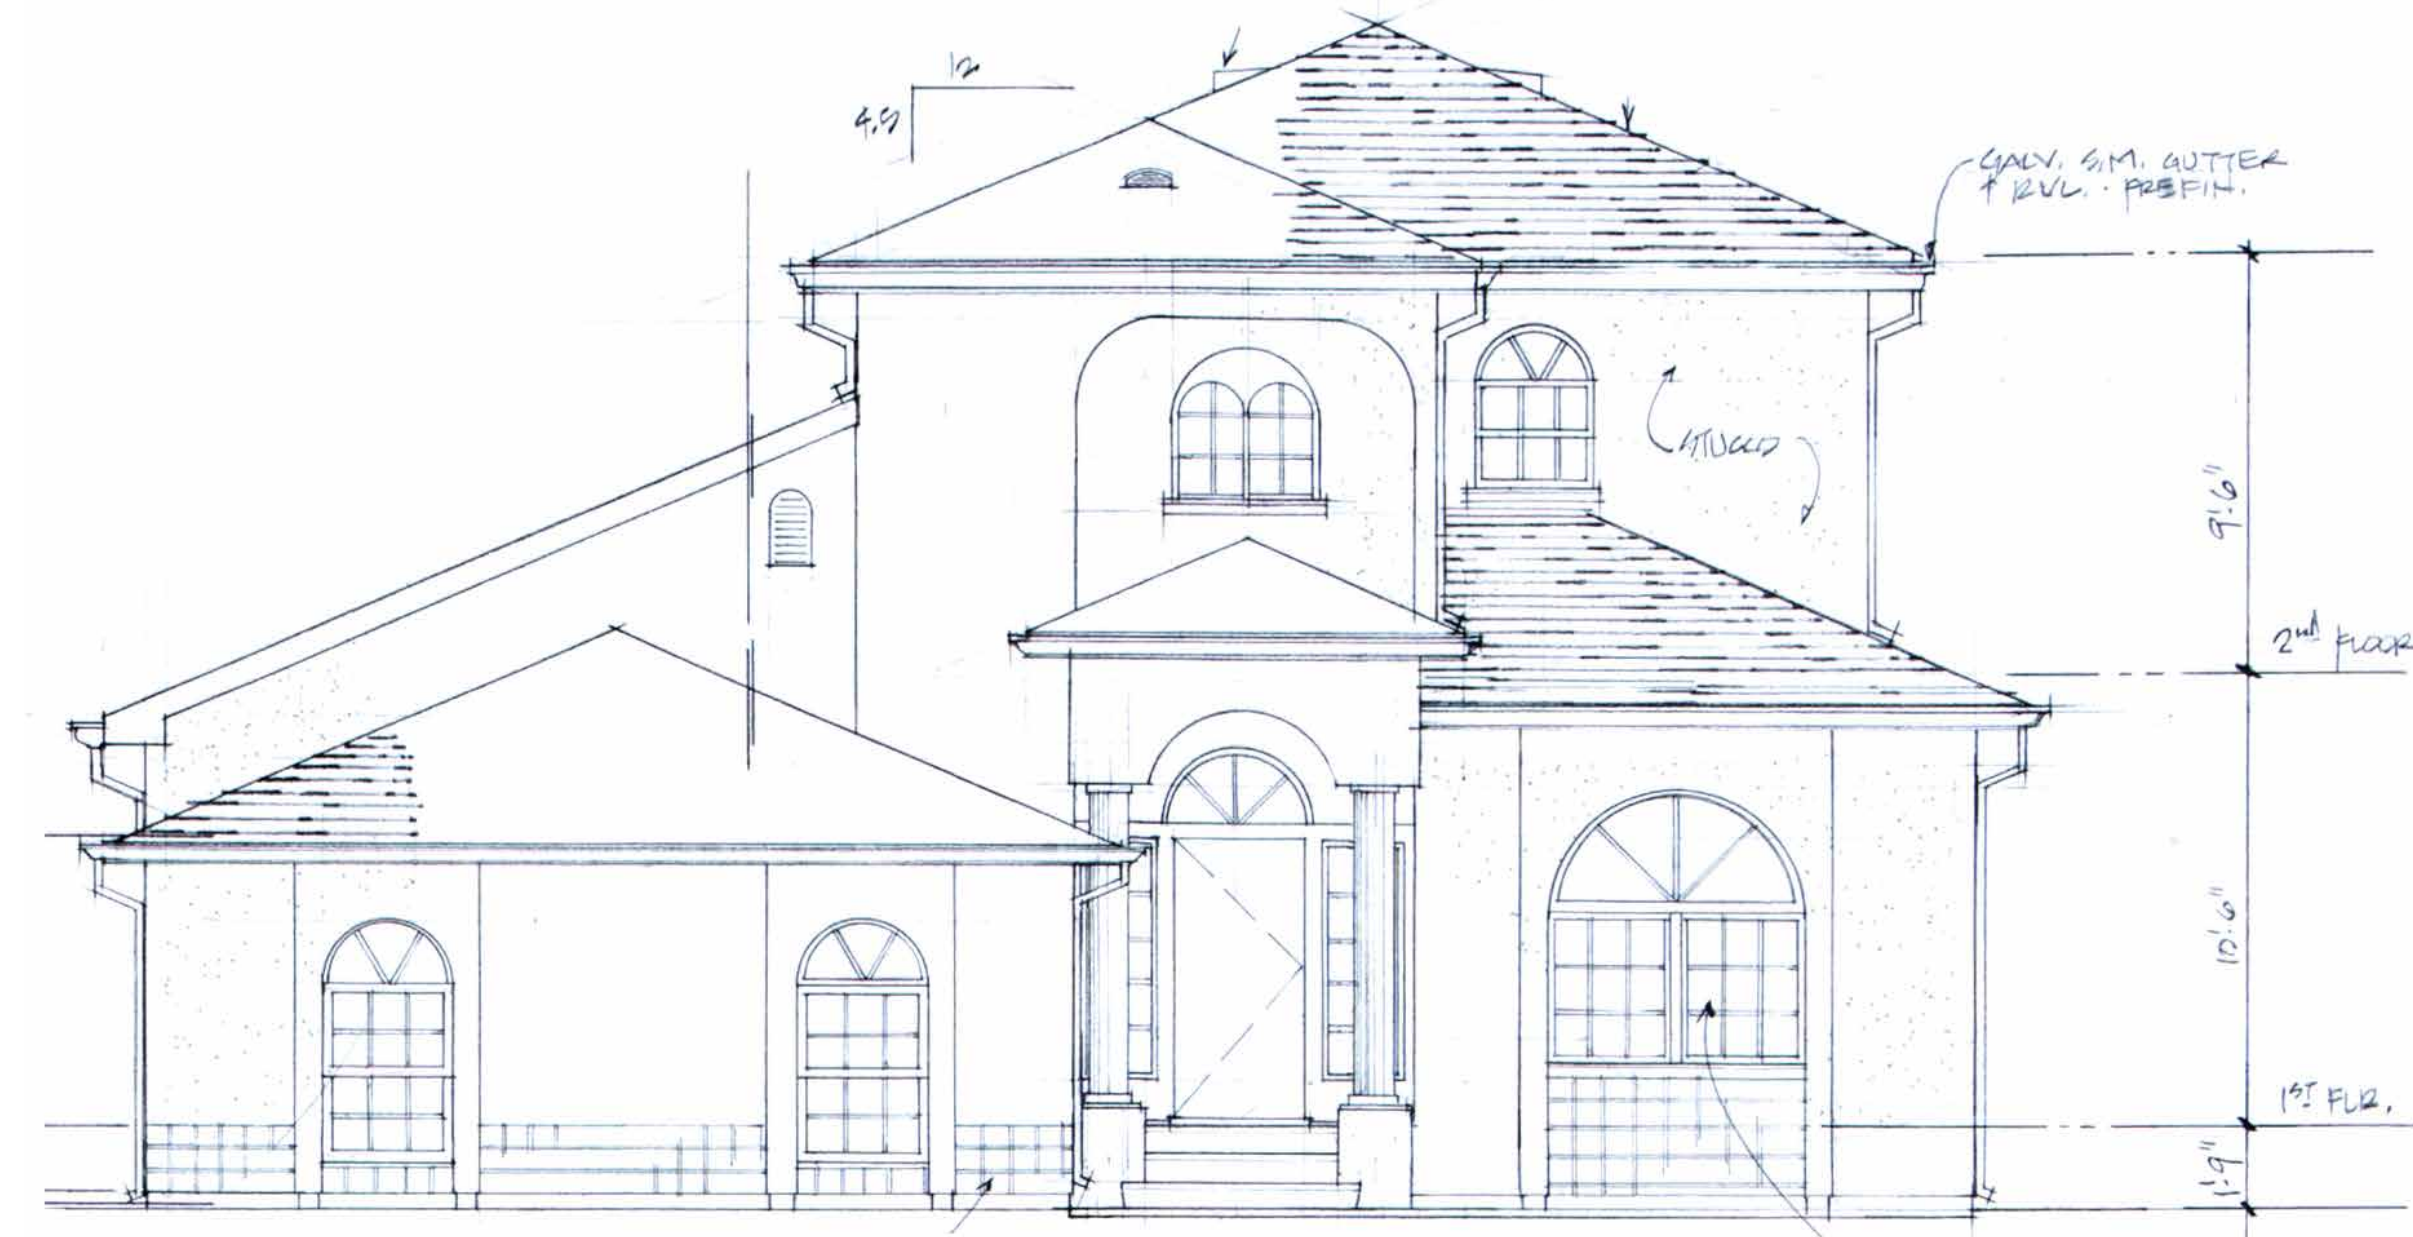


ORIGINAL ELEVATION

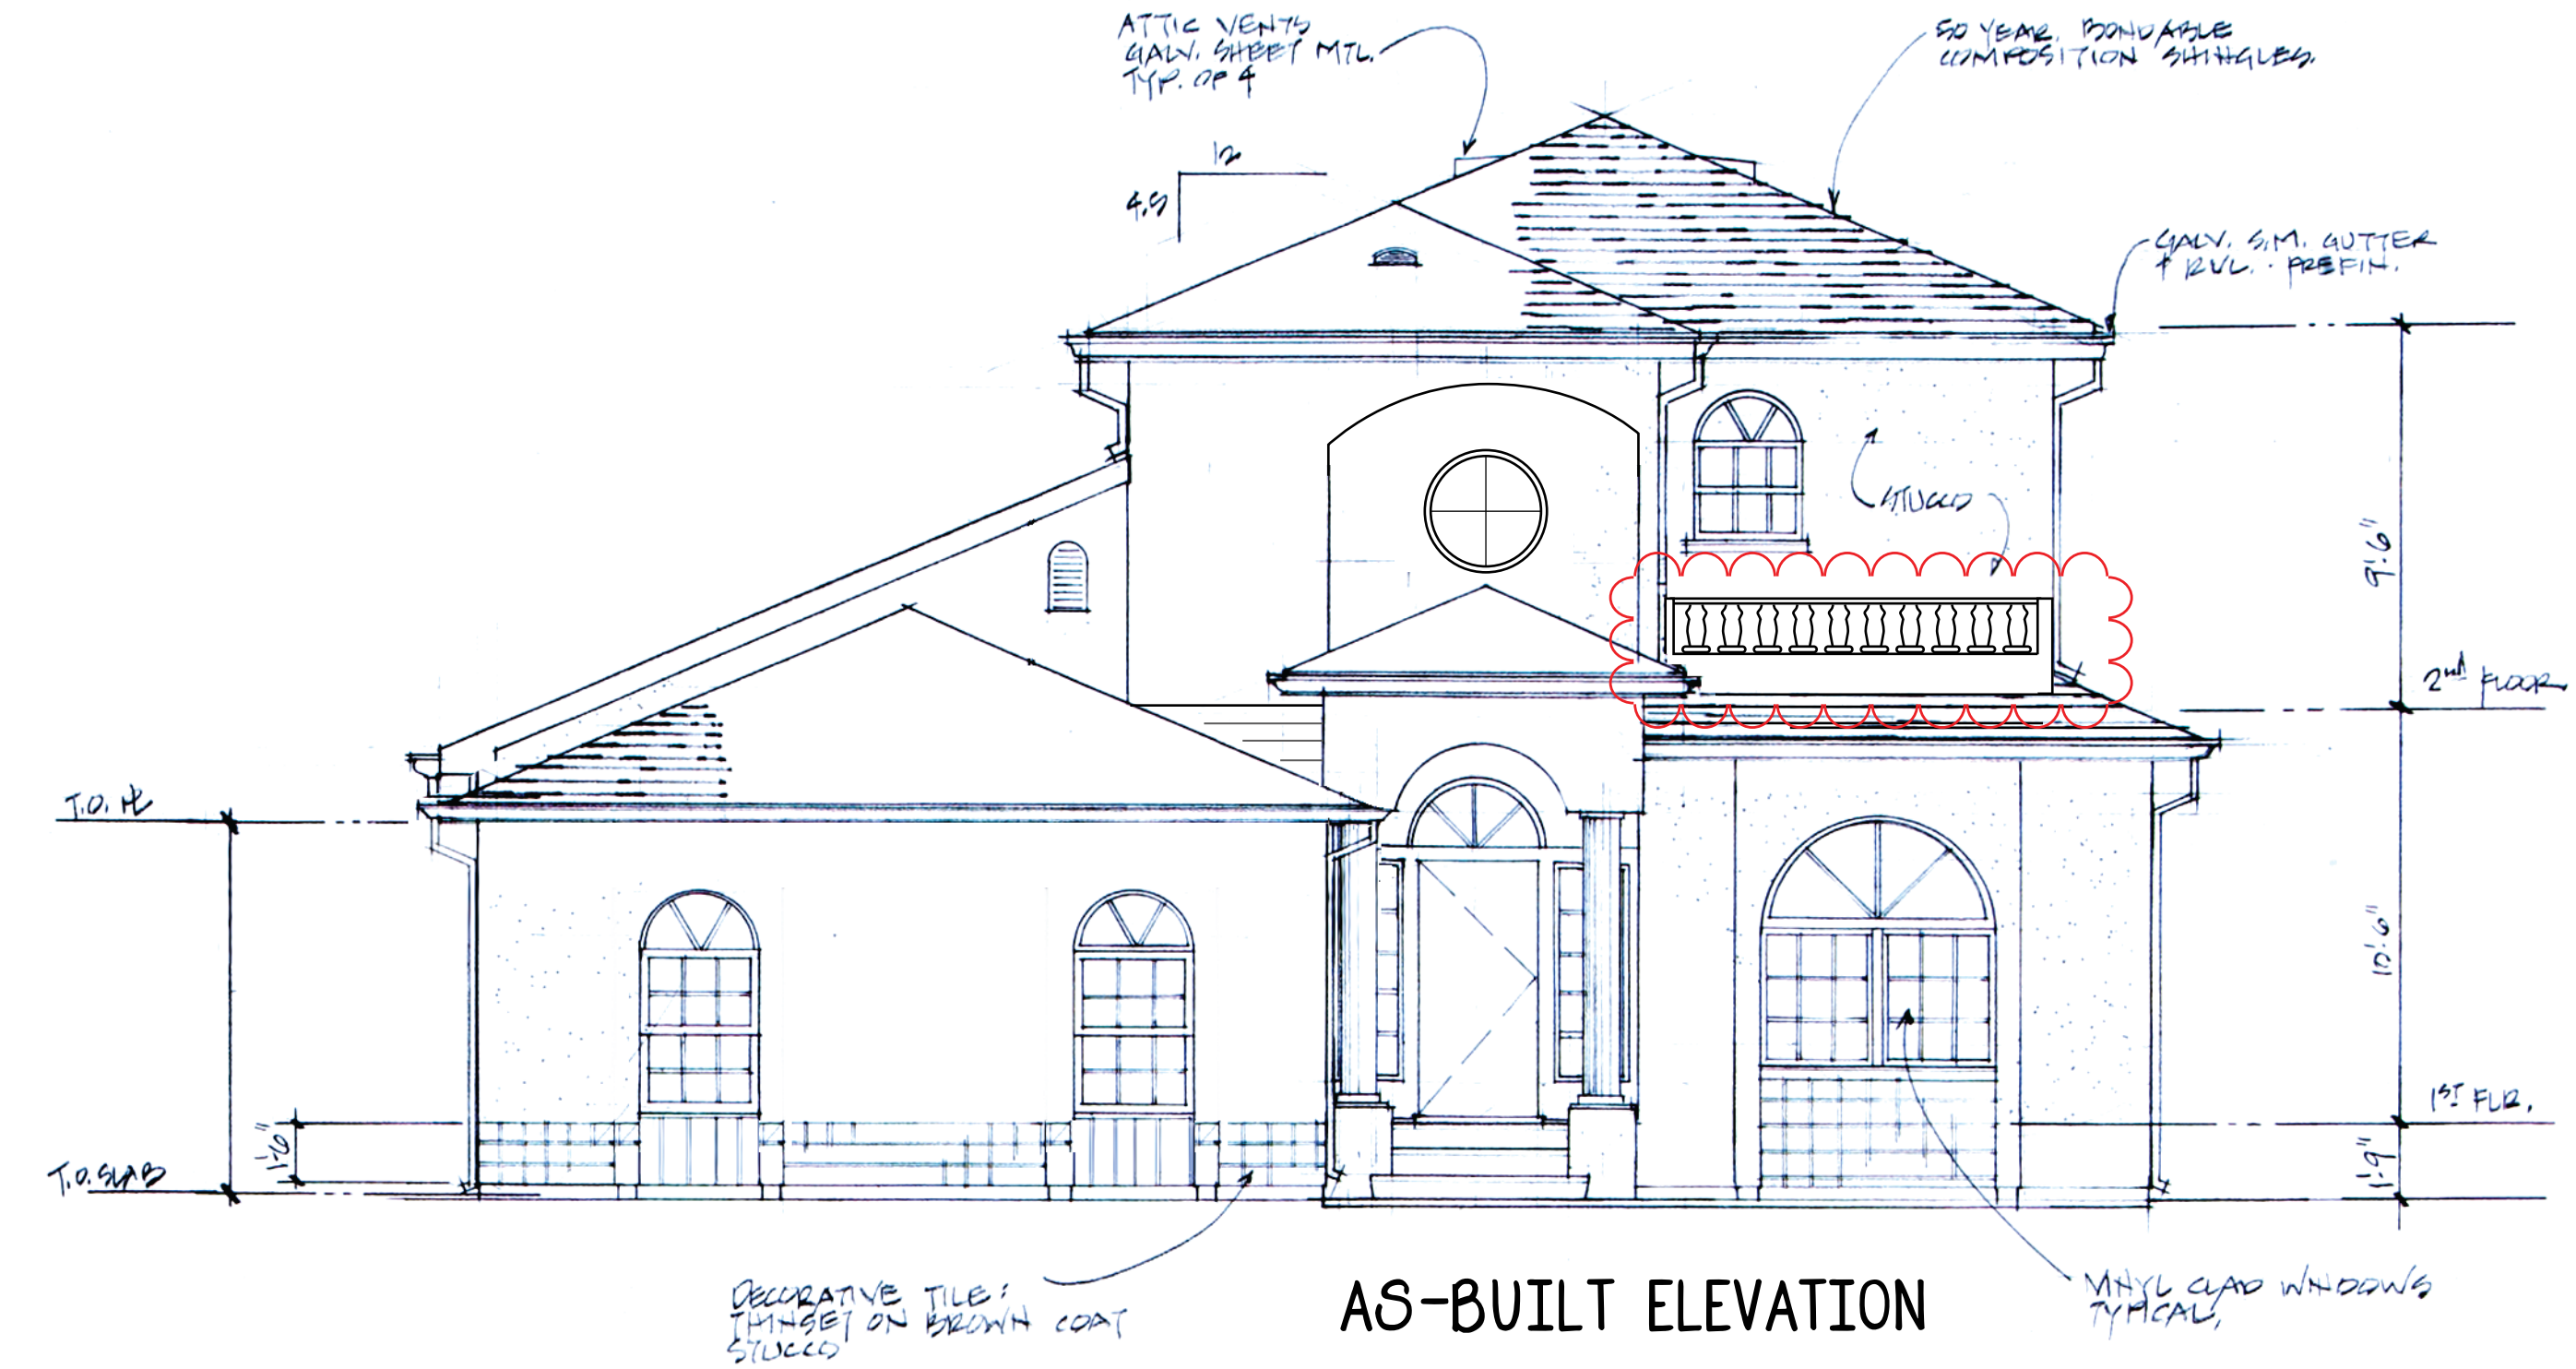


AS-BUILT ELEVATION

1 FRONT ELEVATION (WEST)
A-3

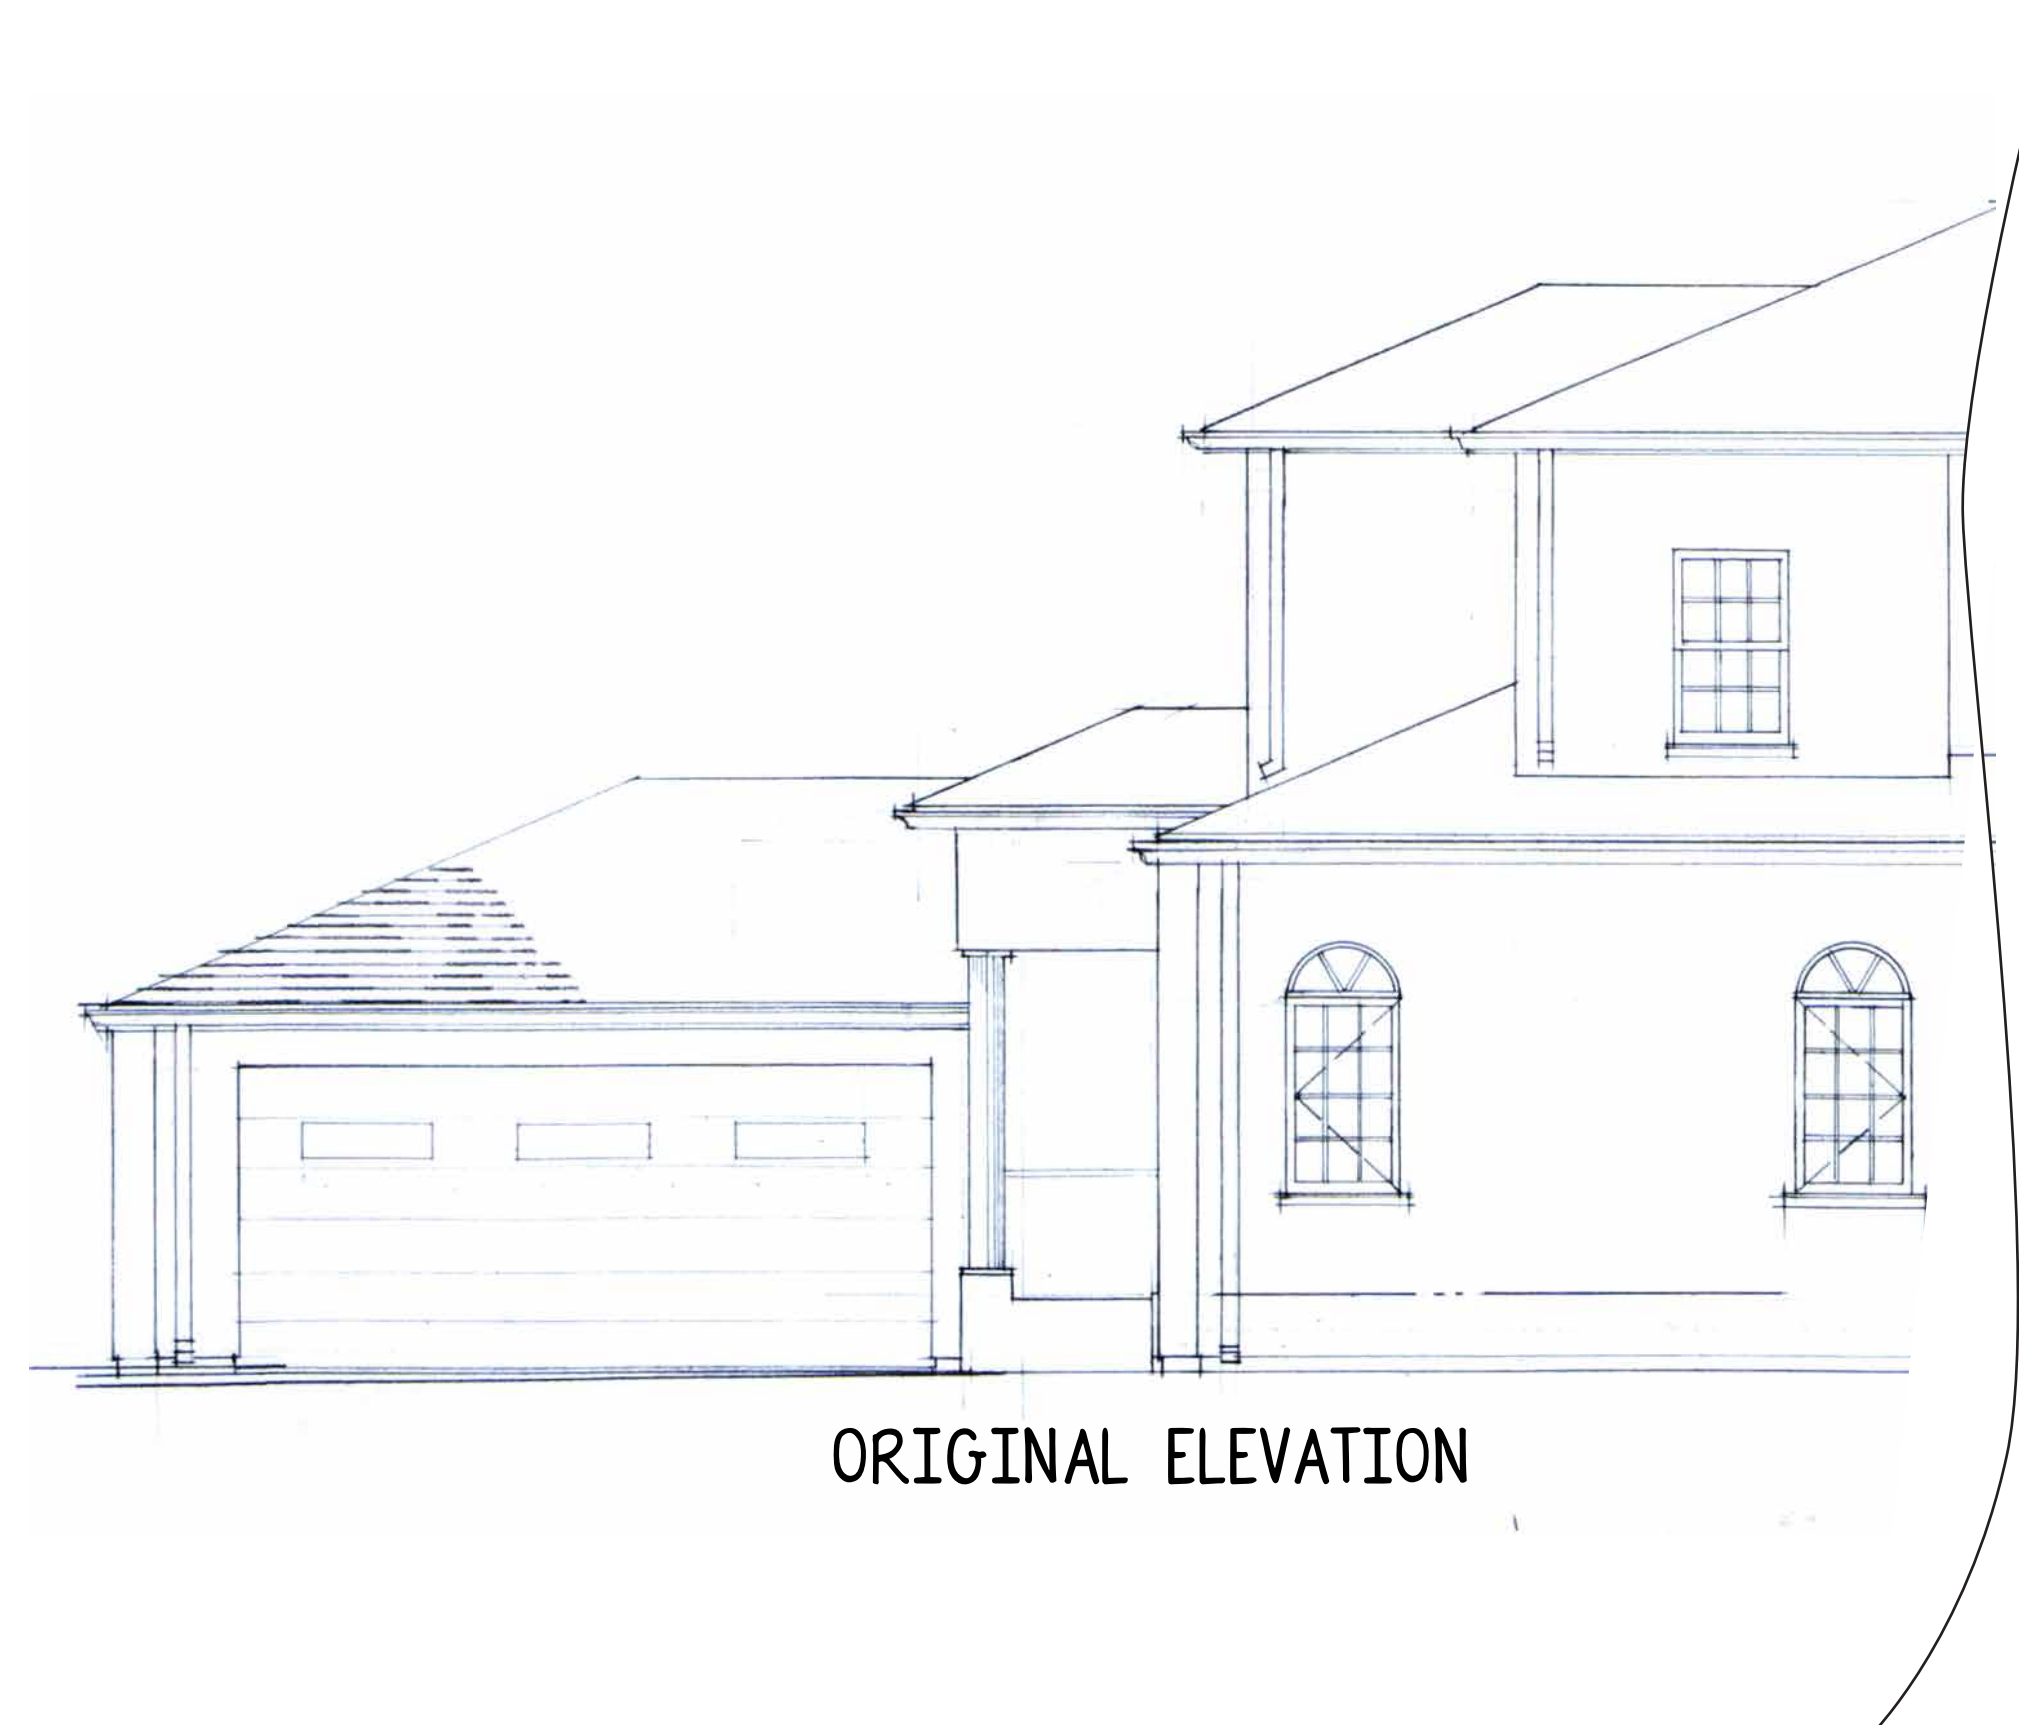

ORIGINAL ELEVATION

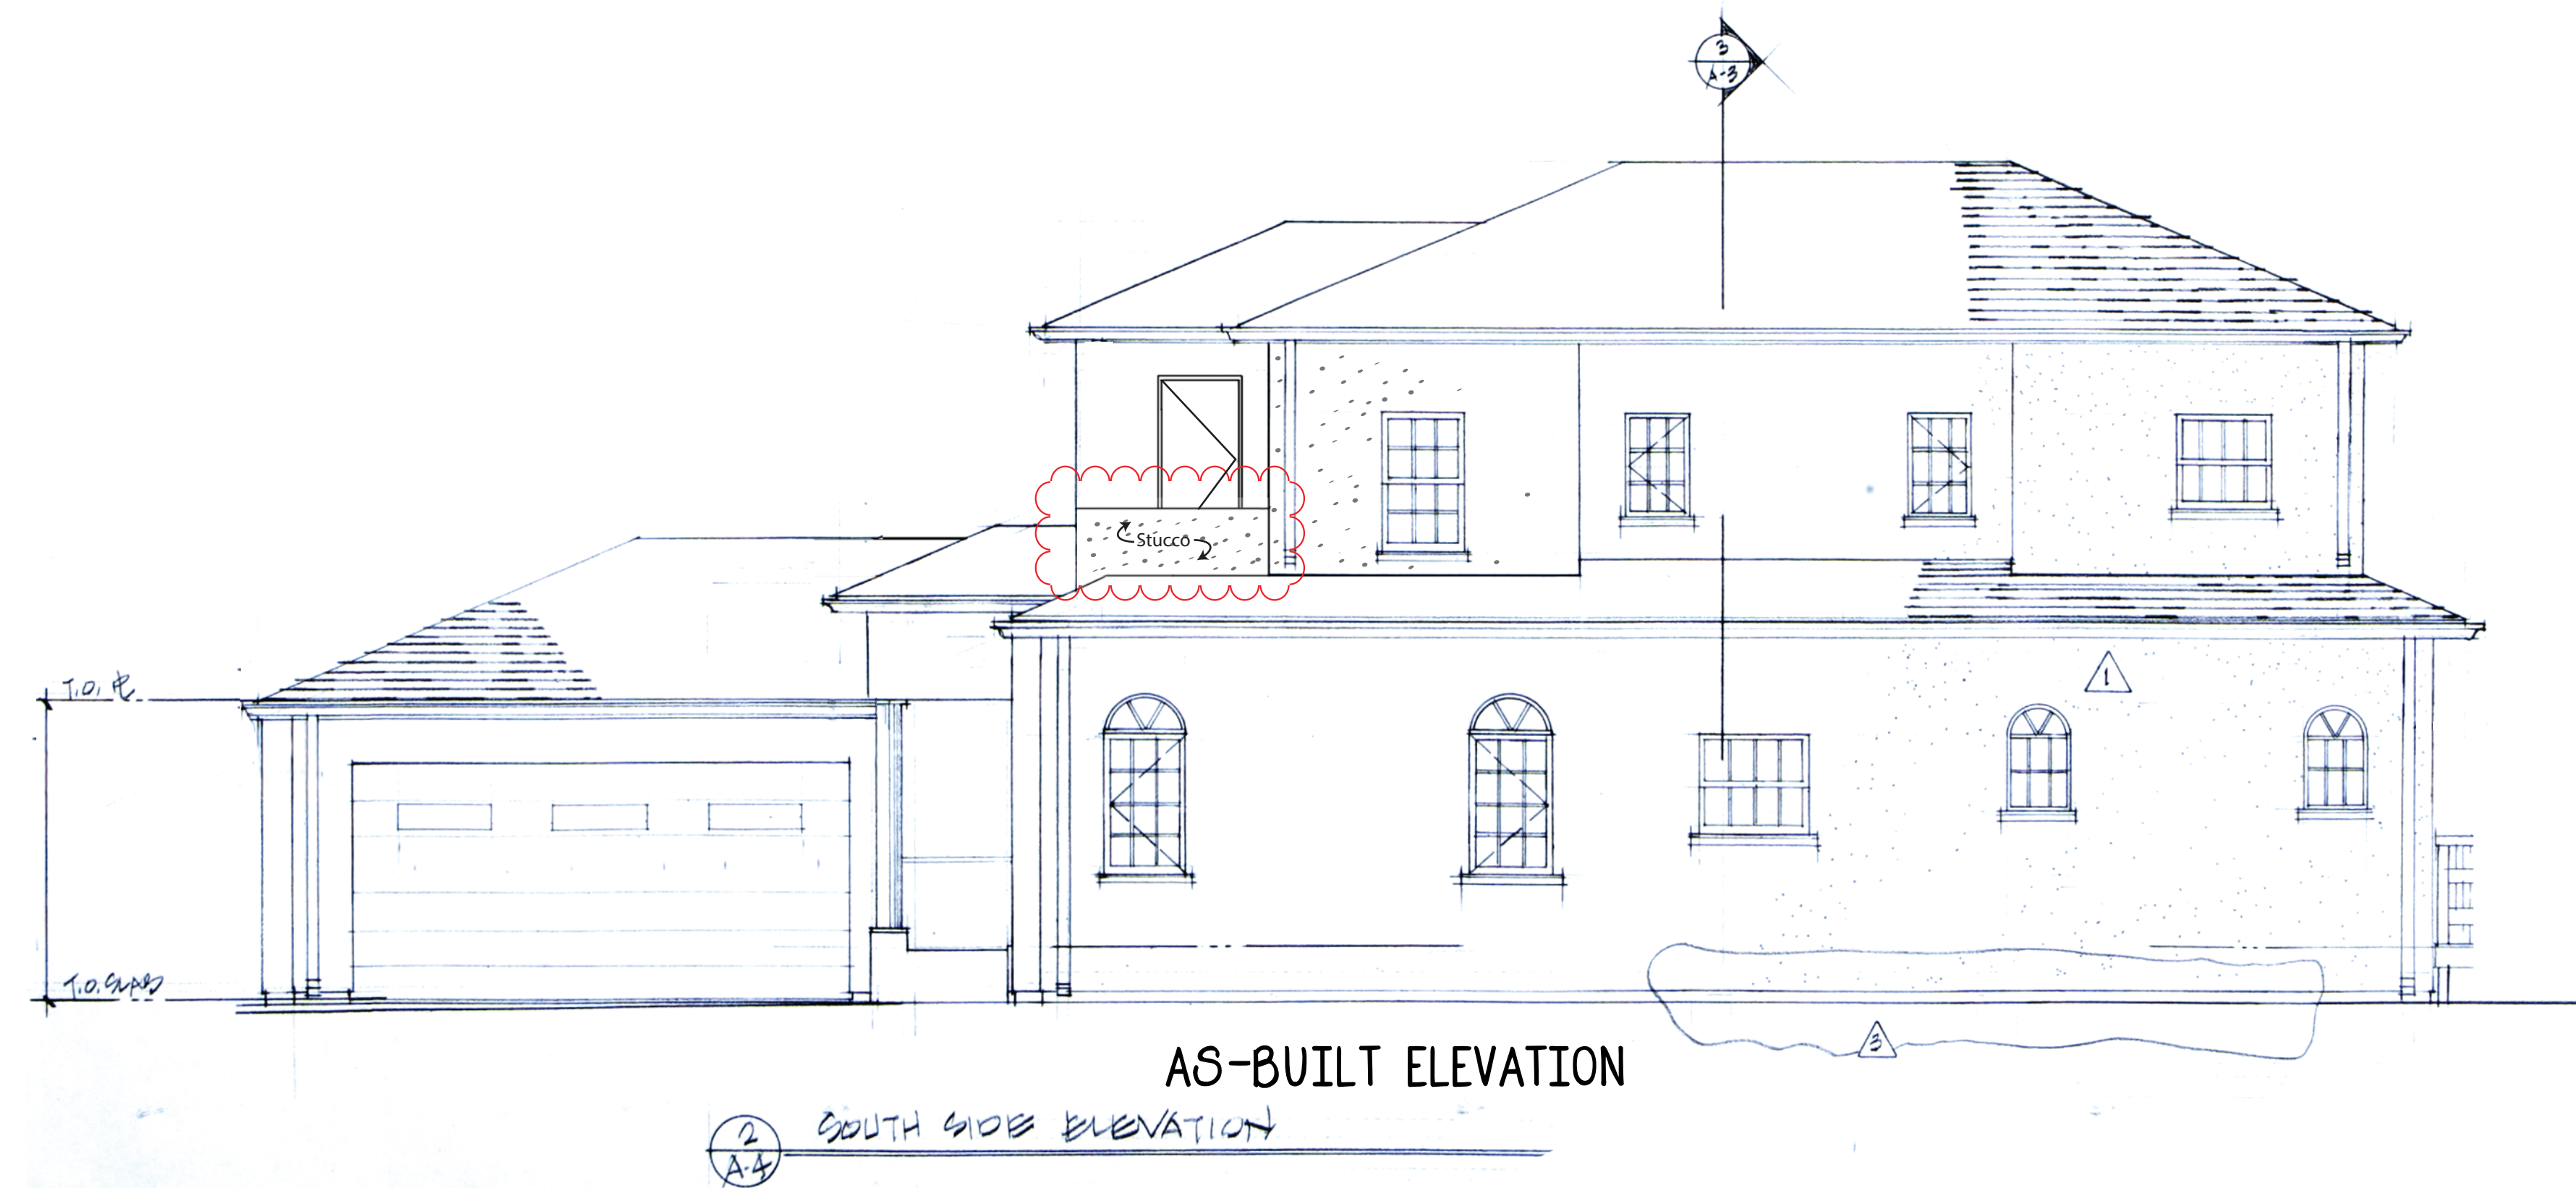

AS-BUILT ELEVATION


2 SOUTH SIDE ELEVATION
A-4

2ND FLOOR ROOF BALCONY - EXTERIOR ELEVATIONS

[illegible]

PROJECT ADDRESS: 726 CAROLINA AVE
REQUEST TO ADD ADDITIOINAL 110 SQ FT OF LOFT SPACE AND EXTERIOR 2ND FLOOR BALCONY
LOFT OCCUPIES SPACE IN EXISTING FRONT 2-STORY FRONT ENTRY

CHANGE IN FAR FROM 48.0% TO 49.7%

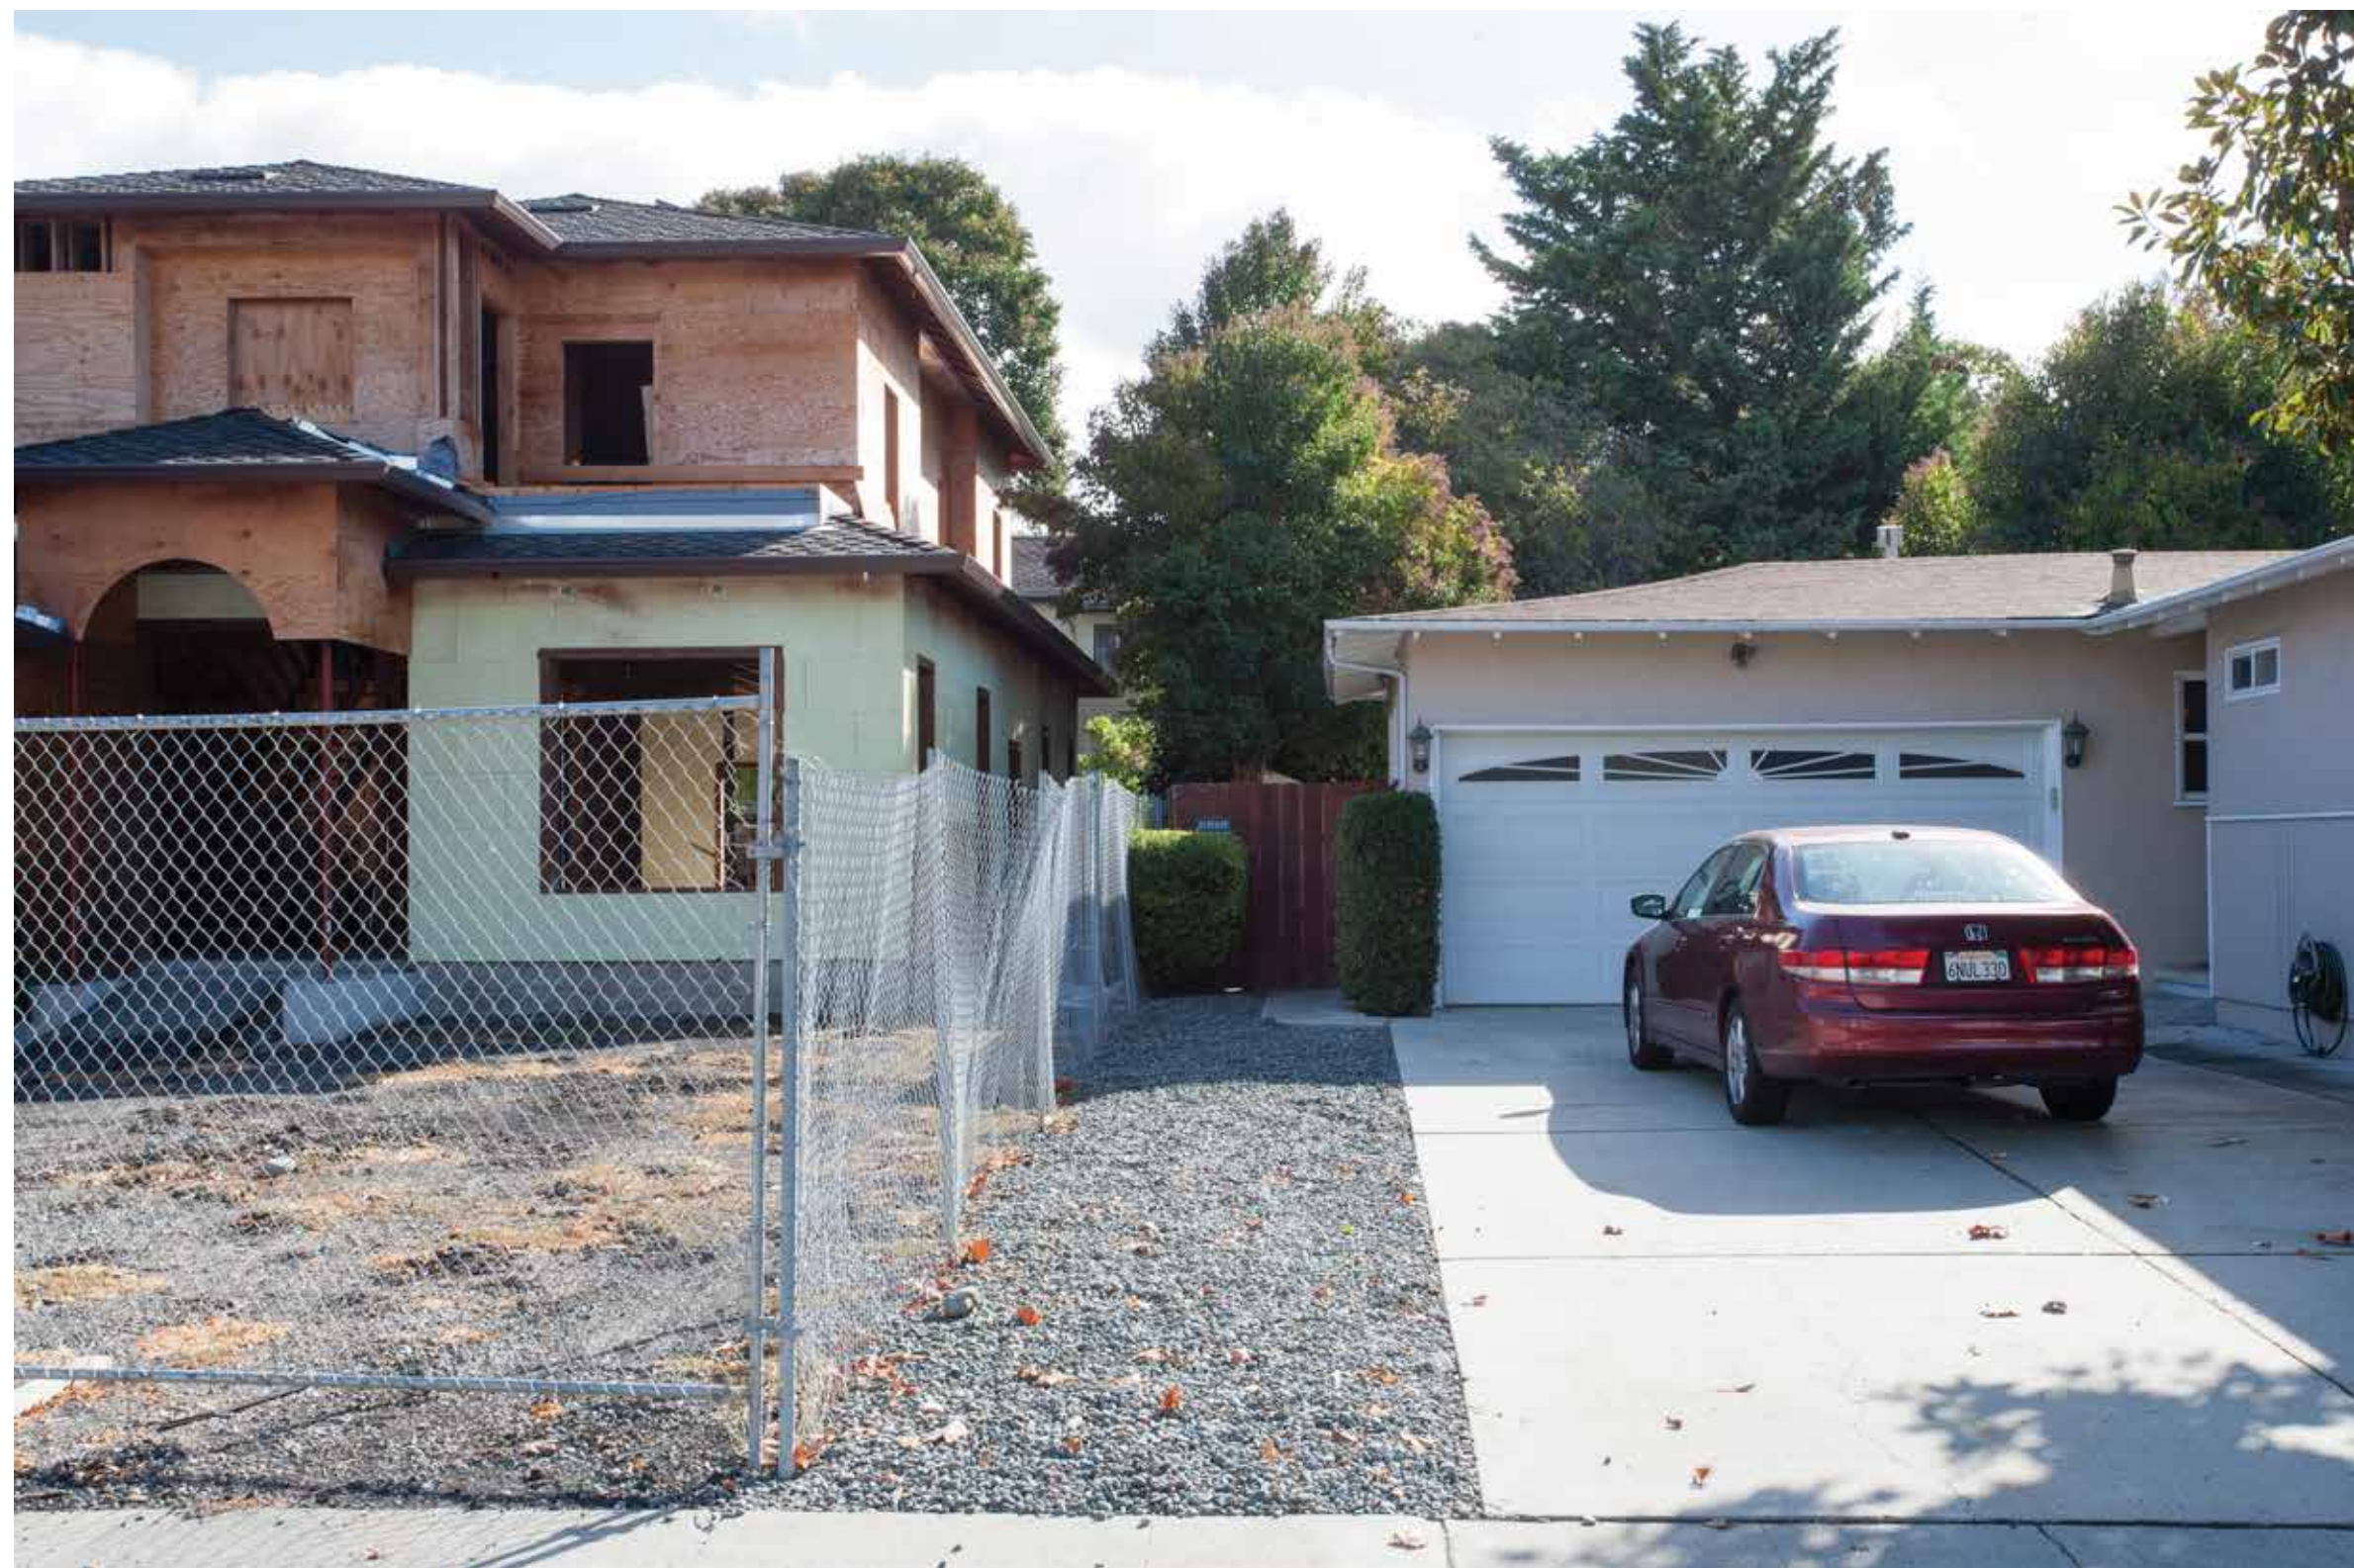

EXISTING PROJECT DATA

Site Area	6.401	S.F.
First Flr Living	1,875	
Second Floor Living	647	
Garage	548	
Lot Coverage	- 37.8%	2.423 S.F.
FAR	- 48.0%	3.070 S.F.

NEW PROJECT DATA

Site Area	6.401	S.F.
First Flr Living	1,875	
Second Floor Living	647	
NEW - Second Floor Loft	110	← NEW
Garage	548	
Lot Coverage	- 37.8%	2.423 S.F.
FAR	- 49.7%	3.180 S.F.

					DATE
					REVISIONS
					BY
					NO.
GOLDWORTH RESIDENCE 726 CAROLINA AVE. SUNNYVALE, CA					
PHILIP GOLDWORTH OWNER/BUILDER					
DATE: 8/11/2016					
SCALE:					
DRAWN:					
JOB:					
SHEET					
Project Data					