

ADDITION & REMODELING
1314 LILLIAN AVE.,
SUNNYVALE, CA 94087
APN: 309-09-14



NO.	DESCRIPTION	BY	DATE
1	CORRECTION FROM DESIGN REVIEW 1		10.12.16
2	CORRECTION FROM DESIGN REVIEW 2		11.16.16

GENERAL NOTES:

-ALL CONSTRUCTION SHALL COMPLY WITH ADOPTED ORDINANCES AND POLICIES OF THE GOVERNING AGENCY AND THE LATEST ADOPTED ADDITIONS OF THE FOLLOWING: 2013 CALIFORNIA BUILDING & RESIDENTIAL CODE (CBC, CRC), 2013 CALIFORNIA PLUMBING CODE (CPC), 2013 CALIFORNIA MECHANICAL CODE (CMC), CALIFORNIA FIRE CODE (CFC), CALIFORNIA ELECTRICAL CODE 2013, , CALIFORNIA ENERGY CODE 2013, AND 2013 CALIFORNIA GREEN BUILDING CODE.

- THE CONTRACTOR SHALL ERECT AND MAINTAIN, AS REQUIRED BY EXISTING CONDITIONS AND PROGRESS OF THE WORK, ALL REASONABLE SAFEGUARDS FOR SAFETY AND PROTECTION INCLUDING POSTING DANGER SIGNS AND OTHER WARNINGS AGAINST HAZARDS, PROMULGATING SAFETY REGULATIONS AND NOTIFYING OWNERS AND USERS OF ADJACENT UTILITIES.

- THE CONTRACTOR SHALL BE RESPONSIBLE FOR VERIFICATION OF ALL DIMENSIONS, GRADES AND OTHER CONDITIONS, AND HE SHALL CORRELATE ALL SUCH ITEMS AT THE JOB SITE. HE SHALL REPORT ANY DISCREPANCIES TO THE DESIGNER FOR CLARIFICATION AND/OR CORRECTION PRIOR TO BEGINNING ANY WORK.

- THE CONTRACTOR SHALL BE RESPONSIBLE FOR THE WORK AND COORDINATION OF ALL TRADES WITH THE GOVERNING AGENCIES, AND SHALL PROVIDE ALL MATERIALS AND LABOR SHOWN IN THESE PLANS TO RENDER THE JOB COMPLETE.

CHANGES TO THE PLAN DURING CONSTRUCTION OTHER THAN:


1. CABINET CHANGES WHEN NOT BEING SUPPORTED ENTIRELY BY THE ROOF STRUCTURE,
2. INTERIOR DOOR AND ZERO-CLEARANCE FIREPLACE RELOCATION SHOWN ON THE APPROVE PLANS,
3. A SINGLE NONBEARING WALL RELOCATION WHEN NOT CREATING AN ADDITIONAL ROOM, AND
4. INTERIOR NON-STRUCTURAL WALL FINISHES;

SHALL CAUSE PLANS APPROVAL AND CONSTRUCTION TO BE SUSPENDED, A NEW PLAN CHECK (FOR THE NEW PLAN CHANGES) WILL BE SUBMITTED FOR REVIEW AND APPROVAL THROUGH THE COMMON PLAN CHECK PROCESS.


CALGREEN NOTES:

PER CALIFORNIA CIVIL CODE ARTICLE 1101.4 AND CALGREEN SECTION 301.1, FOR ALL BUILDING ALTERATIONS OR IMPROVEMENTS TO A SINGLE FAMILY RESIDENTIAL PROPERTY, EXISTING PLUMBING FIXTURES IN THE ENTIRE HOUSE THAT DO NOT MEET COMPLIANT FLOW RATES WILL NEED TO BE UPGRADED. WATER CLOSETS WITH A FLOW RATE IN EXCESS OF 1.6 gpf WILL NEED TO BE REPLACED WITH WATER CLOSETS WITH A MAXIMUM FLOW RATE OF 1.28 gpf. SHOWER HEADS WITH A FLOW RATE GREATER THAN 2.5 gpm WILL NEED TO BE REPLACED WITH A MAXIMUM 2.0 gpm SHOWER HEAD. LAVATORY AND KITCHEN FAUCETS WITH A FLOW RATE GREATER THAN 2.2 gpm WILL NEED TO BE REPLACED WITH A FAUCET WITH A MAXIMUM FLOW RATE OF 1.5 gpm (OR 1.8 gpm FOR KITCHEN FAUCETS).

VICINITY MAP:

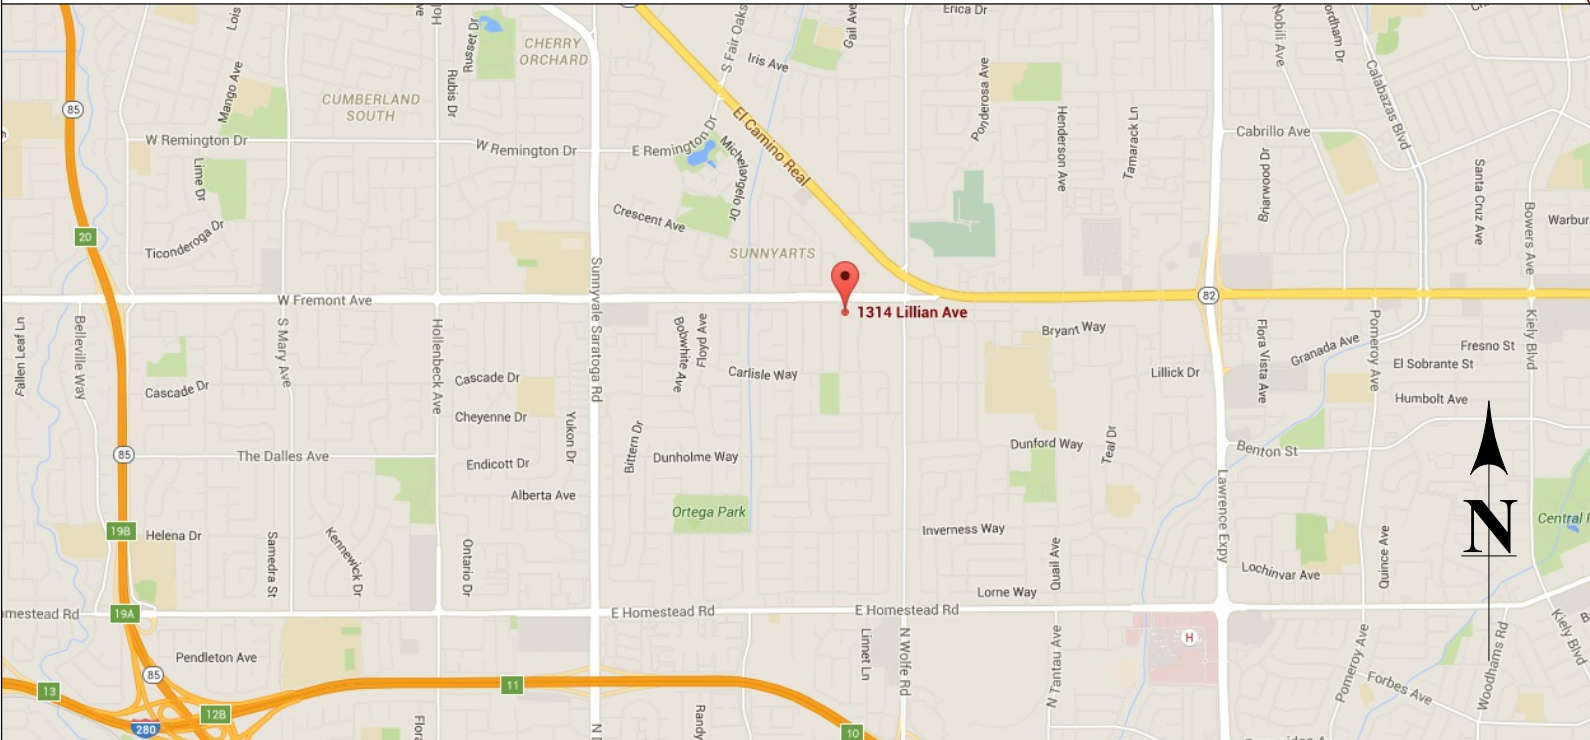

APN MAP:

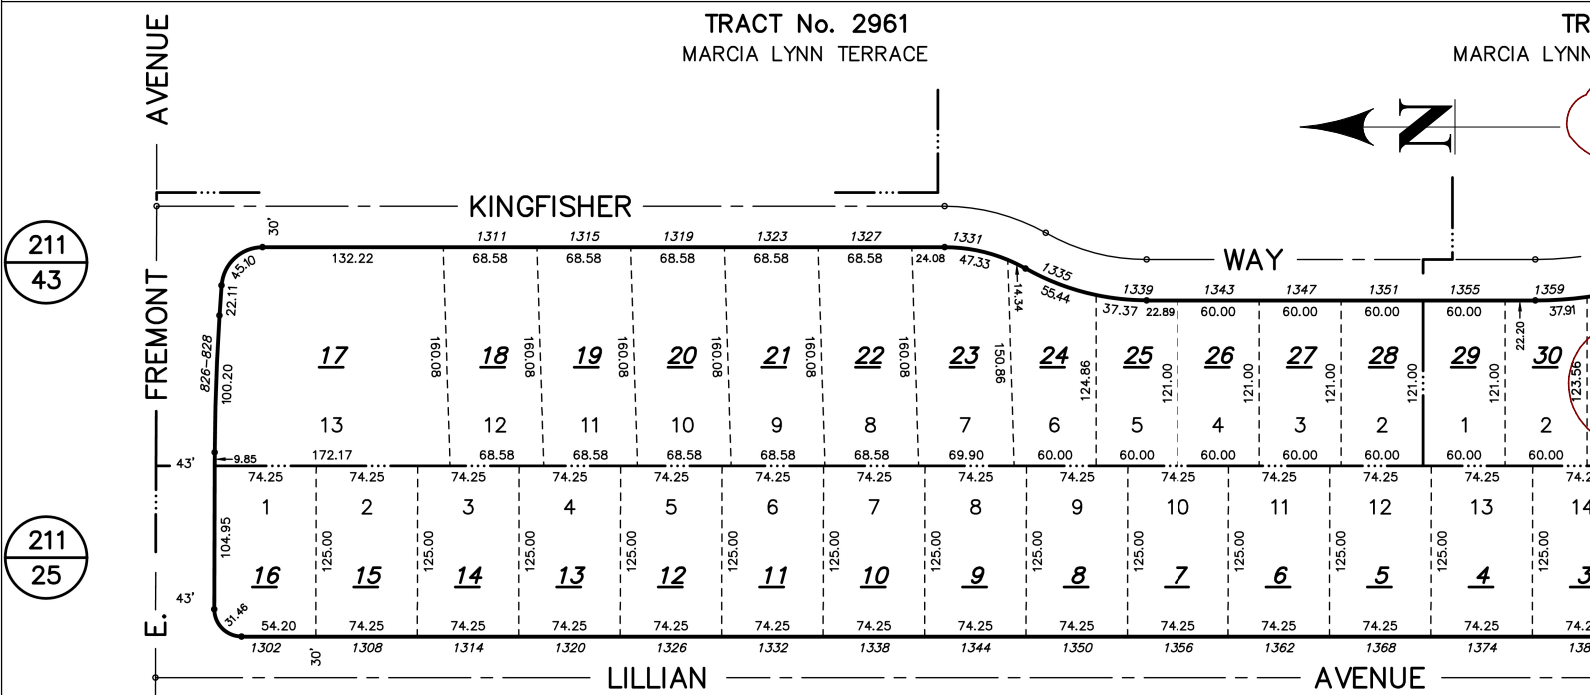

PROJECT DATA:

LOT AREA: 9,281 Sq.Ft
BUILDING AREA: 3,469 Sq.Ft
COVERAGE TOTAL: 31.22 %

EXISTING PROJECT DATA :

(E) FIRST FLOOR: 1,475 Sq.Ft
(E) SECOND FLOOR: 537 Sq.Ft
(E) 2F BALCONY: 34 Sq. Ft.
(E) GARAGE AREA: 965 Sq.Ft
(E) PORCH: 65 Sq.Ft
(E) SUNROOM: 393 Sq.Ft
(E) TOTAL: 3,469 Sq.Ft
(E) COVERAGE: 2,898/9,281 =31.22 %
(E) FAR: 3,370/9,281 =36.31 %
(E) RATIO SECOND TO FIRST FLOOR:
537/1475 = 36%

PROPOSED DEMO DATA :

FIRST FLOOR: 61 Sq.Ft
SUNROOM: 60 Sq.Ft
SECOND FLOOR: 100 Sq.Ft
2F BALCONY: 34 Sq.Ft
TOTAL: 245 Sq.Ft

PROPOSED ADDITION DATA :

FIRST FLOOR: 187 Sq.Ft
SECOND FLOOR: 536 Sq.Ft
2F BALCONY: 85 Sq.Ft
PORCH: 5 Sq.Ft
TOTAL: 813 Sq.Ft

(E) SUNROOM TO BE LIVING AREA: 333 Sq.Ft

PROPOSED PROJECT DATA :

(N) FIRST FLOOR: 1,934 Sq.Ft
(N) SECOND FLOOR: 973 Sq.Ft
(N) 2F BALCONY: 85 Sq.Ft
(E) GARAGE AREA: 965 Sq.Ft
(N) PORCH AREA: 70 Sq.Ft
(N) TOTAL: 4,027 Sq.Ft
(N) COVERAGE: 2969/9281 = 31.99 %
(N) FAR: 3872/9281 = 41.71 %
(N) RATIO SECOND TO FIRST FLOOR:
973/1475 = 50%

PROJECT INFORMATION:

PROJECT DESCRIPTION:

1. CONVERT 393 Sq.Ft OF SUNROOM INTO LIVING SPACE, ADD 187 Sq.Ft. OF LIVING AREA IN FIRST FLOOR AND REDUCE PORCH BY 10 Sq.Ft, AND ADD 552 Sq.Ft OF LIVING AREA IN SECOND FLOOR.
2. REMODEL (E) ENTRY AND PORCH.
3. RELOCATE (E) STAIRS, MODIFY BEDROOM 3 AND ADD A BATHROOM.
4. CONVERT BEDROOM 4 INTO OFFICE AREA.
5. REMODEL (E) LAUNDRY AREA AND UTILITY ROOM.
6. REMODEL (E) LIVING ROOM AND ADD A DINING & PRAYER ROOM.
7. REMODEL (E) KITCHEN, CABINETRY AND APPLIANCES.
8. ADD 2 BEDROOMS AND 1 BATHROOM ON SECOND FLOOR.
9. REMODEL (E) MASTER BEDROOM AND MASTER BATHROOM.
10. RELOCATE (E) BALCONY ON SECOND FLOOR
- 11) REDUCE THE EXISTING FRONT PAVING AREA TO ACHIEVE 50% OF PAVING & 50 % LANDSCAPED AREA.

APN: 309-09-14

CONSTRUCTION TYPE: V-B

ZONING: R0 RESIDENTIAL LOW DENSITY

STORIES: 2 - RESIDENTIAL

BUILDING CODES: 2013 CALIFORNIA BUILDING CODE
2013 CALIFORNIA RESIDENTIAL CODE
2013 CALIFORNIA ELECTRICAL CODE
2013 CALIFORNIA MECHANICAL CODE
2013 CALIFORNIA PLUMBING CODE
2013 CALIFORNIA ENERGY
ALL APPLICABLE LOCAL, COUNTY, STATE AND FEDERAL CODES, LAWS & REGULATIONS.

ENGINEER: JF CONSULTING DESIGN & ENGINEERING
3001 WINCHESTER BLVD, # 8
CAMPBELL, CA 95118
PHONE: 408-512-8400
EMAIL: JFPLANS@GMAIL.COM

CONTRACTOR:

DRAWING INDEX:

ARCHITECTURAL:

- A-1 COVER SHEET AND PROJECT INFORMATION
- A-2 EXISTING AND PROPOSED SITE - FIRST FLOOR
- A-3 EXISTING AND PROPOSED SETBACK - SECOND FLOOR
- A-4 EXISTING AND PROPOSED 2ND FLOOR PLAN - REFERENCE WITH FIRST FLOOR
- A-5 EXISTING AND PROPOSED FLOOR PLAN - FIRST FLOOR
- A-6 EXISTING AND PROPOSED FLOOR PLAN - SECOND FLOOR/ GARAGE
- A-7 EXISTING AND PROPOSED ELEVATION / NOTES
- A-8 EXISTING AND PROPOSED ELEVATION / NOTES
- A-9 EXISTING AND PROPOSED ELEVATION
- A-10 EXISTING AND PROPOSED ELEVATION & CROSS SECTIONS
- A-11 CALGREEN & FLOOR PLAN NOTES
- A-12 SOLAR ACCESS & SHADOW ANALYSIS
- A-13 SOLAR ACCESS & SHADOW ANALYSIS
- A-14 ROOFING PLAN-EXISTING & PROPOSED

STRUCTURAL:

ENERGY:

SHEET TITLE:
SHEET TITLE
PROJECT INFORMATION

PROJECT DESCRIPTION:
ADDITION & REMODELING
1314 Lillian Ave.,
SUNNYVALE, CA 94087

JF CONSULTING
3001 S. Winchester Blvd., #8
Campbell, CA 95008
TEL: 408.512.8400 - Email: JFPLANS@GMAIL

11/17/2016



SHEET:

A- 1



NO.	DESCRIPTION	BY	DATE
1	CORRECTION FROM DESIGN REVIEW 1		10.12.16
2	CORRECTION FROM DESIGN REVIEW 2		11.11.16

SHEET TITLE:
EXISTING & PROPOSED
SITE - FIRST FLOOR


PROJECT DESCRIPTION:
ADDITION & REMODELING
1314 Lillian Ave.,
SUNNYVALE, CA 94087

JF CONSULTING
3001 S. Winchester Blvd., #8
Campbell, CA. 95008
TEL: 408.512.8400 - Email: jfplanners@gmail.com



11/17/2016

SHEET:
A- 2

LEGEND


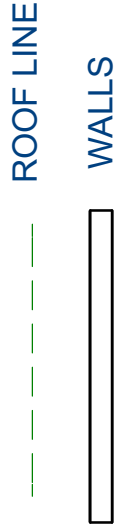


NOTE: NO TREES ARE PROPOSED FOR REMOVAL

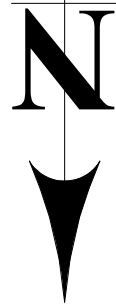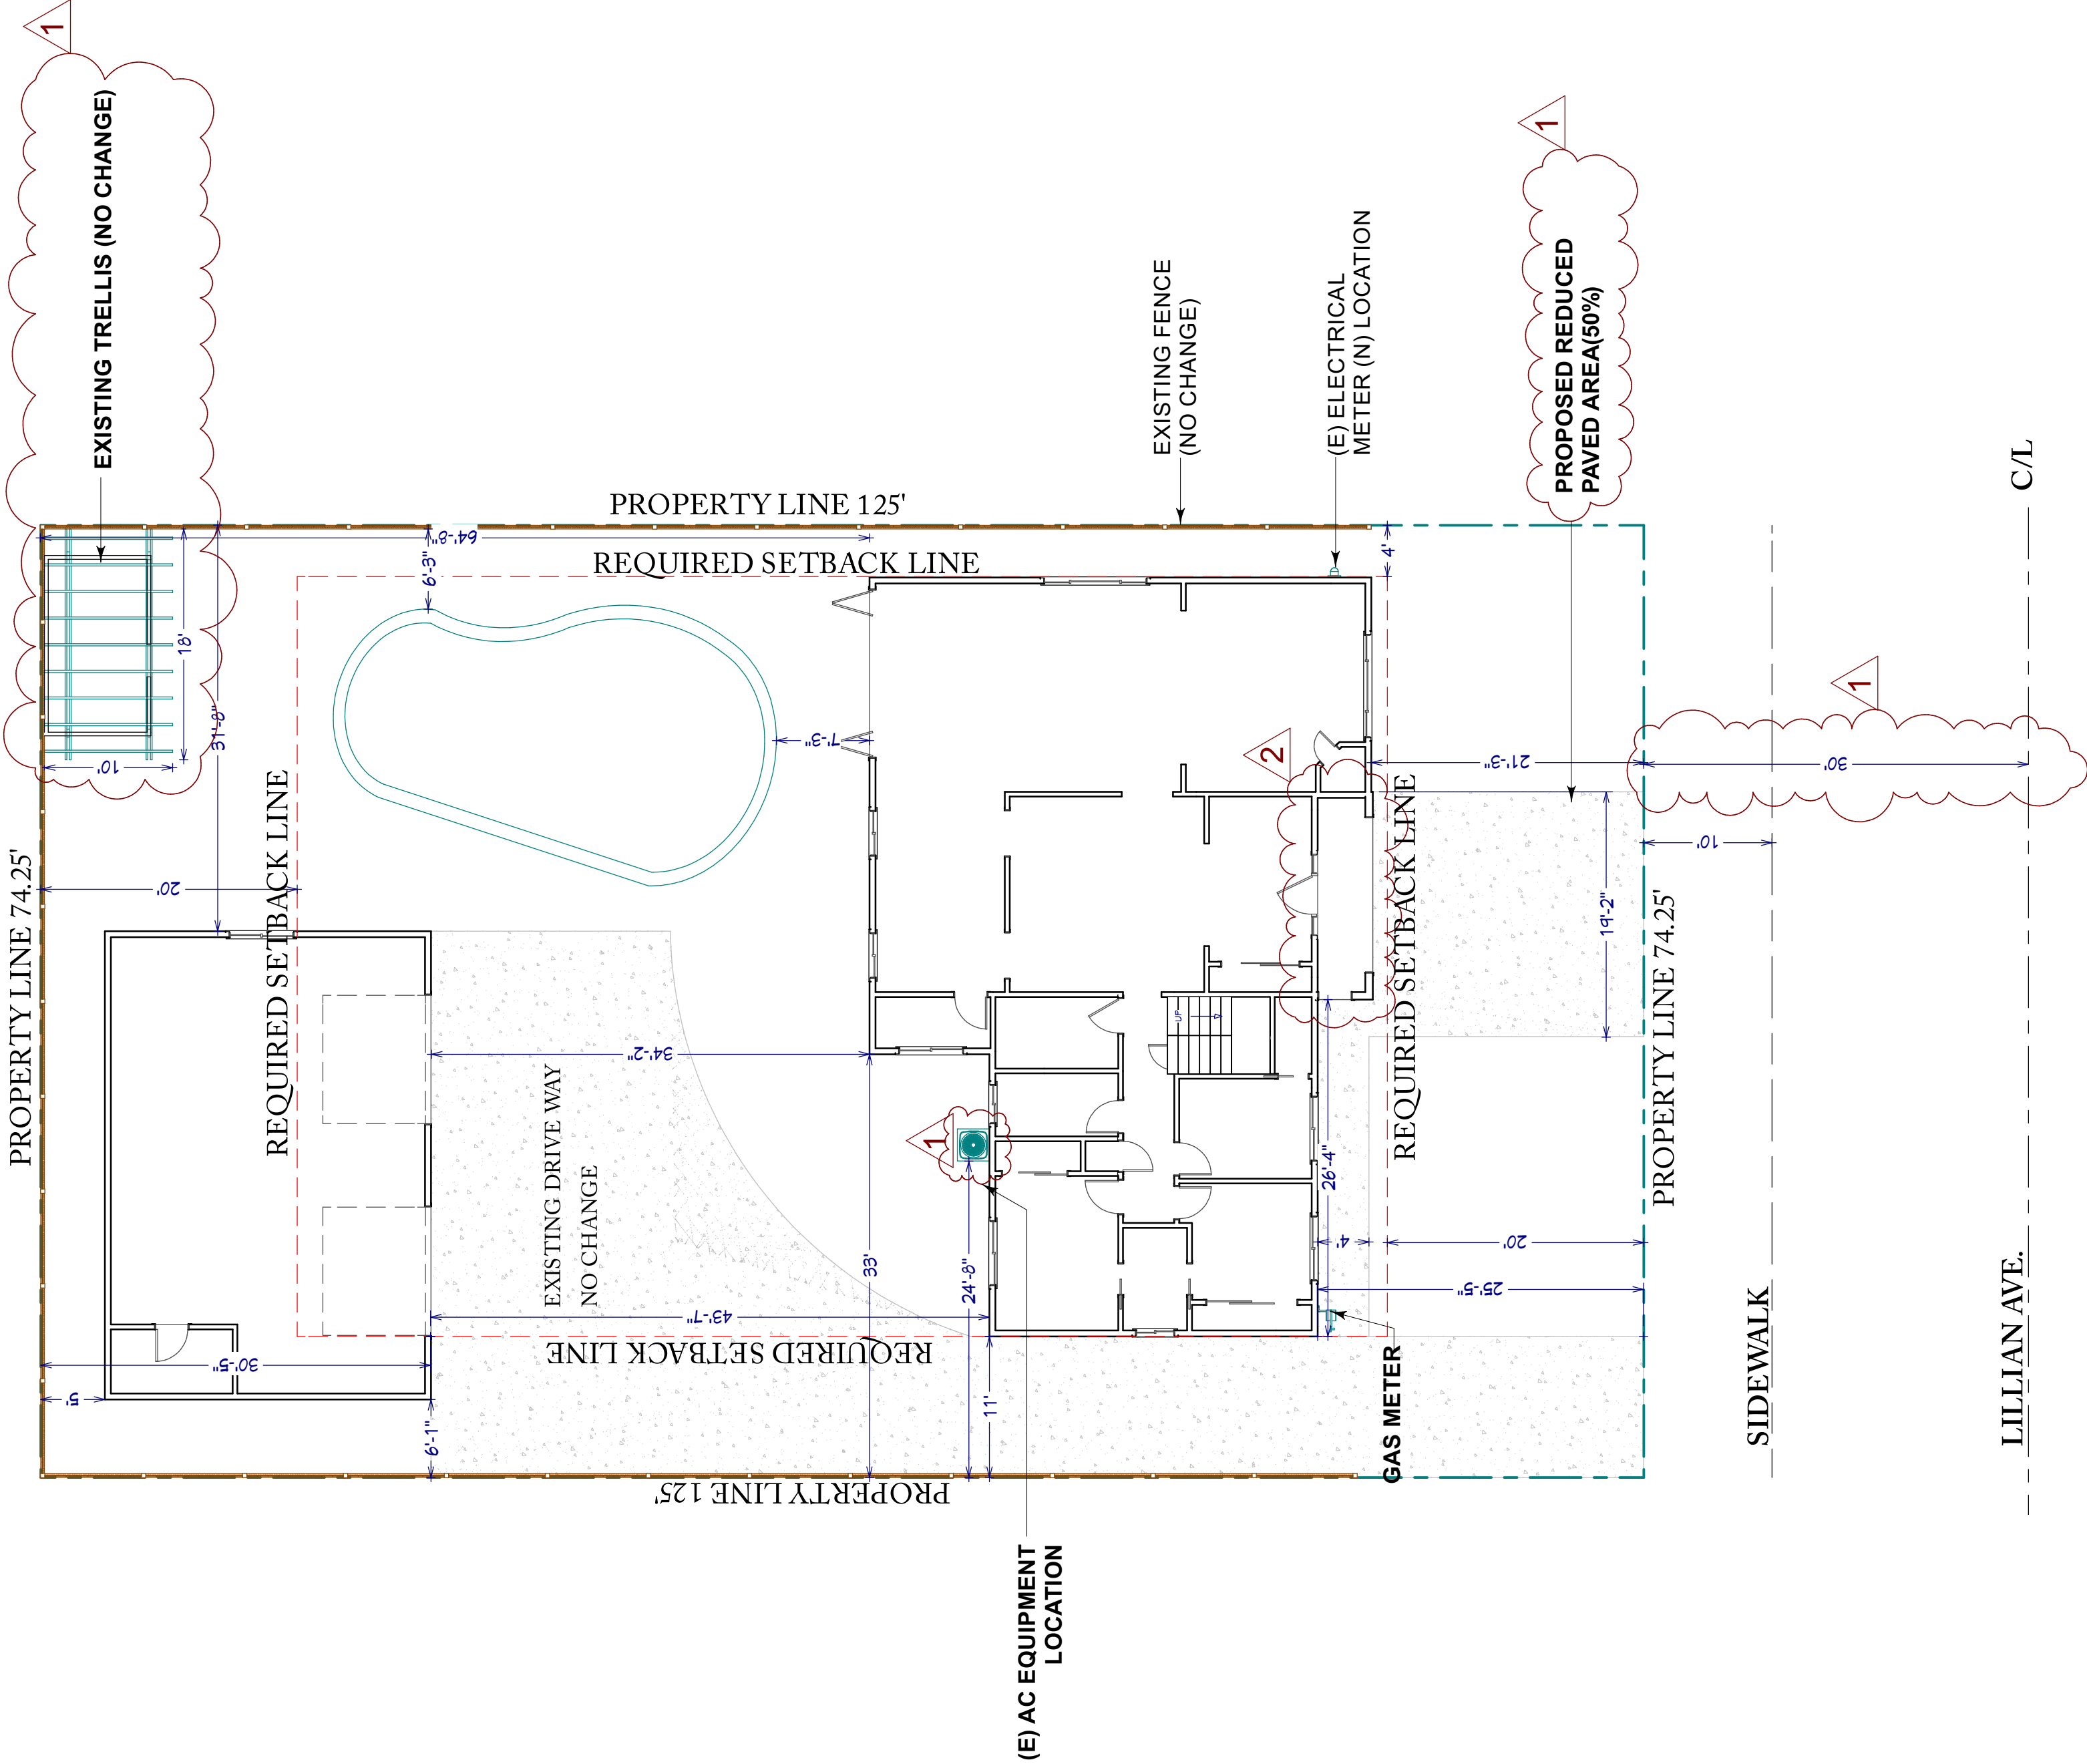

PROPOSED SITE PLAN - FIRST FLOOR
SCALE 1/10"=1'-0"

LEGEND

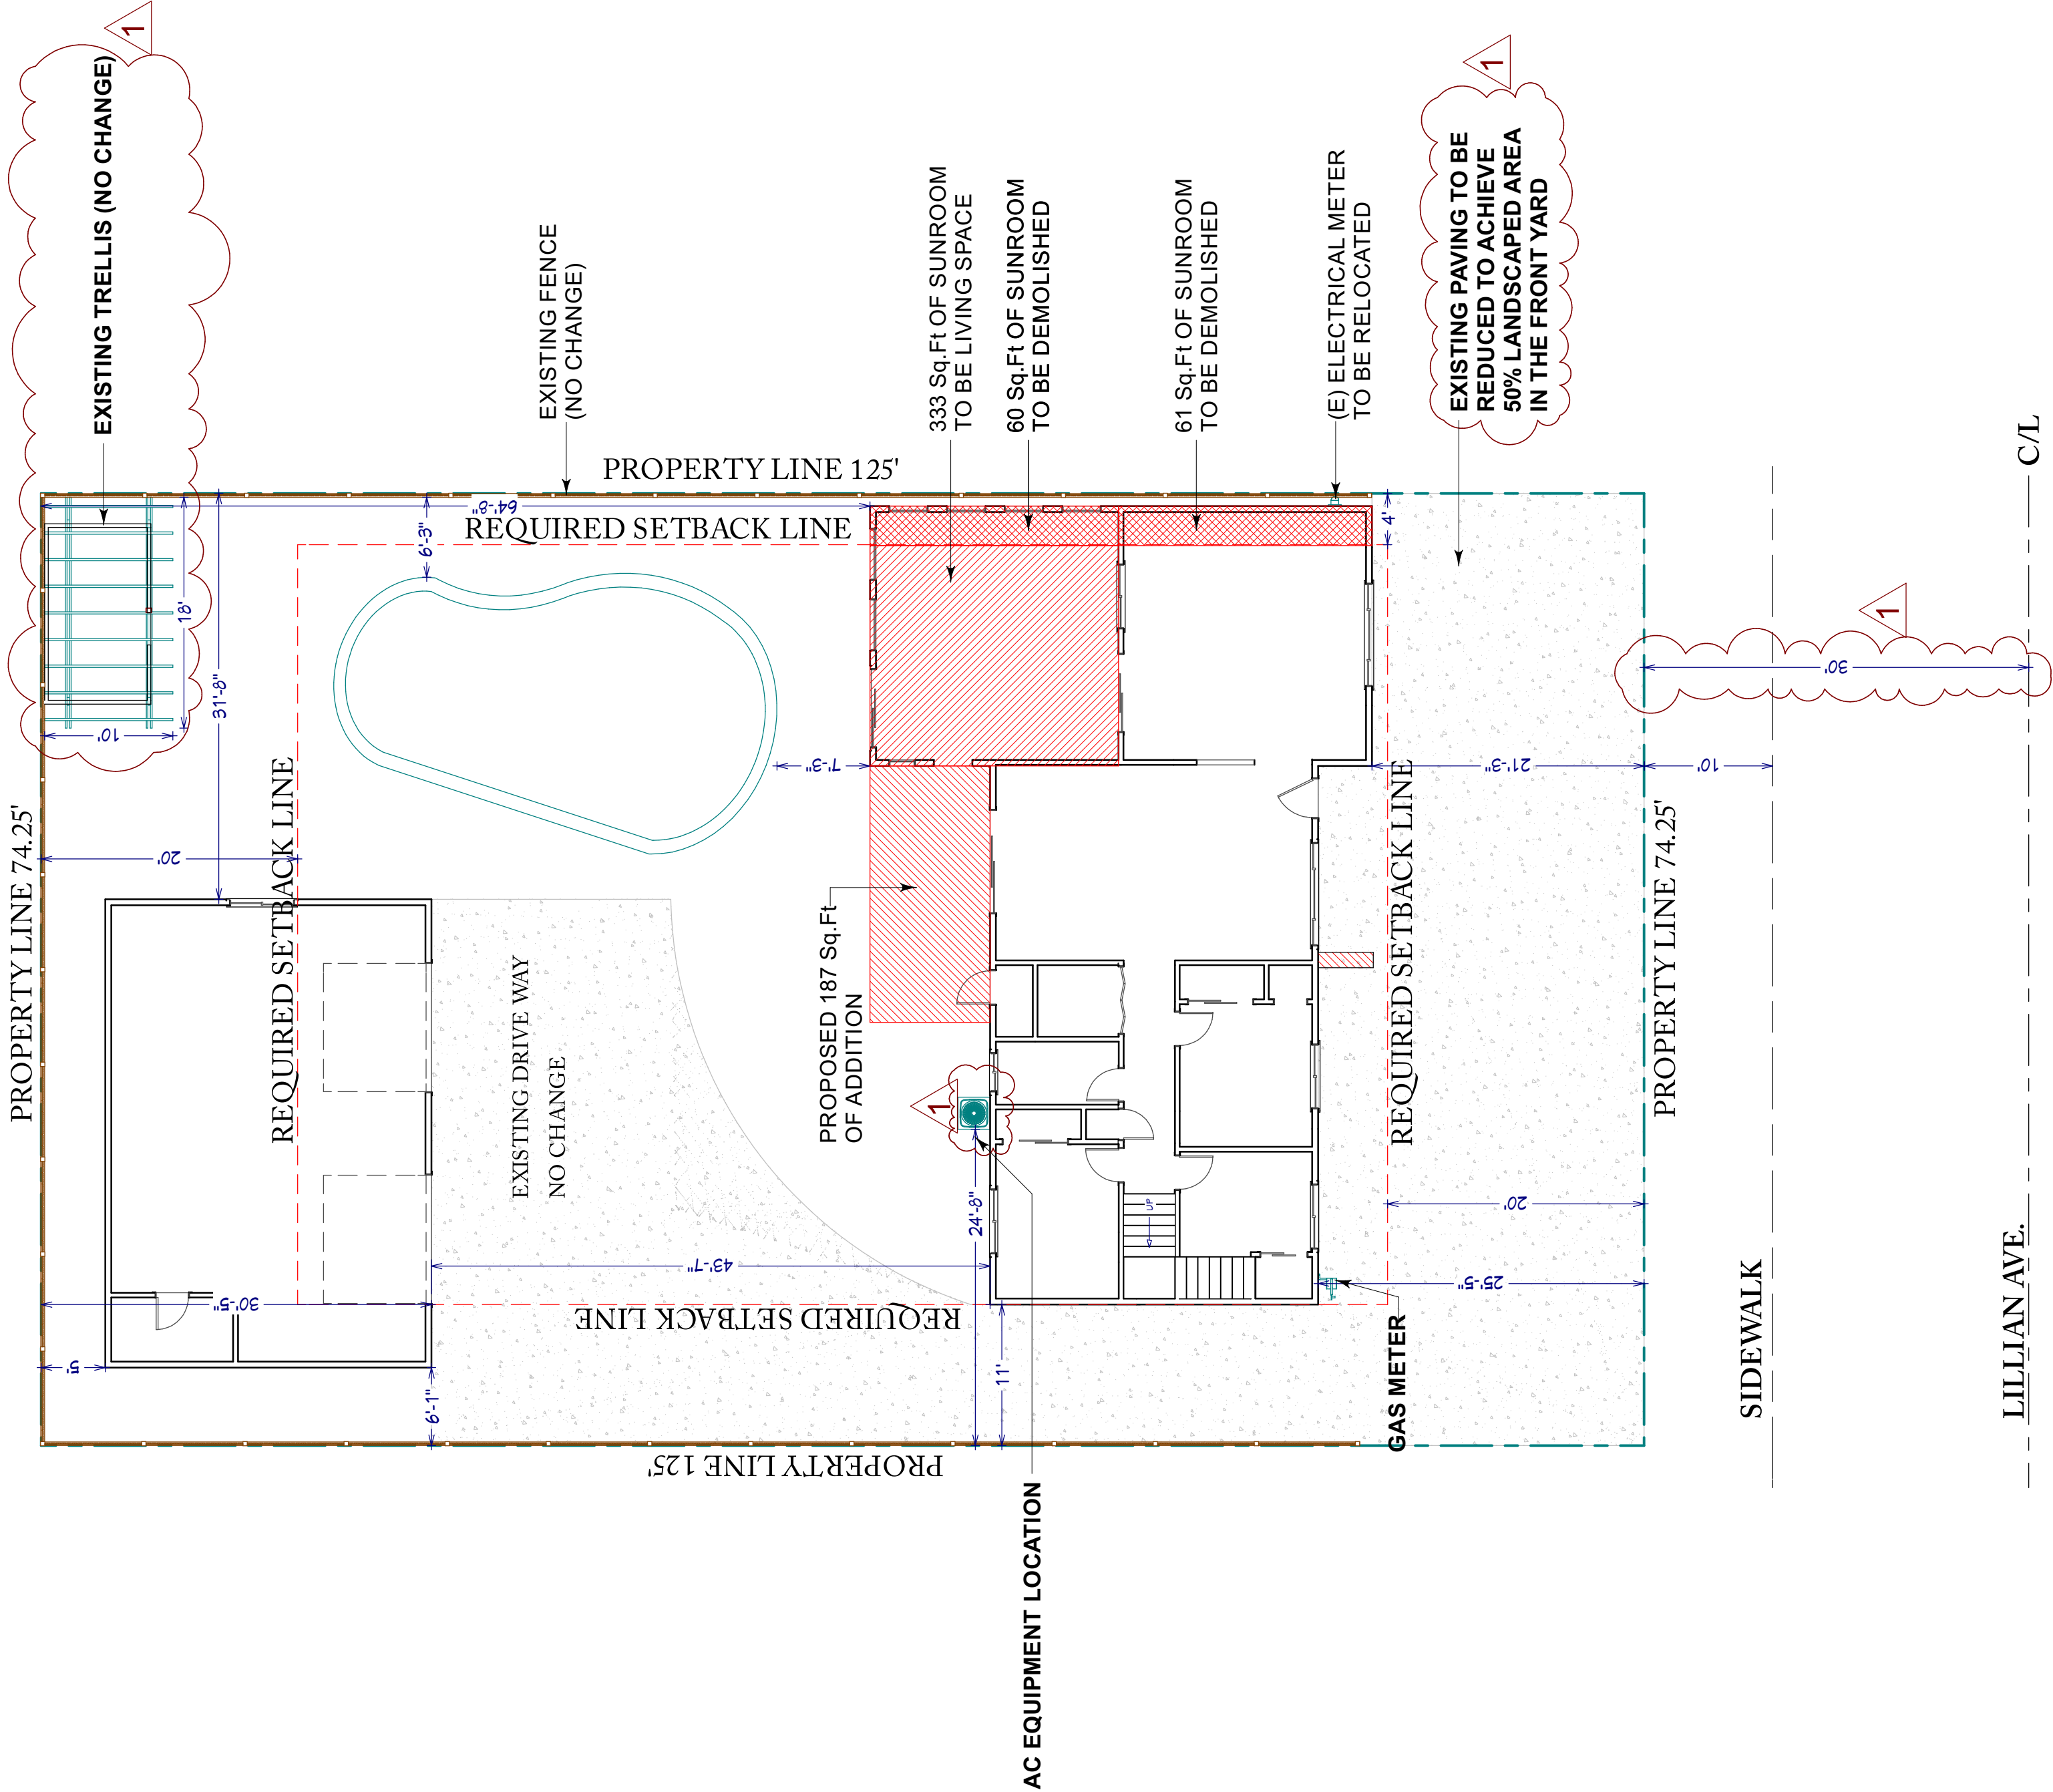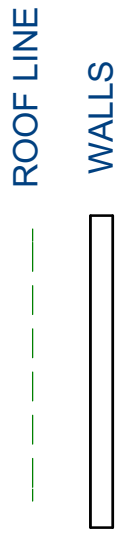

EXISTING SITE PLAN - FIRST FLOOR
SCALE 1/10"=1'-0"

LEGEND

ROOF LINE

WALLS

LEGEND

ROOF LINE

WALLS

NO.	DESCRIPTION	BY	DATE
1	CORRECTION FROM DESIGN REVIEW 1	10.12.16	
2	CORRECTION FROM DESIGN REVIEW 2	11.16.16	

NO.	DESCRIPTION	BY	DATE
1	CORRECTION FROM DESIGN REVIEW 1	10.12.16	
2	CORRECTION FROM DESIGN REVIEW 2	11.16.16	

SHEET TITLE:
EXISTING & PROPOSED
SITE - SECOND FLOOR



PROJECT DESCRIPTION:
ADDITION & REMODELING
1314 Lillian Ave.,
SUNNYVALE, CA 94087

JF CONSULTING
3001 S. Winchester Blvd., #8
Campbell, CA. 95008
TEL: 408.512.8400 - Email: jfplans@gmail

11/17/2016



SHEET:
A- 3

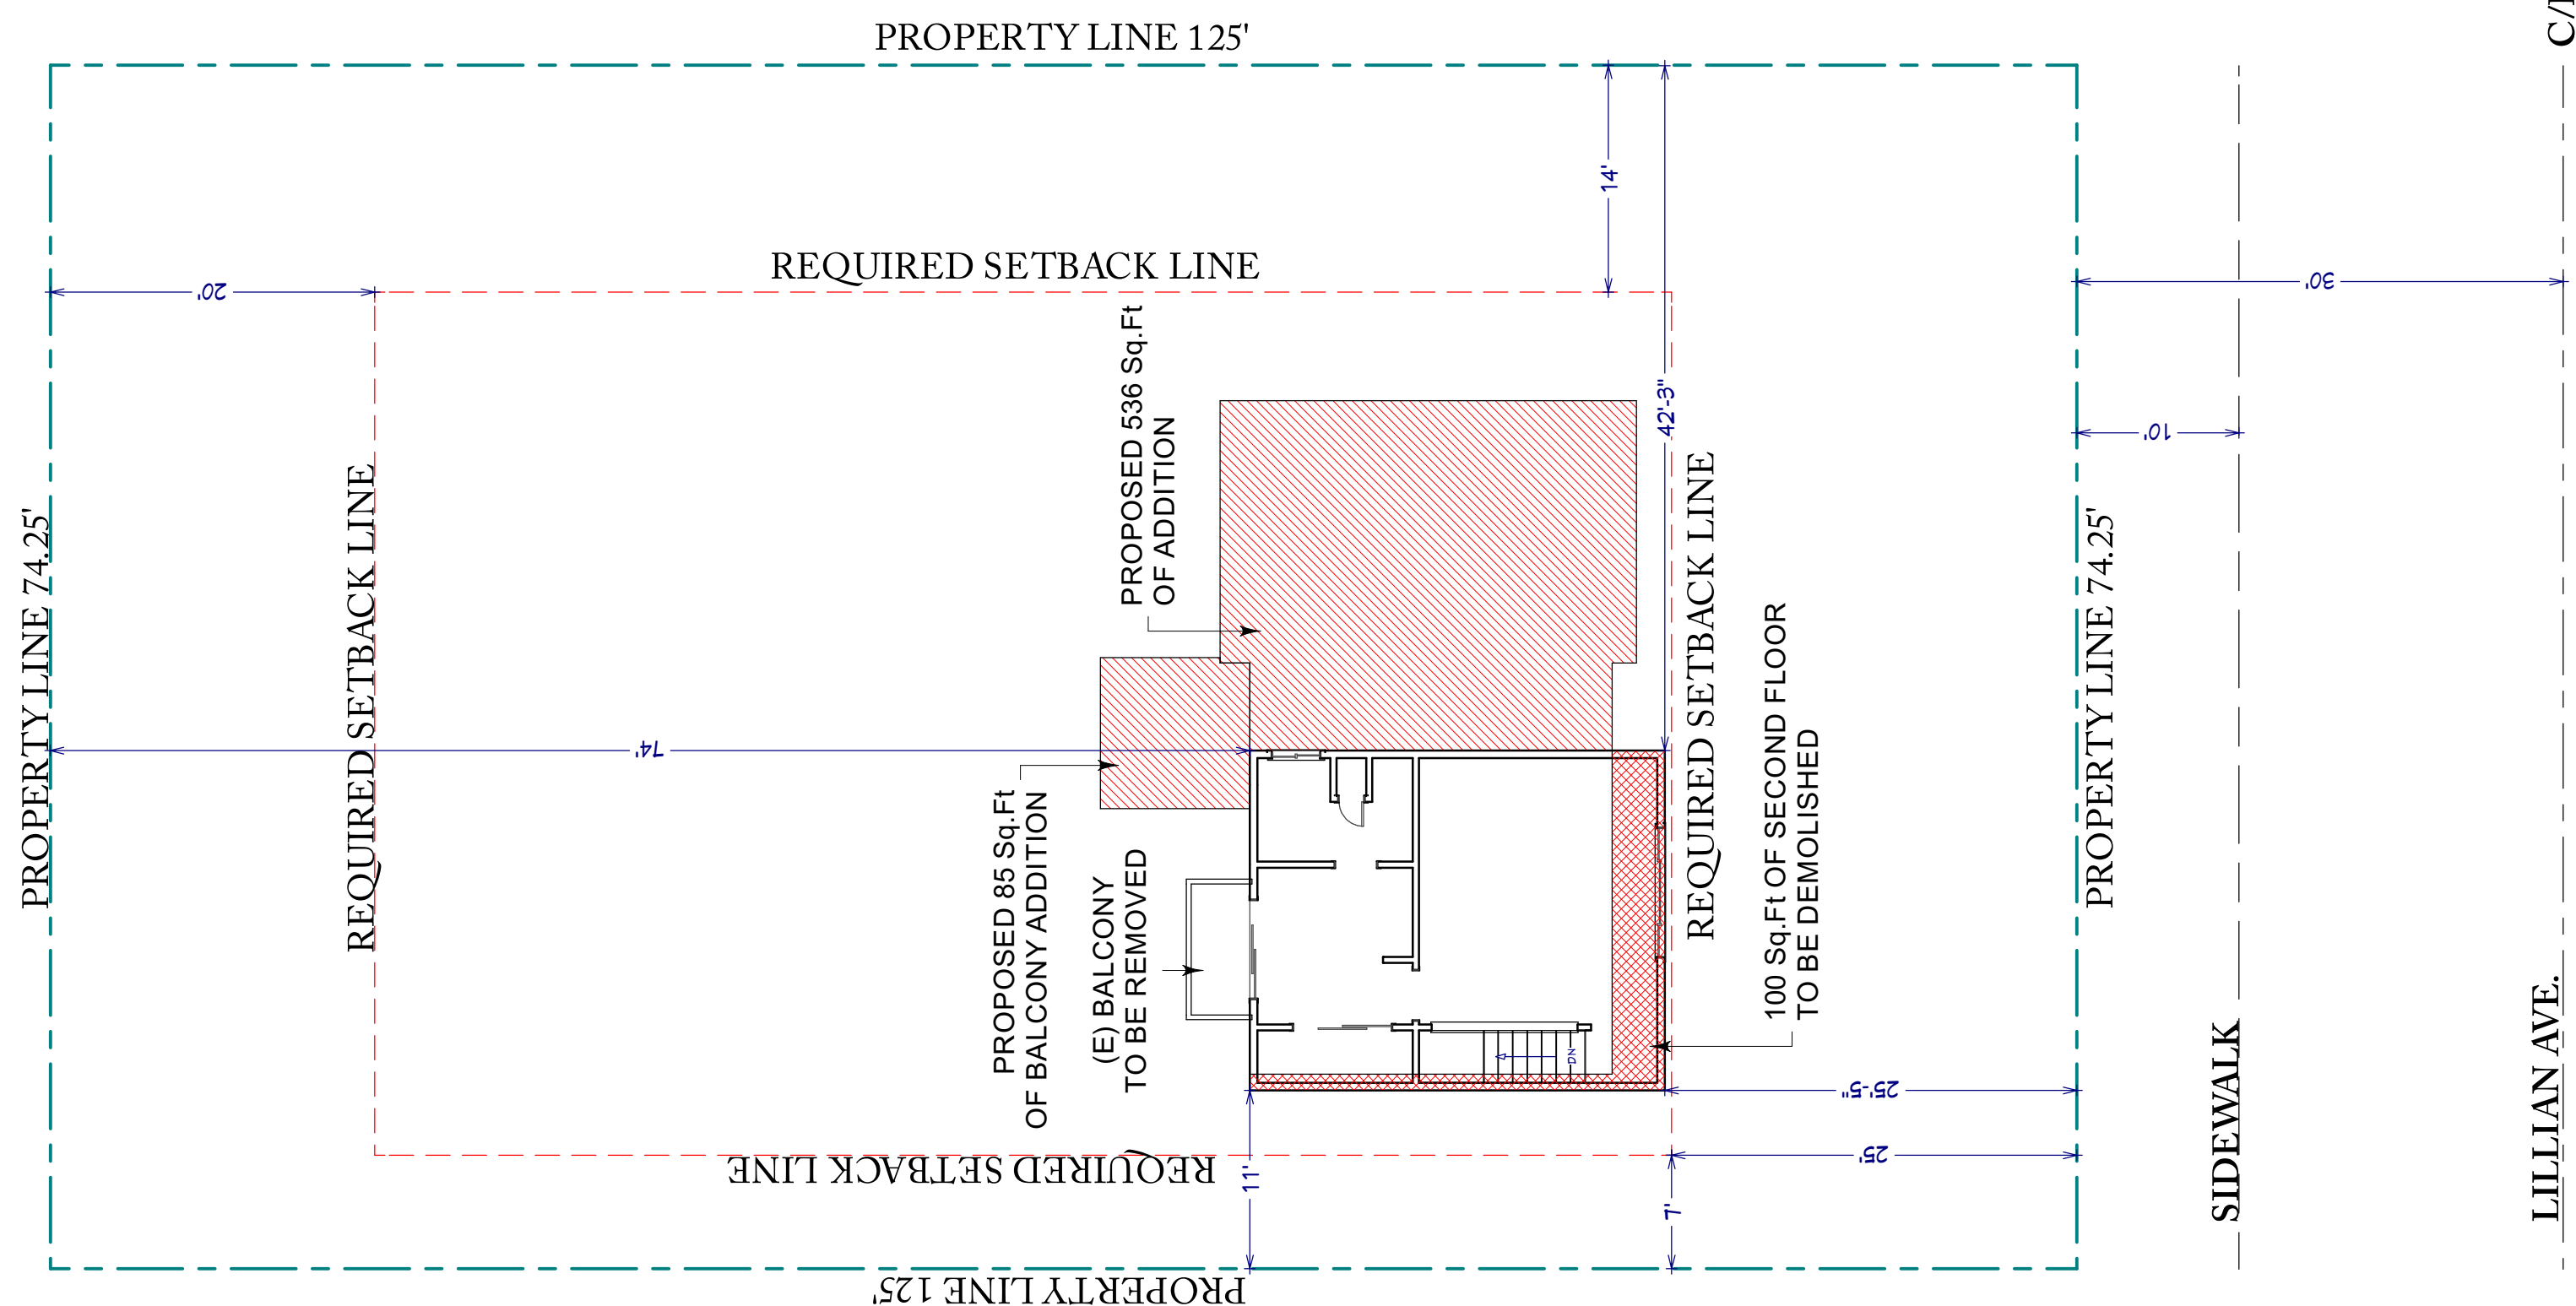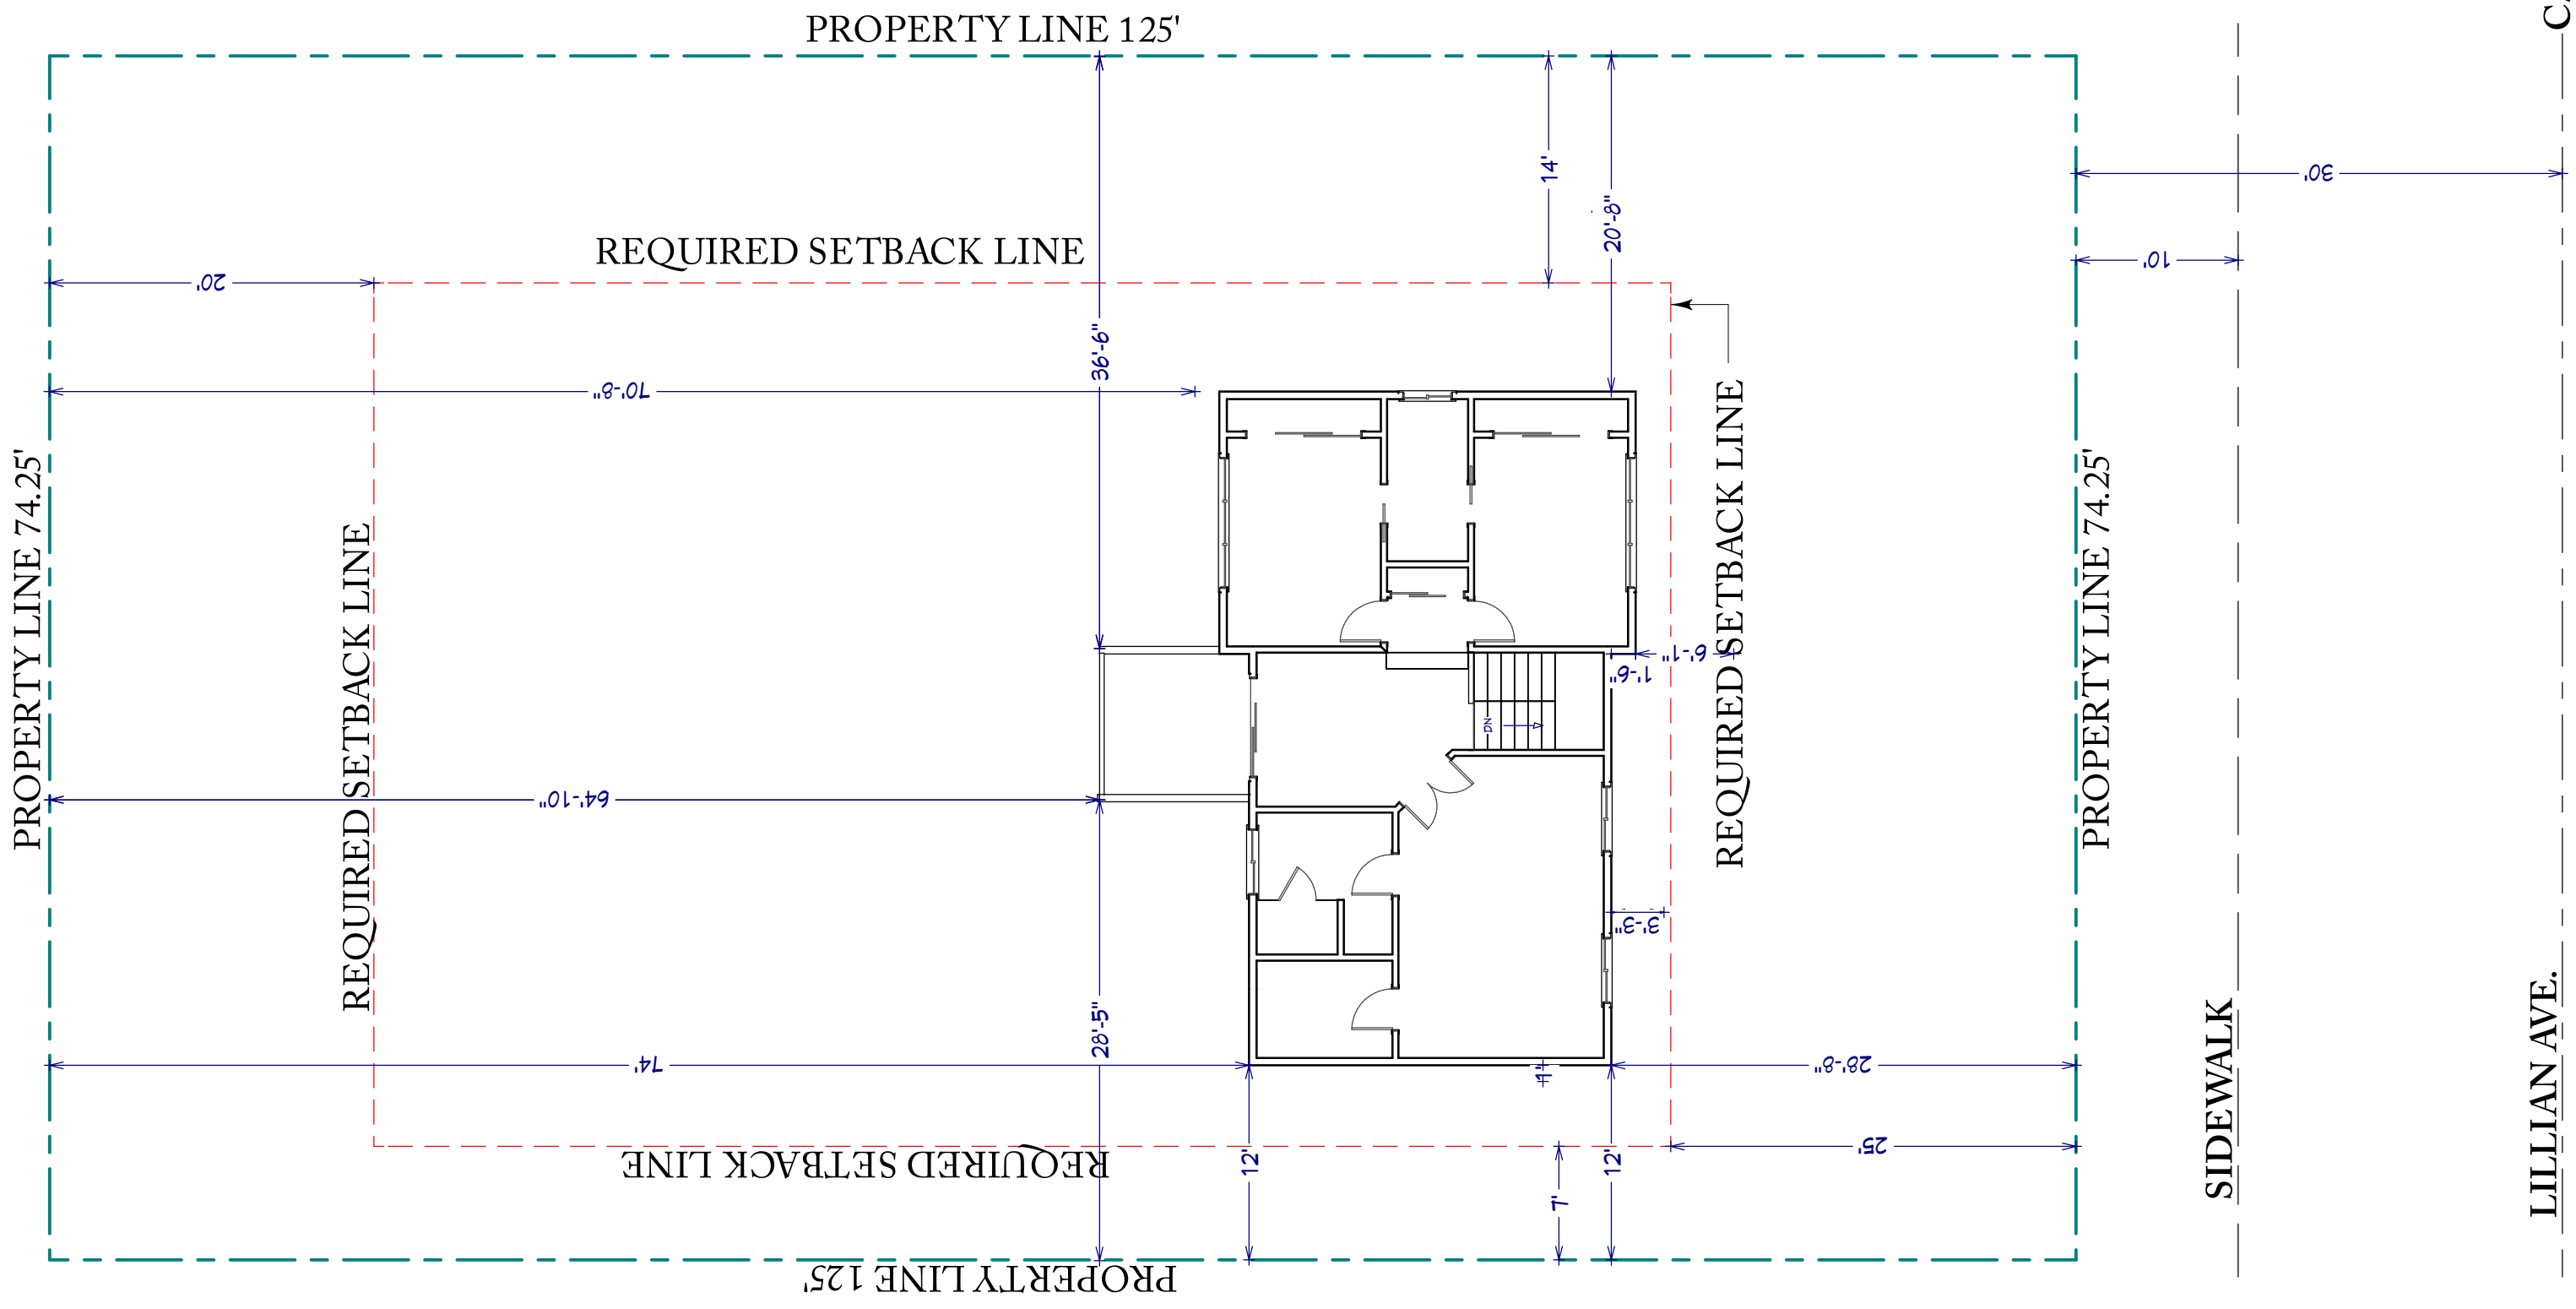

PROPOSED SITE PLAN - SECOND FLOOR
SCALE 1/8"=1'-0"

EXISTING SITE PLAN - SECOND FLOOR
SCALE 1/10"=1'-0"

LEGEND


- EXISTING WALLS
TO REMAIN
- EXISTING WALLS
TO BE REMOVED

NOTE: THE WALLS SHOWN AS "TO REMAIN" SHALL REMAIN IN THE FIELD DURING CONSTRUCTION. IF THESE WALLS ARE REMOVED, TEH PROJECT WILL BE CONSIDERED A NEW HOUSE AND CONSTRUCTION WILL NEED TO BE HALTED UNTIL REVISED PLANS ARE SUBMITTED.


LEGEND

- EXISTING WALLS
TO REMAIN
- NEW WALL
- ROOF LINE
- (N) FIXED SKYLIGHT
VELUX FIX TEMP
ITEM# 317860
MODEL# FS C06 2005 W/
IAPMO-CES REPORT # 199

NOTE: THE WALLS SHOWN AS "TO REMAIN" SHALL REMAIN IN THE FIELD DURING CONSTRUCTION. IF THESE WALLS ARE REMOVED, THE PROJECT WILL BE CONSIDERED A NEW HOUSE AND CONSTRUCTION WILL NEED TO BE HALTED UNTIL REVISED PLANS ARE SUBMITTED.

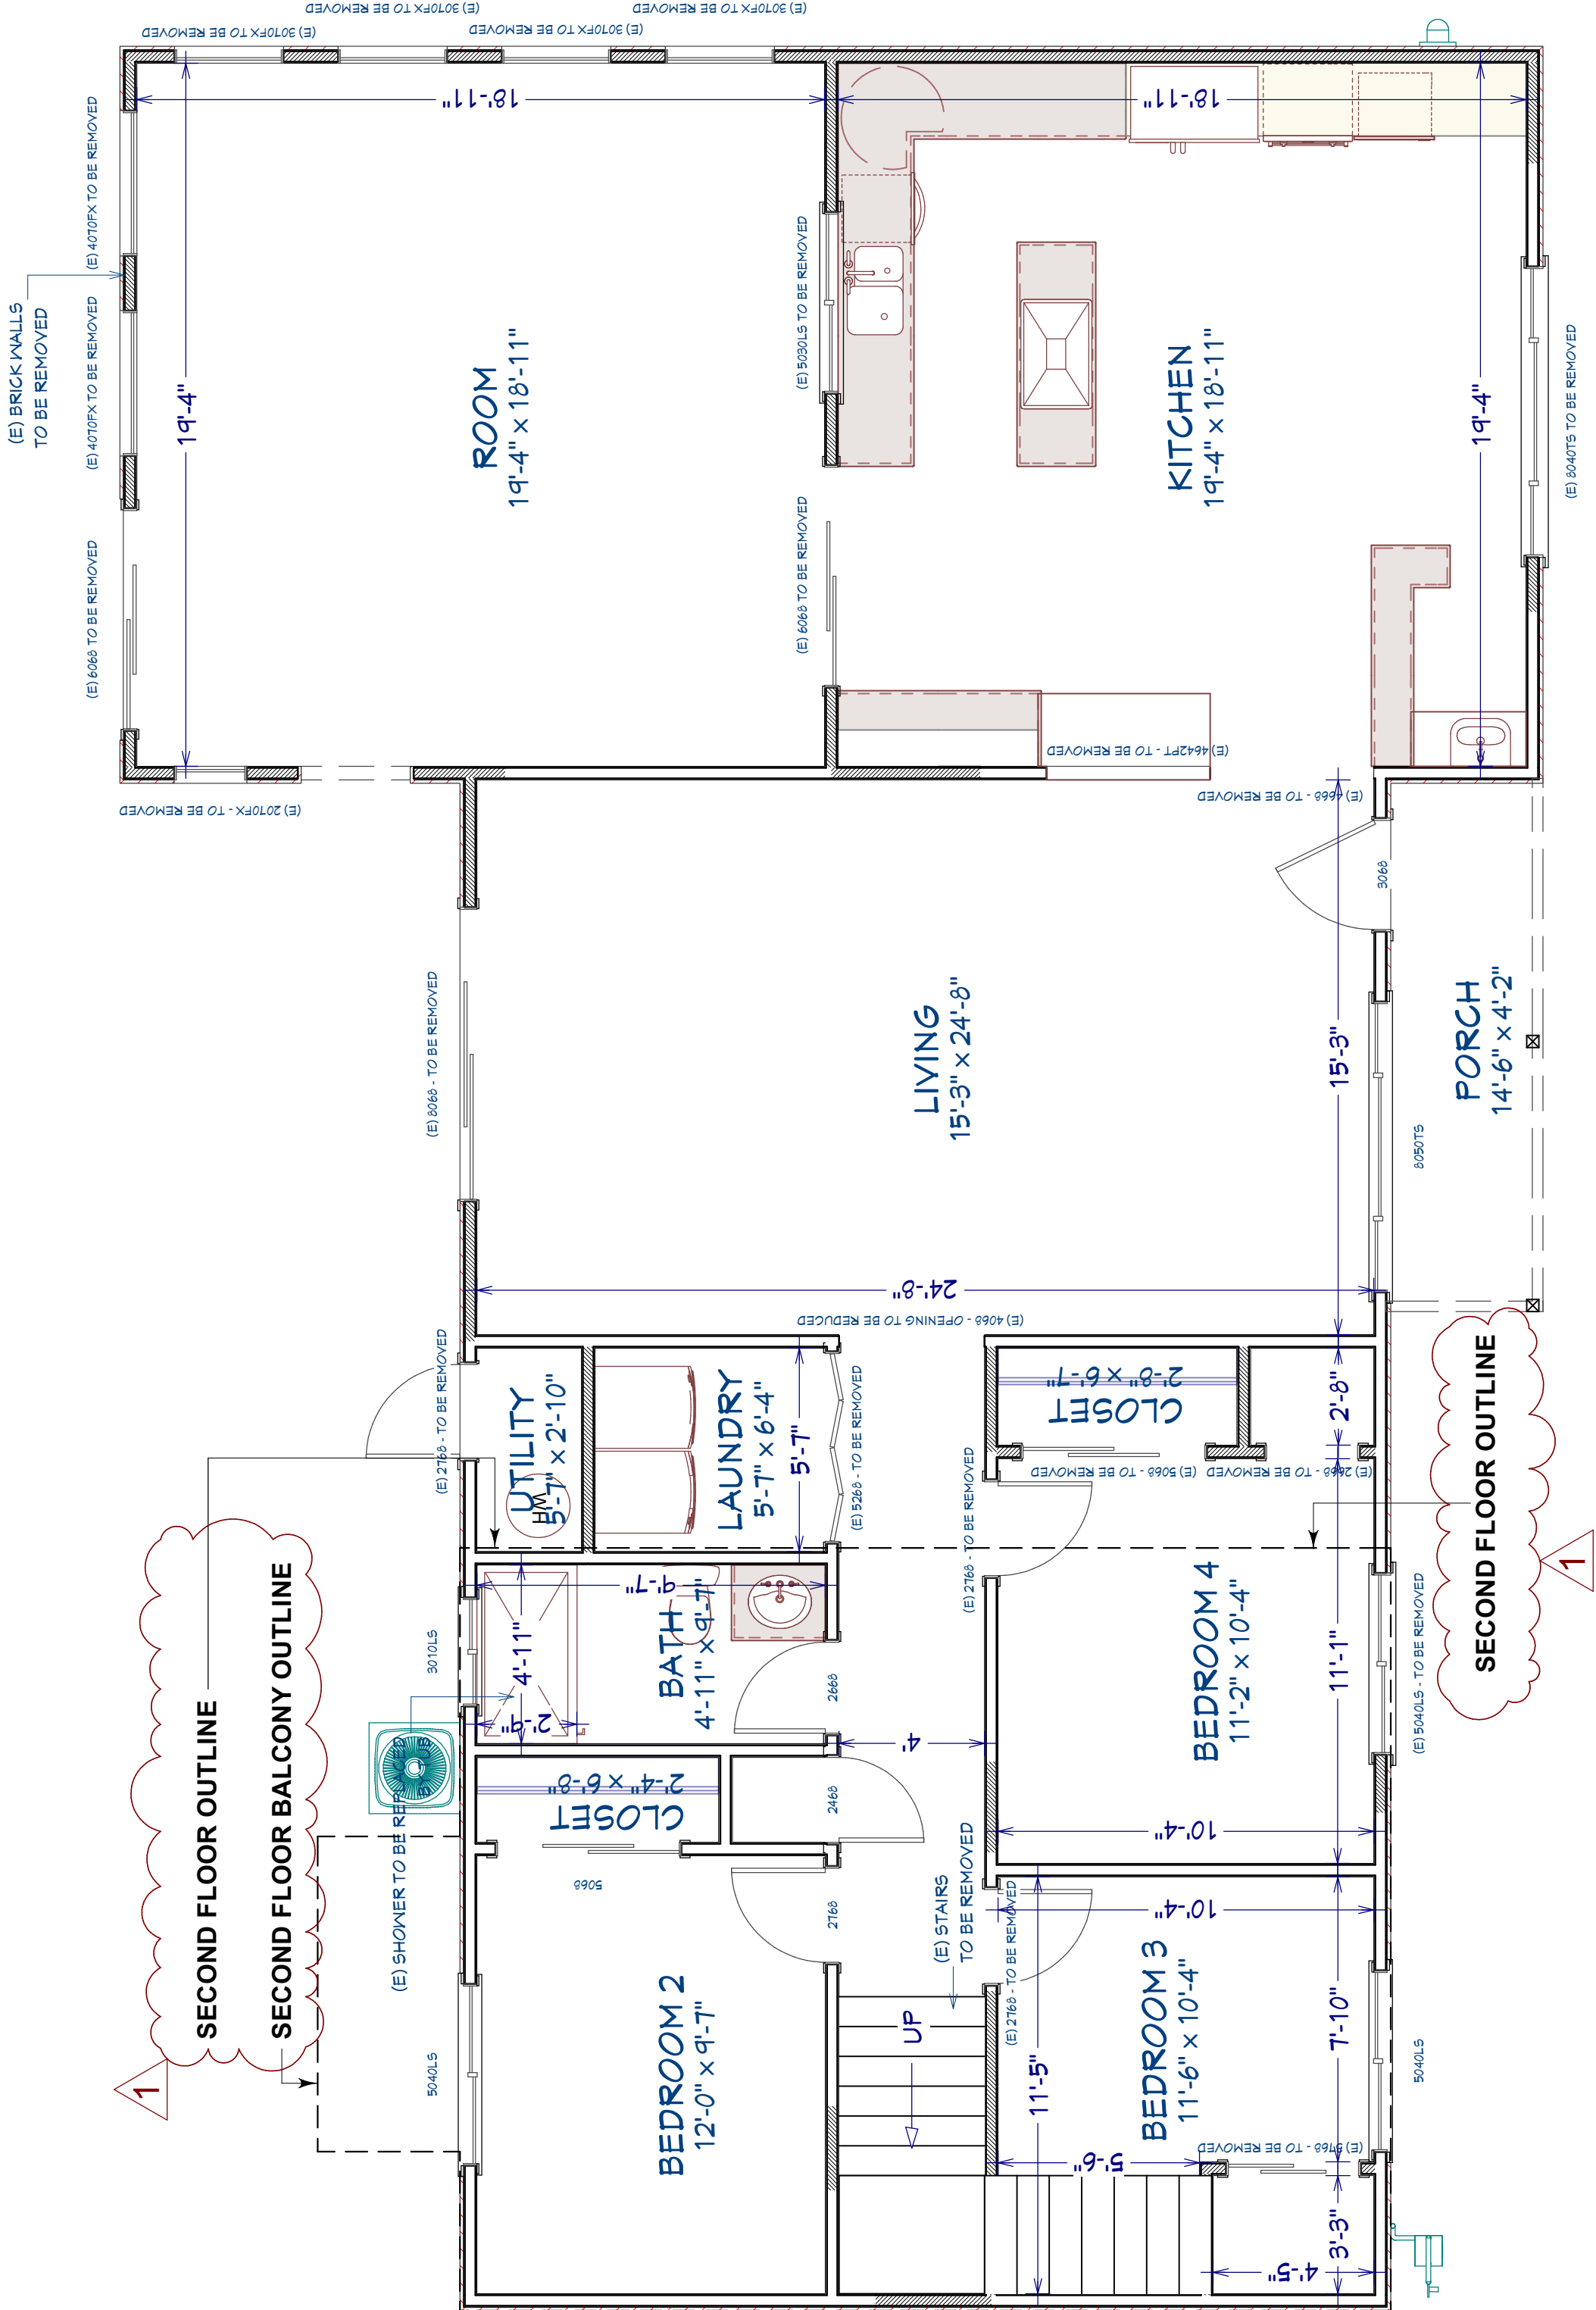

EXISTING FLOOR PLAN - FIRST FLOOR
SCALE 1/4"=1'-0"

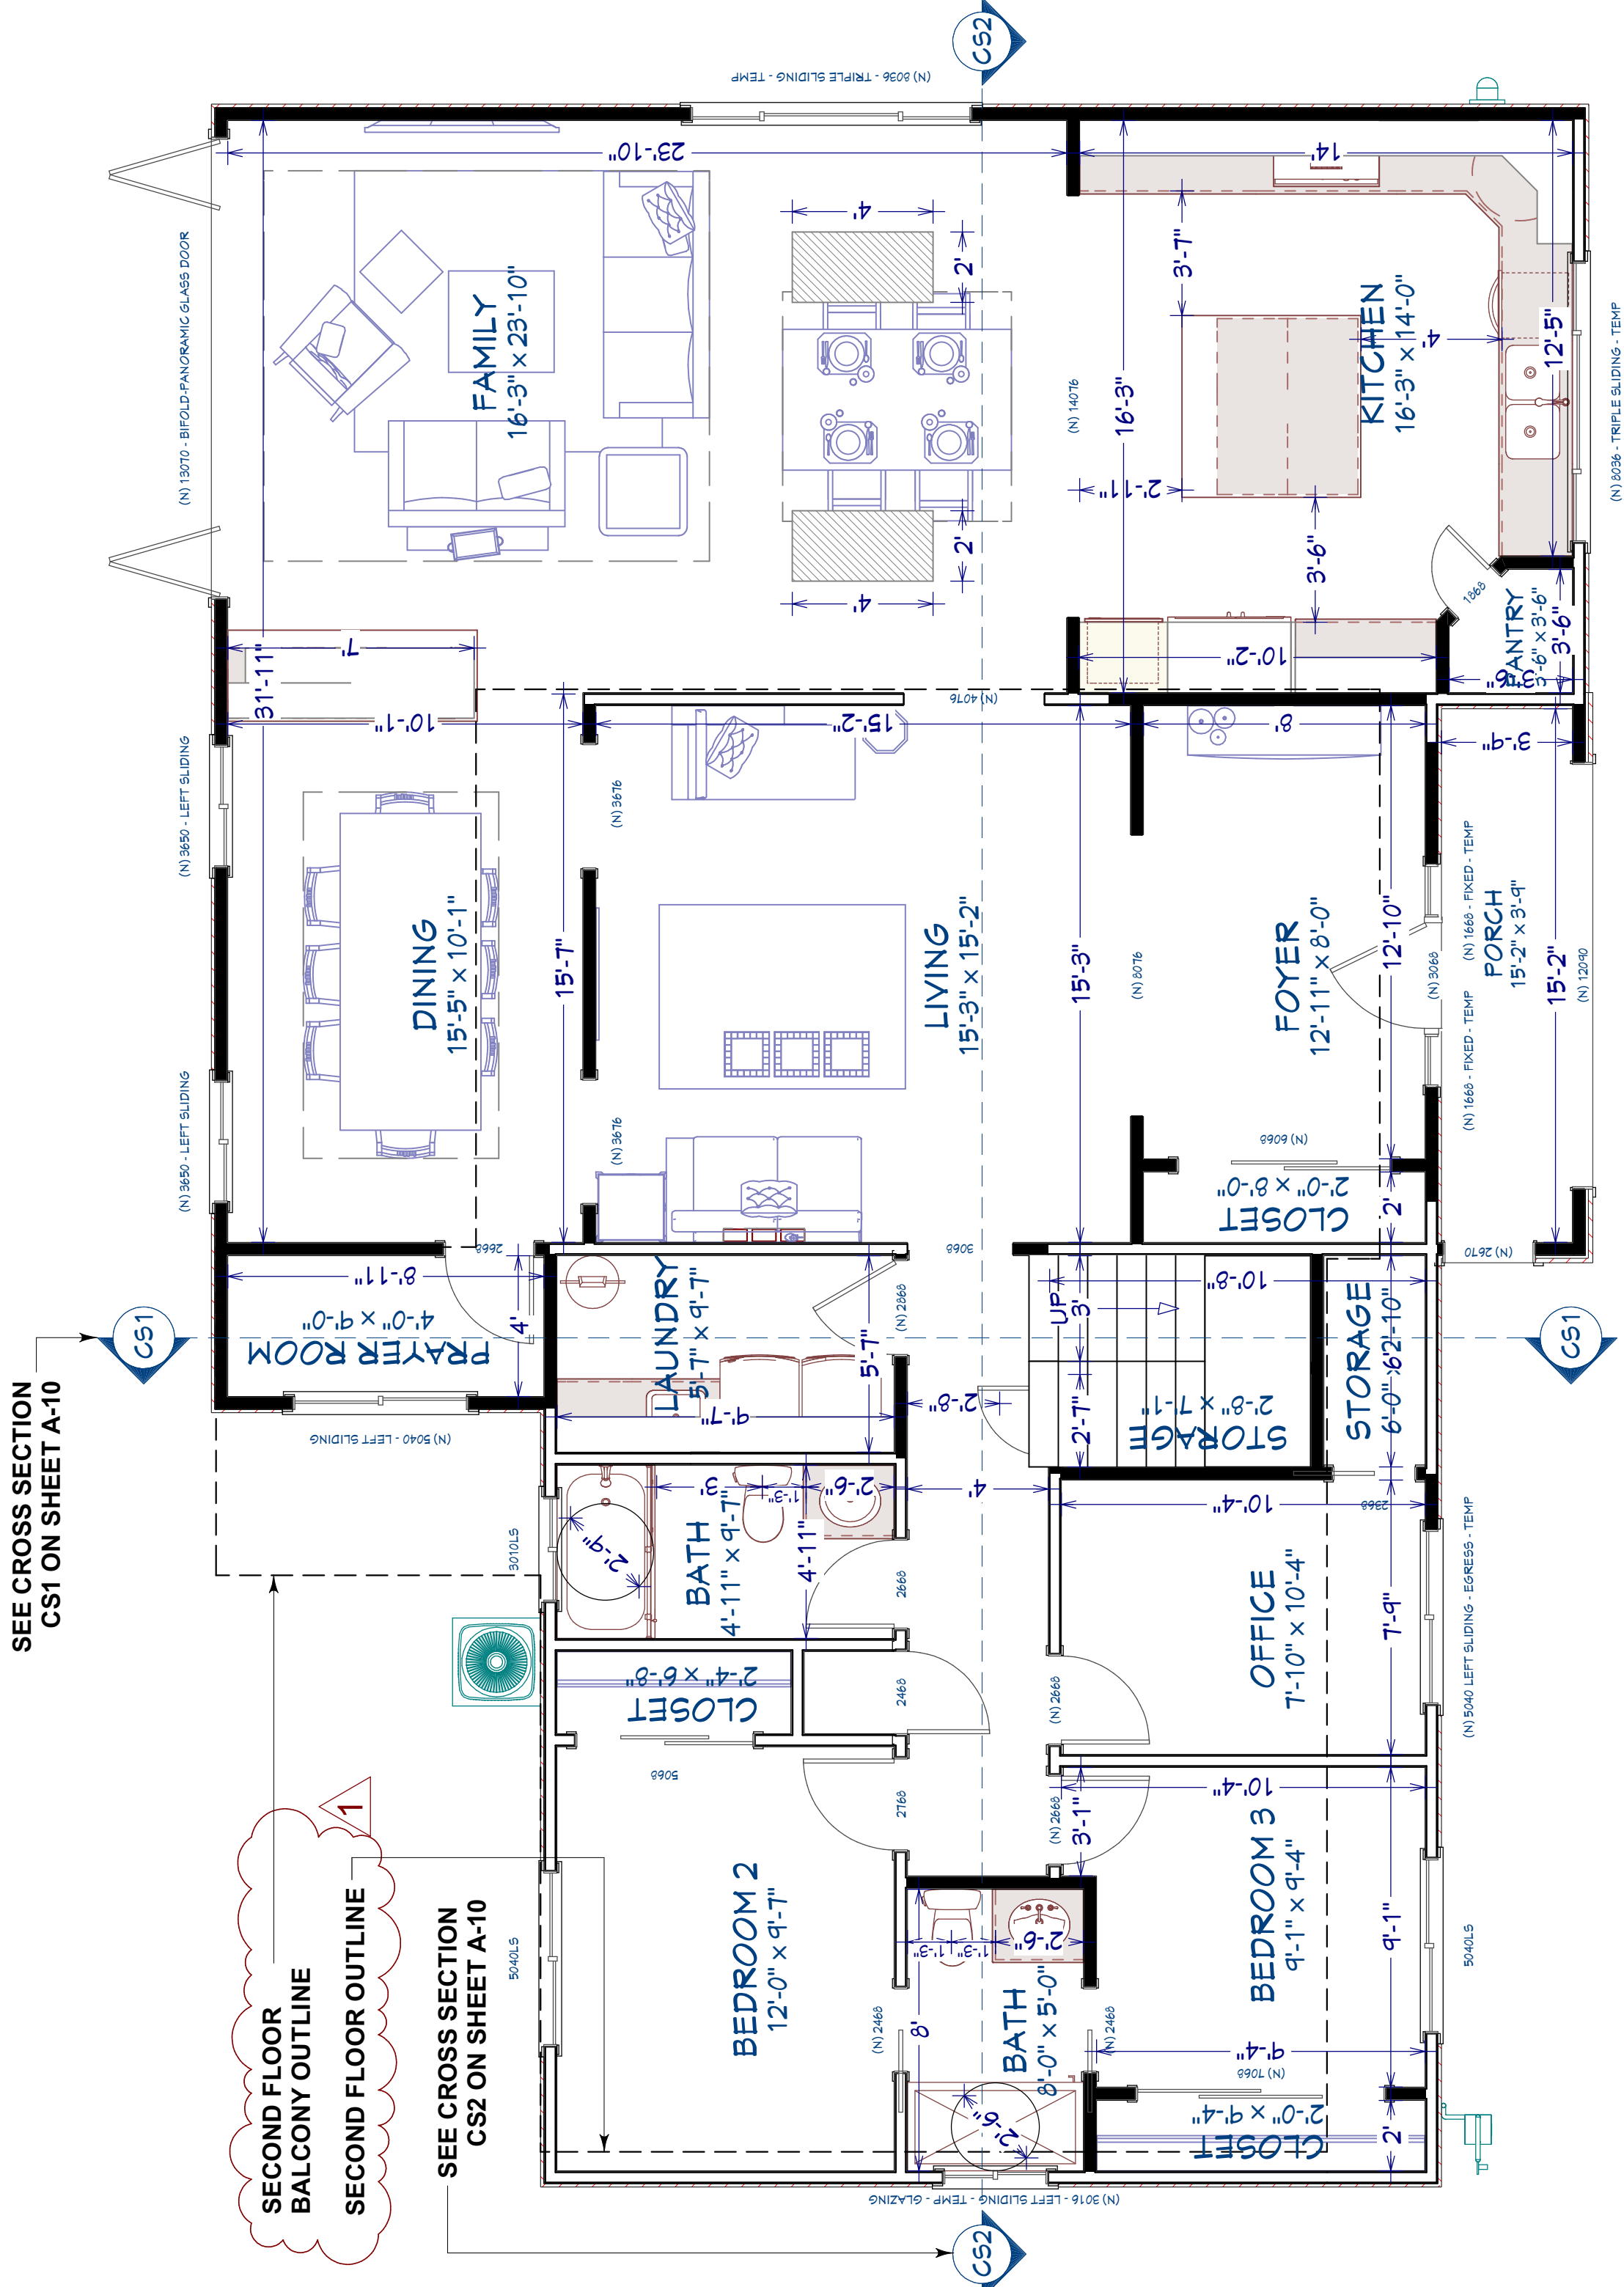

PROPOSED FLOOR PLAN - FIRST FLOOR
SCALE 1/4"=1'-0"

NO.	DESCRIPTION	BY	DATE
1	CORRECTION FROM DESIGN REVIEW 1		10.12.16
2	CORRECTION FROM DESIGN REVIEW 2		11.16.16

SHEET TITLE:
EXISTING & PROPOSED FLOOR PLAN

PROJECT DESCRIPTION:
ADDITION & REMODELING
1314 Lillian Ave.,
SUNNYVALE, CA 94087


JF CONSULTING
3001 S. Winchester Blvd., #8
Campbell, CA 95008
TEL: 408.512.8400 - Email: JFPLANS@GMAIL

11/17/2016

SHEET:

A- 5

PROJECT DESCRIPTION: 1314 Lillian Ave., SUNNYVALE, CA 94087		JF CONSULTING 3001 S. Winchester Blvd., #8 Campbell, CA 95008 TEL: 408.512.8400 - Email: jfPLANS@gmail		11/17/2016		SHEET: 6	
SHEET TITLE: EXISTING & PROPOSED FLOOR PLAN		NO. DESCRIPTION 1 CORRECTION FROM DESIGN REVIEW 1 2 CORRECTION FROM DESIGN REVIEW 2		BY DATE 10.12.16 11.16.16		GARAGE	

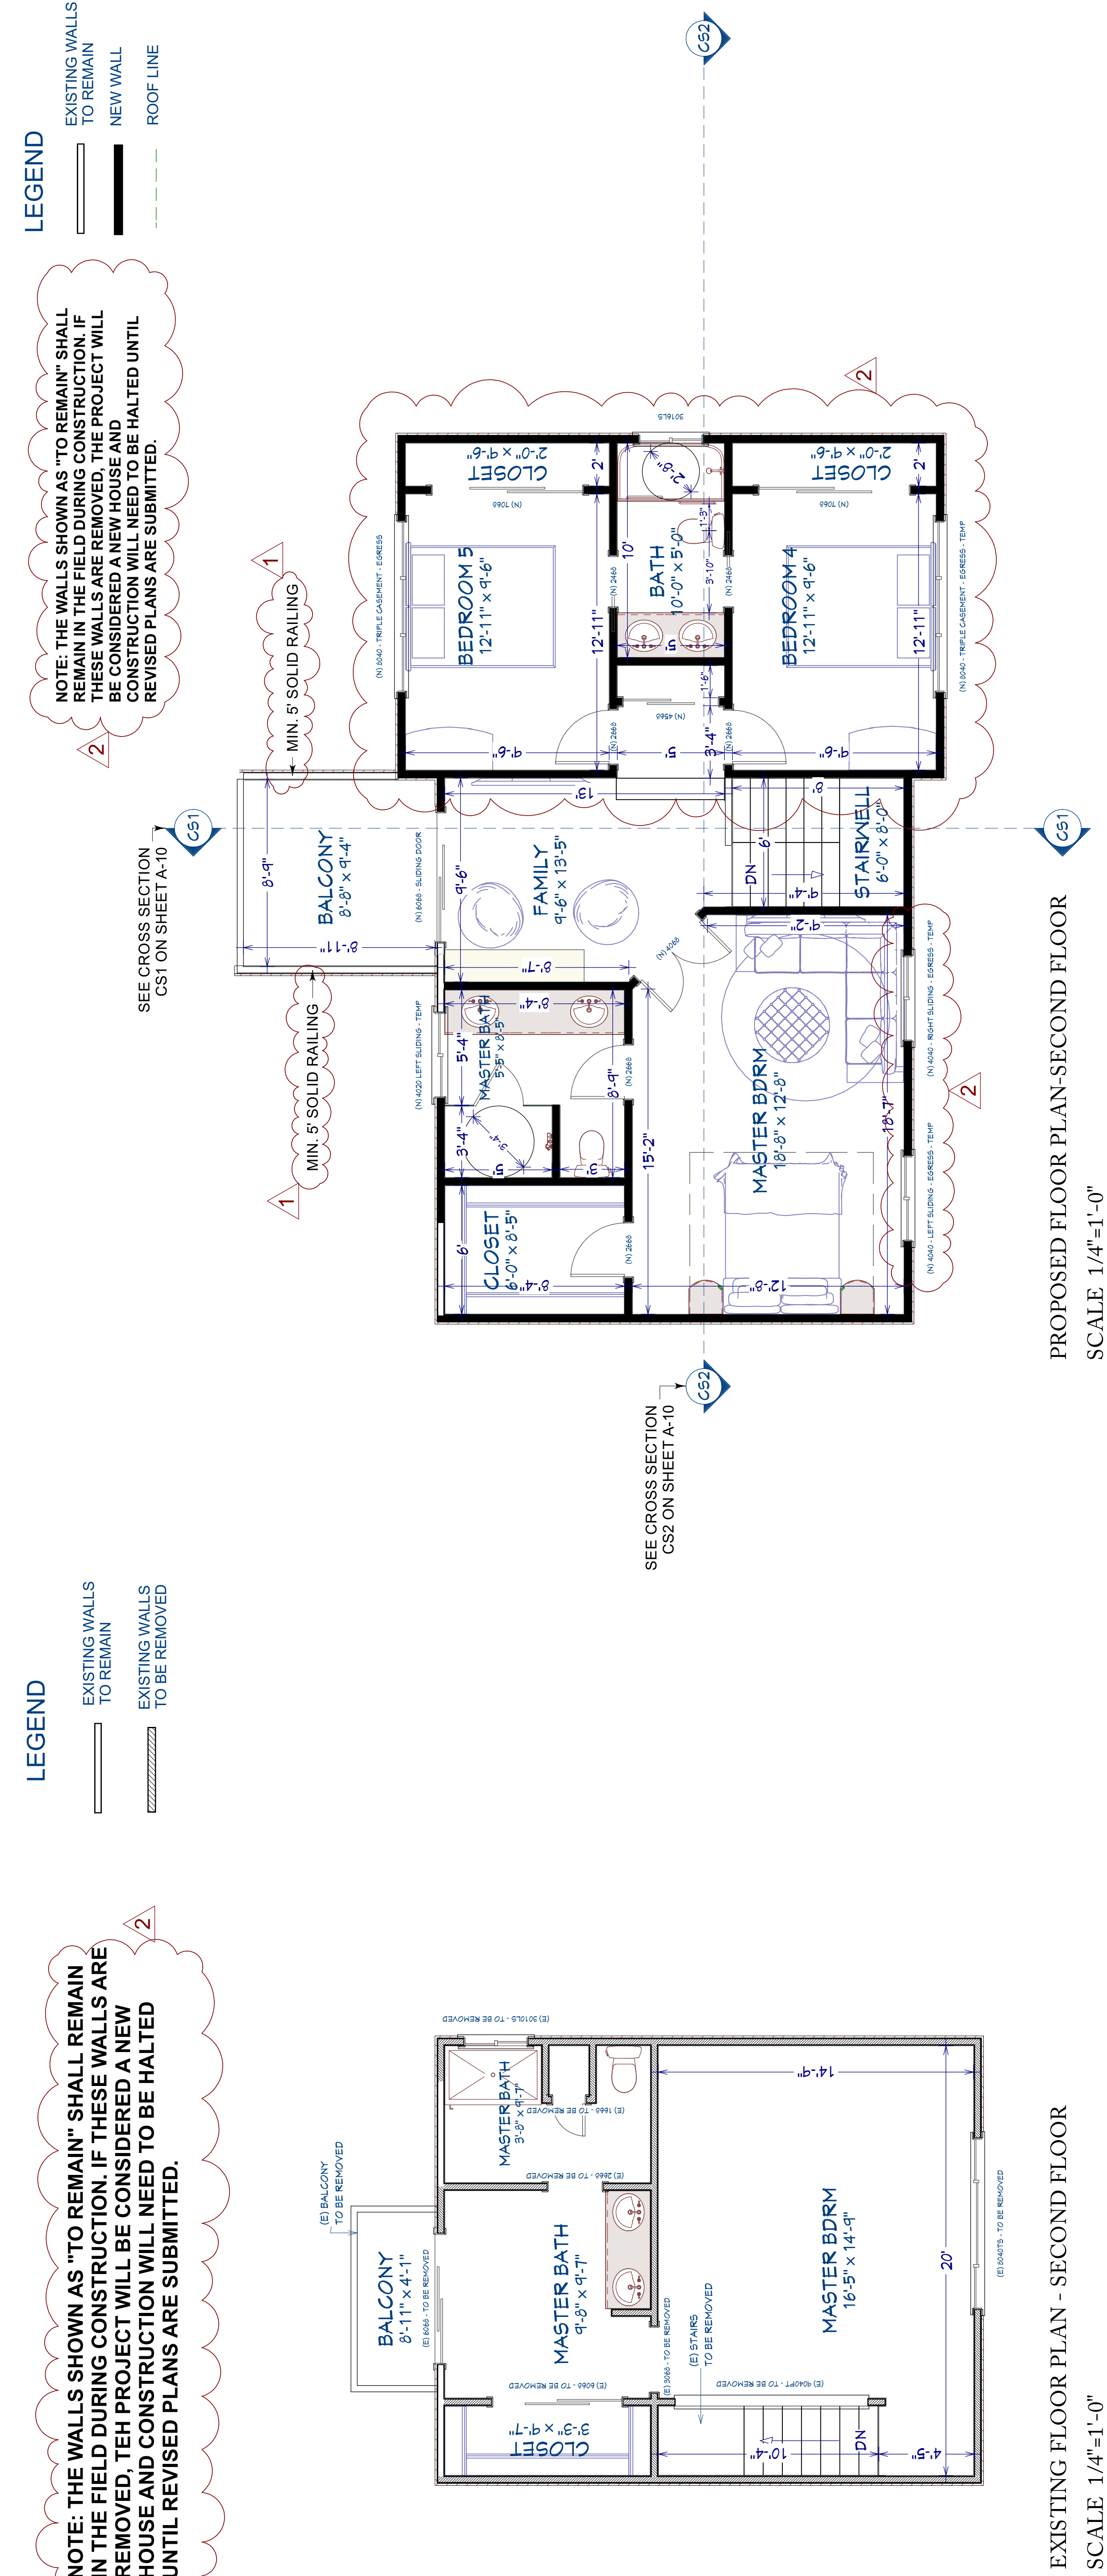



NO.	DESCRIPTION	BY	DATE
1	CORRECTION FROM DESIGN REVIEW 1	10.12.16	
2	CORRECTION FROM DESIGN REVIEW 2	11.11.16	

EXISTING AND PROPOSED ELEVATIONS
DETAILS & NOTES

PROJECT DESCRIPTION:
1314 Lillian Ave.,
SUNNYVALE, CA 94087


JF CONSULTING
3001 S. Winchester Blvd., #8
Campbell, CA 95008
TEL: 408.512.8400 - Email: jfplans@gmail

11/17/2016




SHEET:
11/17/2016

A- 8

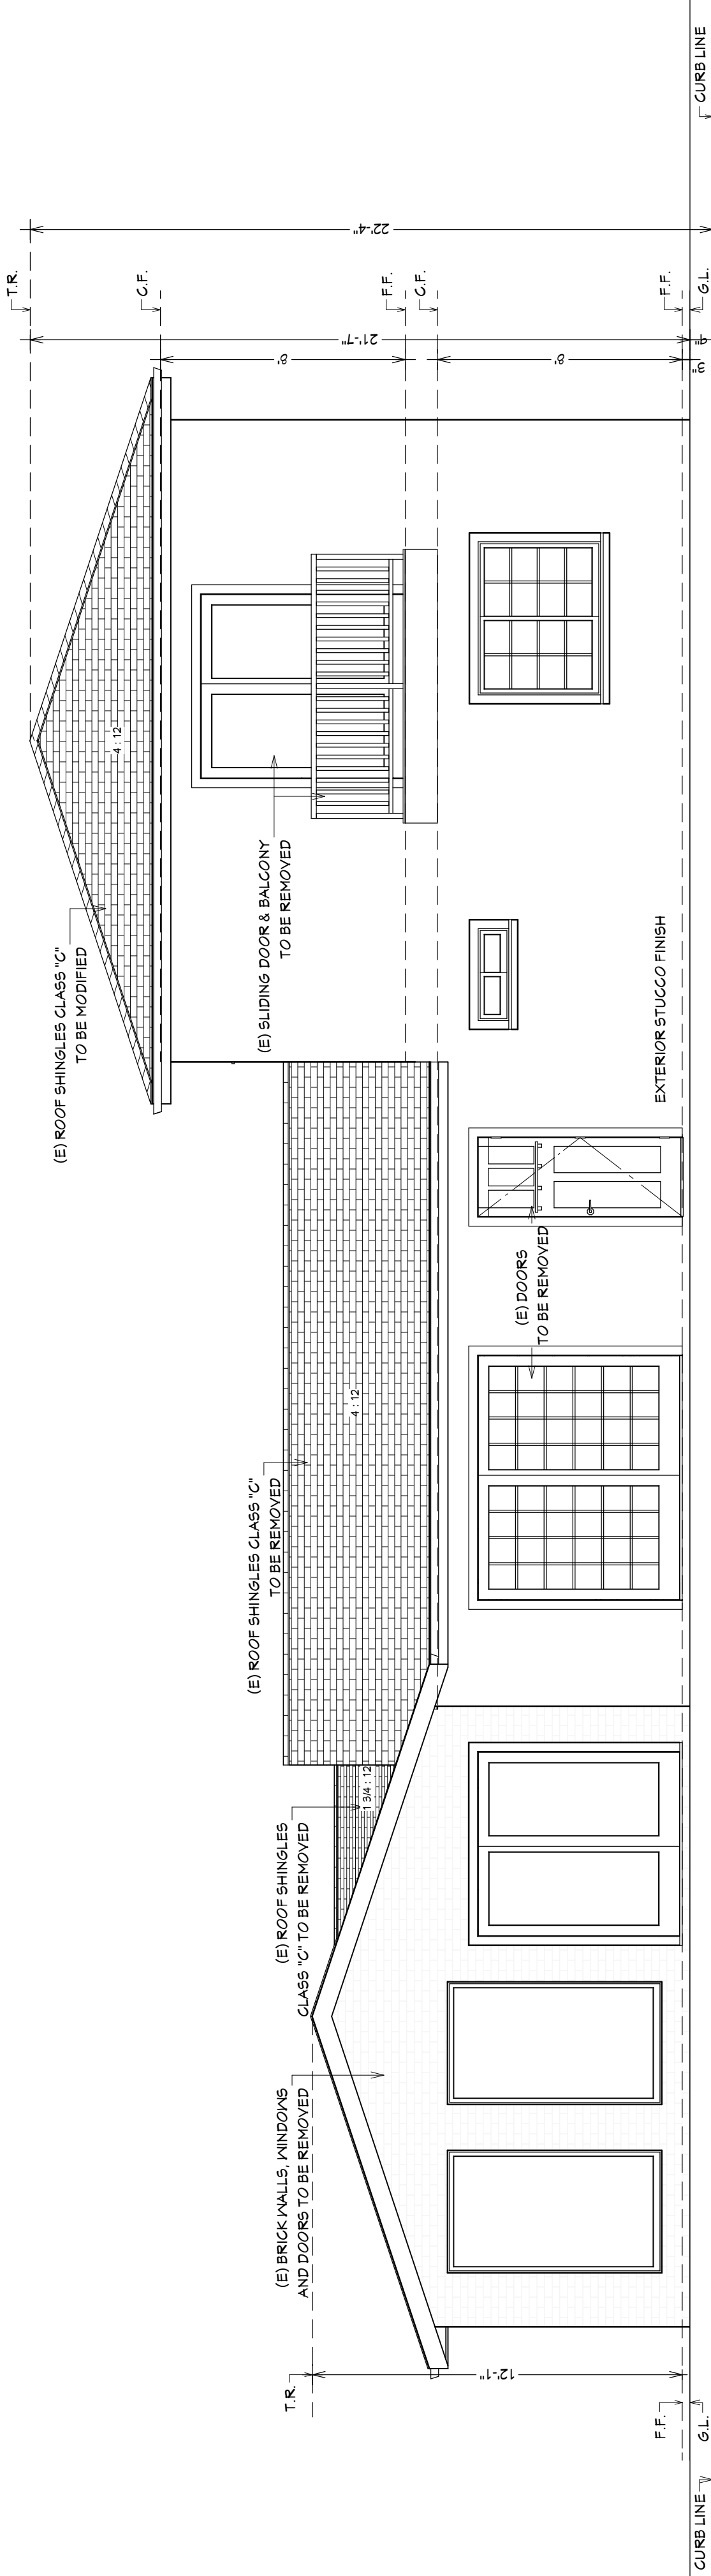


EXISTING REAR ELEVATION

SCALE 1/4"=1'-0"

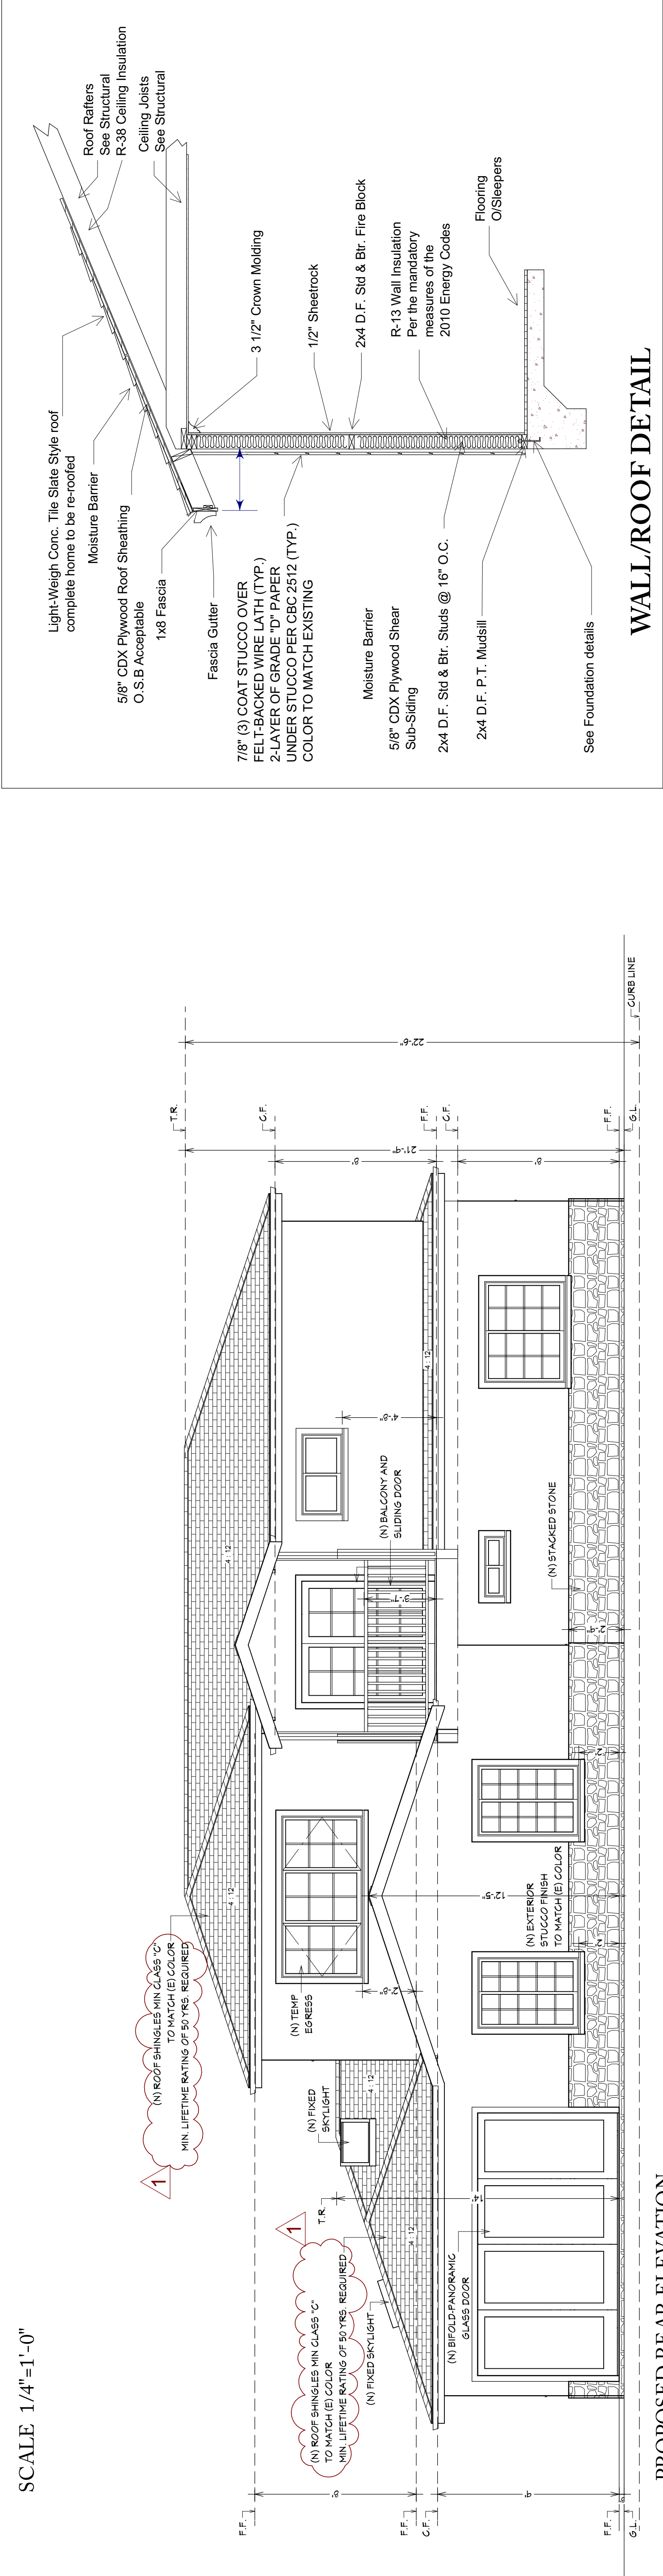

PROPOSED REAR ELEVATION

SCALE 1/4"=1'-0"

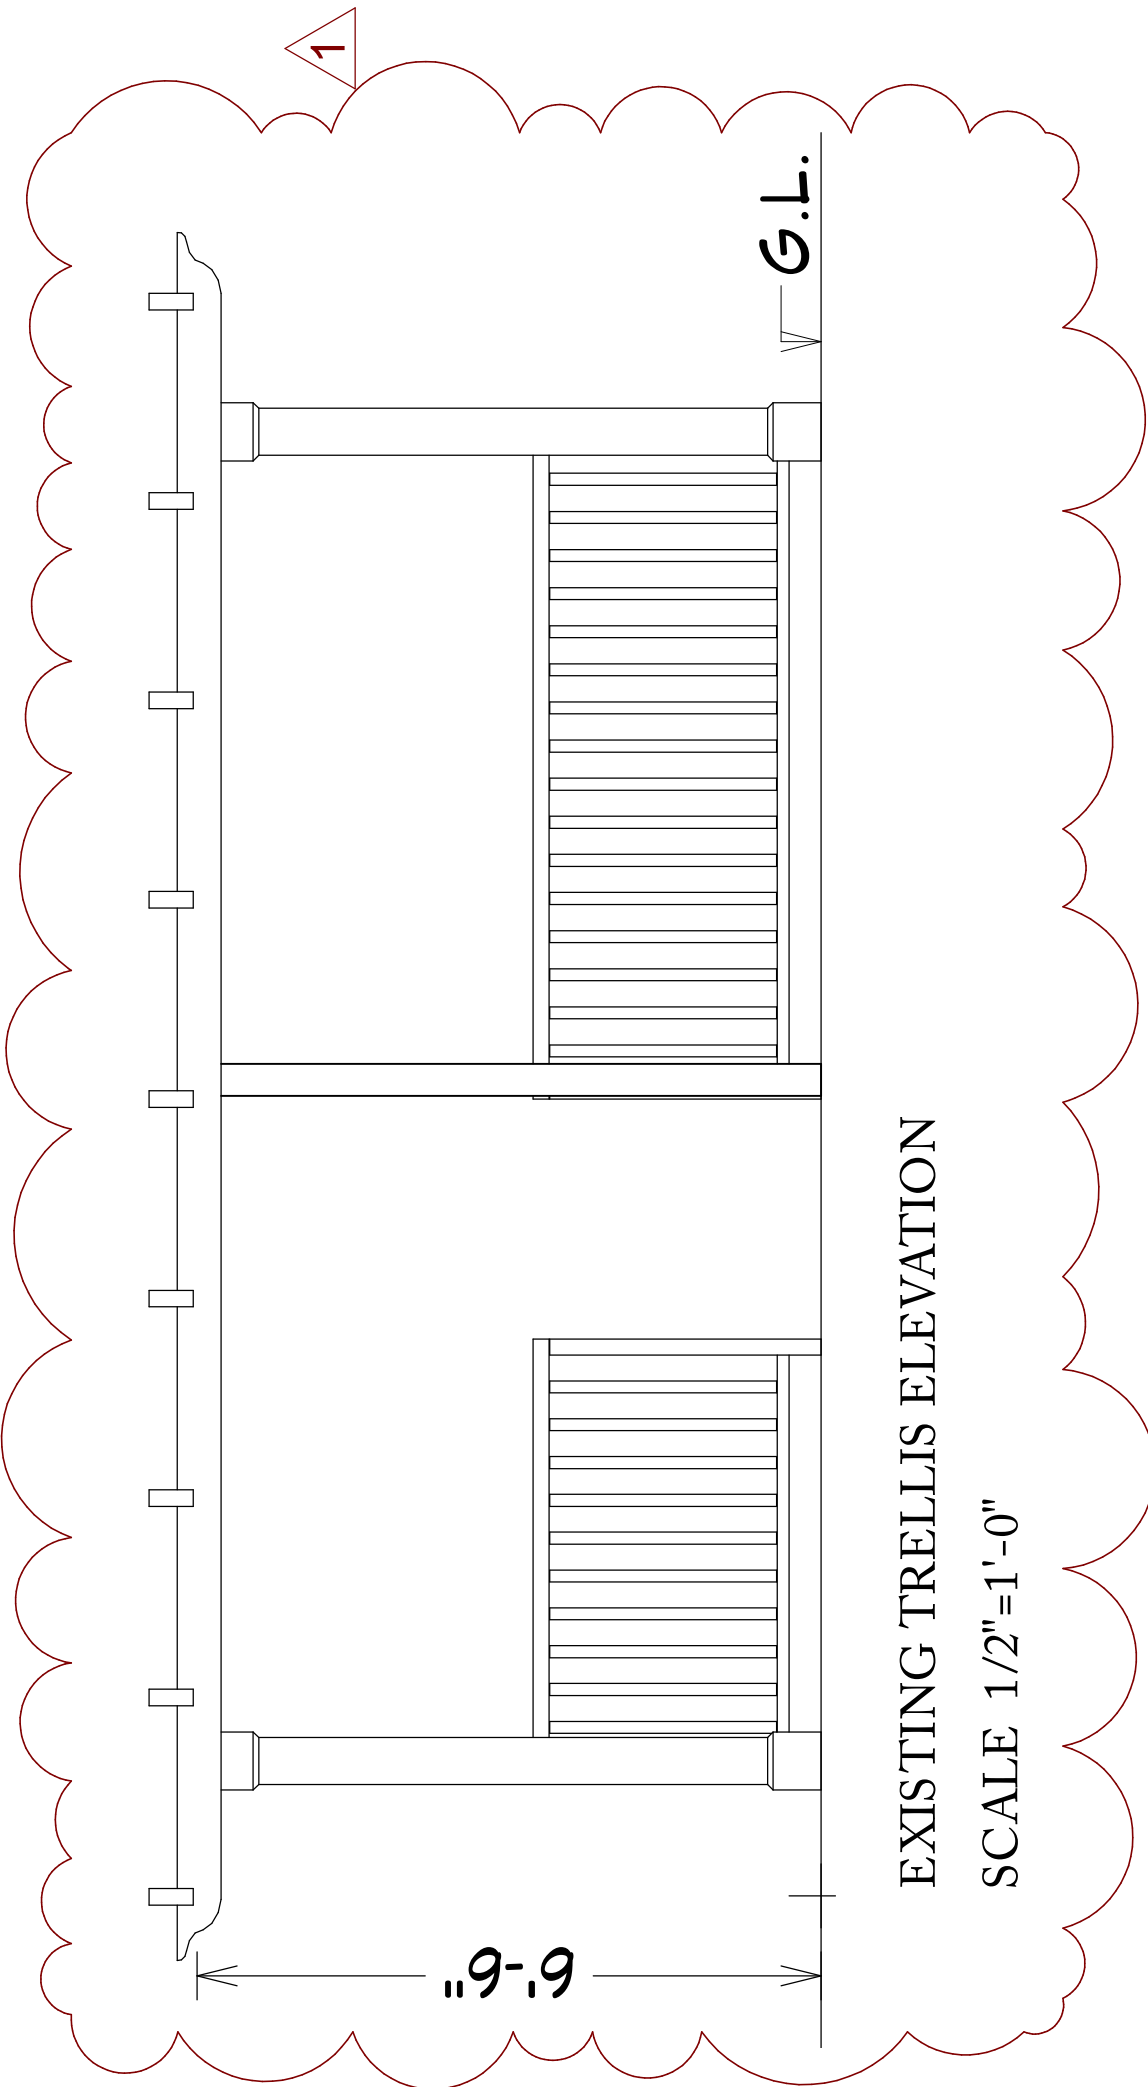

EXISTING TRELLIS ELEVATION

SCALE 1/2"=1'-0"

CRAWLSPACE VENTING CALCULATIONS: (ADDITION)

Required $877 \text{ Sq. Ft.} \times 1/150 = 5.85 \text{ Sq. Ft.} \times 144 = 842.4 \text{ Sq. In.} = \text{Required}$


(6) 15" x 10" = 150 Sq. In. for each * (6) = 900 Sq. In. > 842.4 Sq. In (Okay)

ATTIC VENTILATION CALCULATIONS: (ADDITION)

Required $179 \text{ Sq. Ft.} \times 1/150 = 1.19 \text{ Sq. Ft.} \times 144 = 171.36 \text{ Sq. In.} = \text{Required}$

(1) 18" Round Gable End = 254 Sq. In. * (1) = 254 Sq. In. > 171.36 Sq. In (Okay)

CONTRACTOR TO COMPENSATE ADDITIONAL VENTS FOR BOTH
BLOCKED CRAWLSPACE VENTILATION & ROOF VENTILATION ON
THE EXISTING HOUSE.

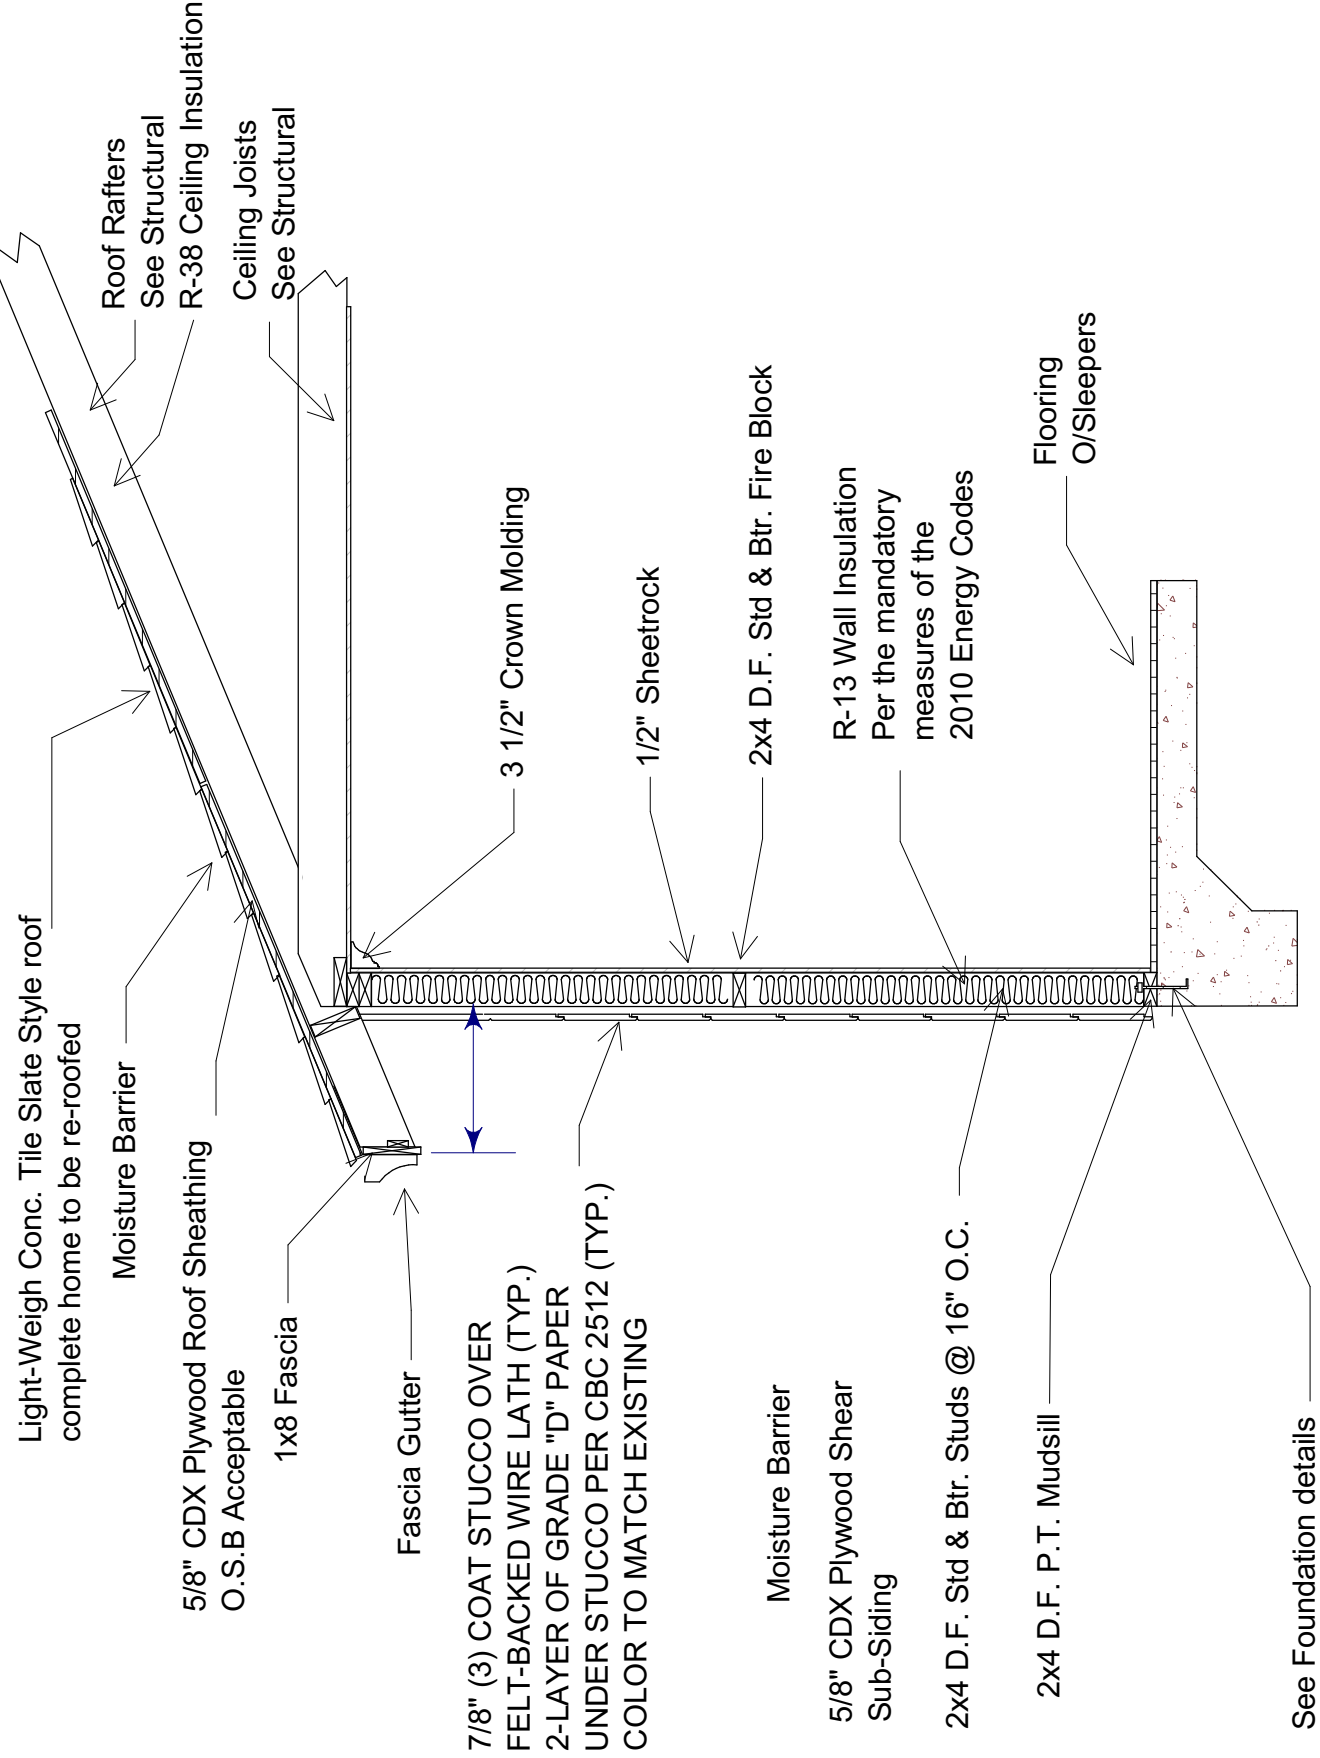

WALL/ROOF DETAIL



NO.	DESCRIPTION	BY	DATE
1	CORRECTION FROM DESIGN REVIEW 1		10.12.16
2	CORRECTION FROM DESIGN REVIEW 2		11.16.16

EXISTING AND PROPOSED ELEVATIONS


PROJECT DESCRIPTION:
1314 Lillian Ave.,
SUNNYVALE, CA 94087

JF CONSULTING
3001 S. Winchester Blvd., #8
Campbell, CA 95008
TEL: 408.512.8400 - Email: jfPLANS@GMAIL


11/17/2016

SHEET:

A-9

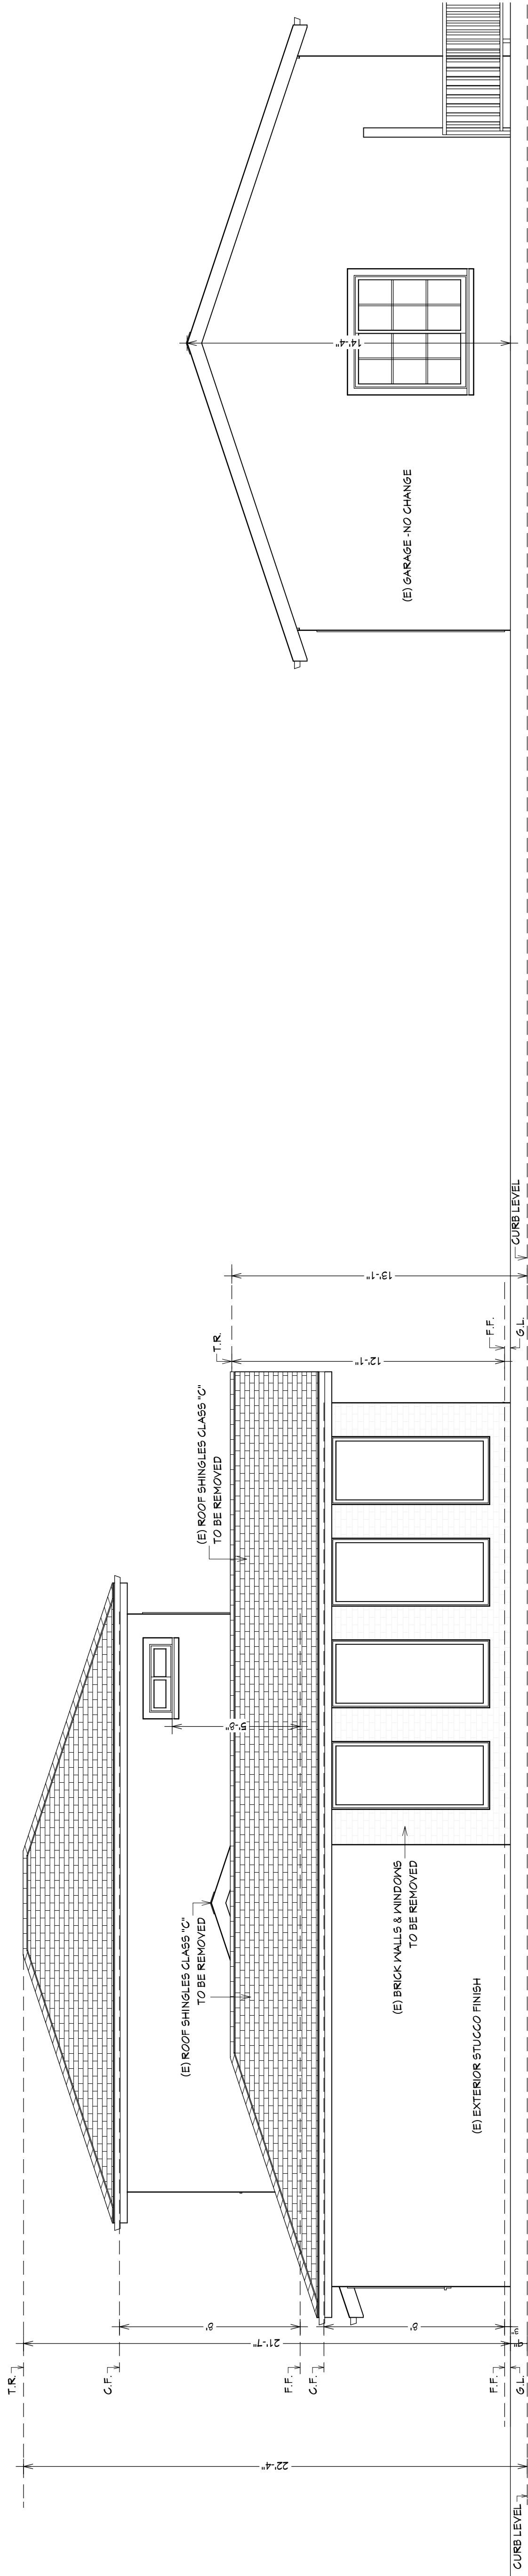

EXISTING RIGHT ELEVATION
SCALE 1/4"=1'-0"

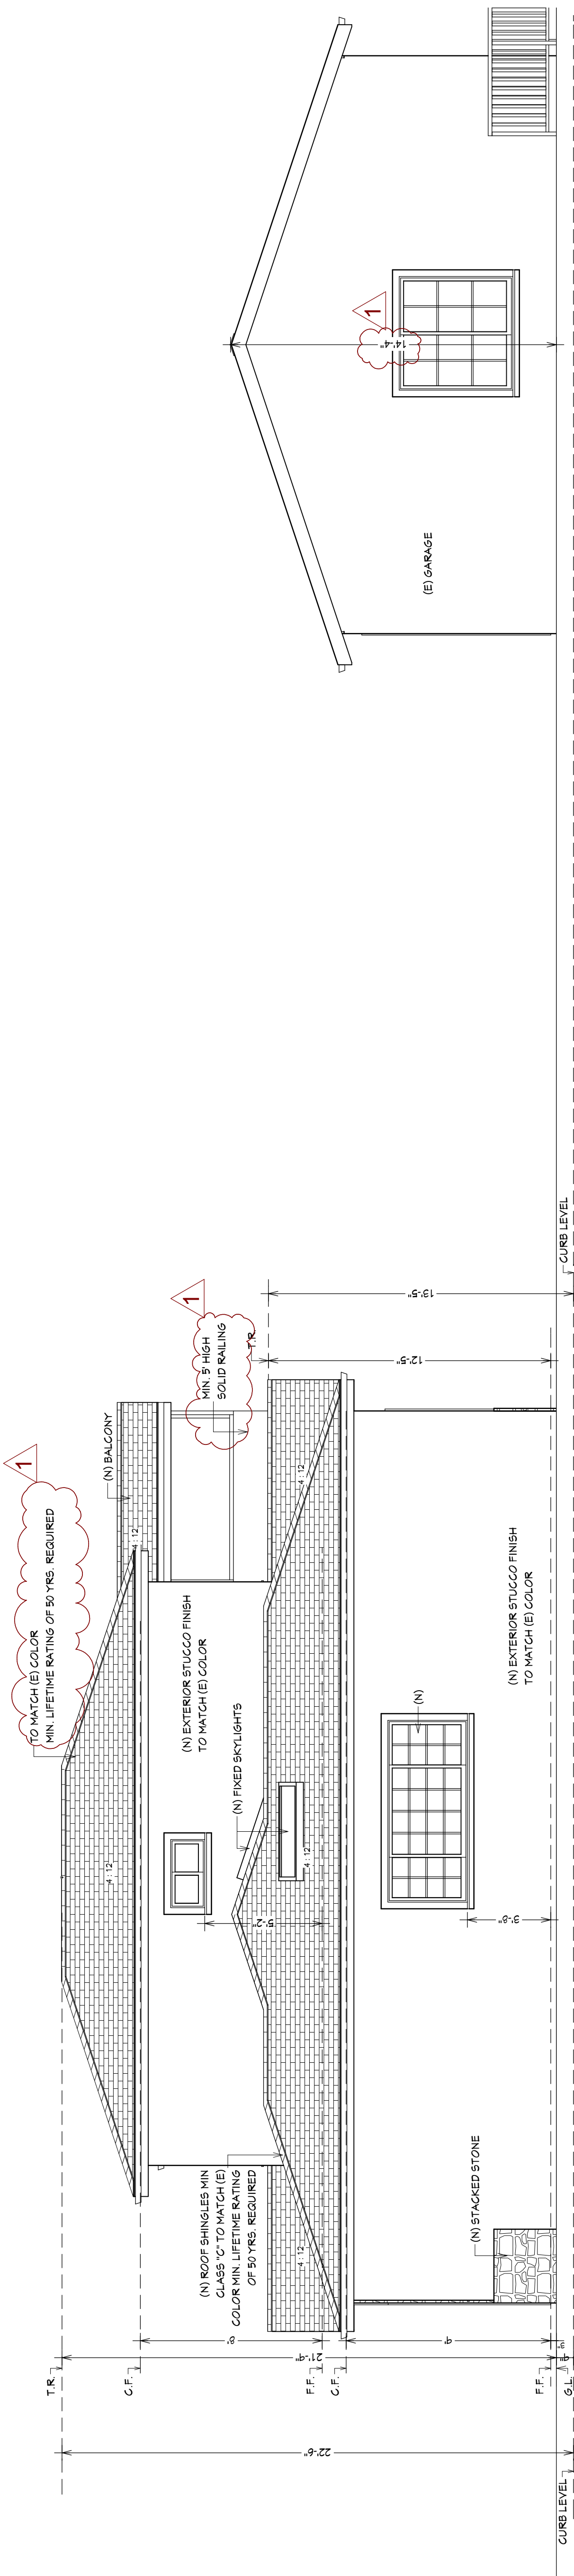

PROPOSED RIGHT ELEVATION
SCALE 1/4"=1'-0"




NO.	DESCRIPTION	BY	DATE
1	CORRECTION FROM DESIGN REVIEW 1		10.12.16
2	CORRECTION FROM DESIGN REVIEW 2		11.11.16

CROSS SECTIONS
EXISTING AND PROPOSED
ELEVATIONS & PROPOSED
CROSS SECTIONS

PROJECT DESCRIPTION:
ADDITION & REMODELING
1314 Lillian Ave.,
SUNNYVALE, CA 94087


JF CONSULTING
3001 S. Winchester Blvd., #8
Campbell, CA. 95008
TEL: 408.512.8400 - Email: jfplans@gmail

11/17/2016

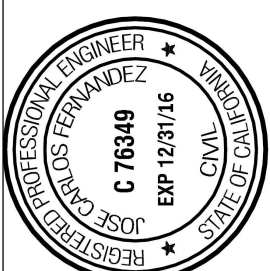


SHEET:


A-10

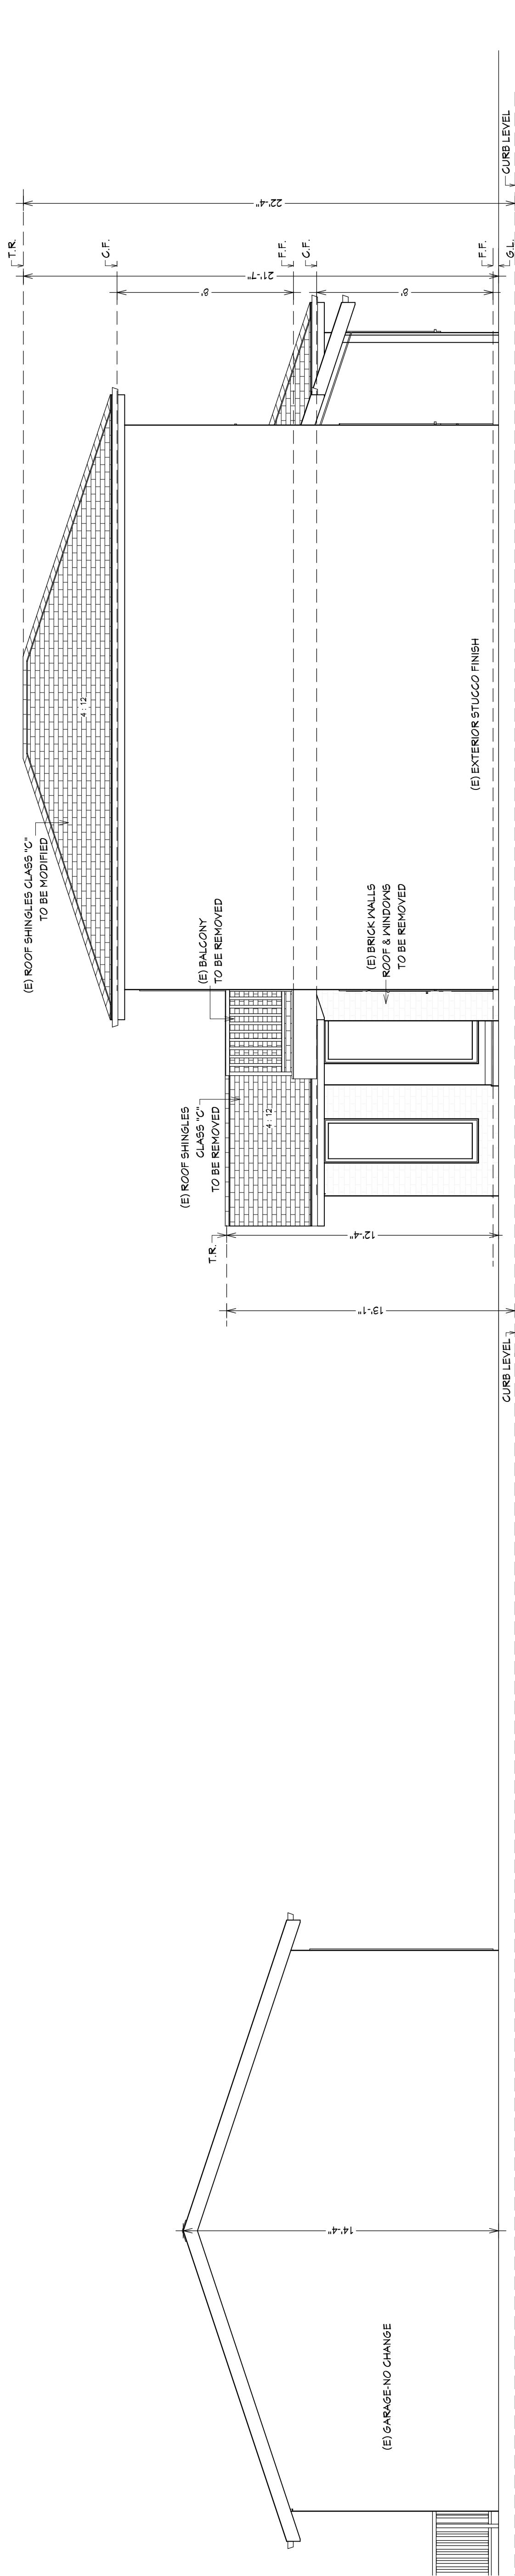

EXISTING LEFT ELEVATION
SCALE 1/4"=1'-0"

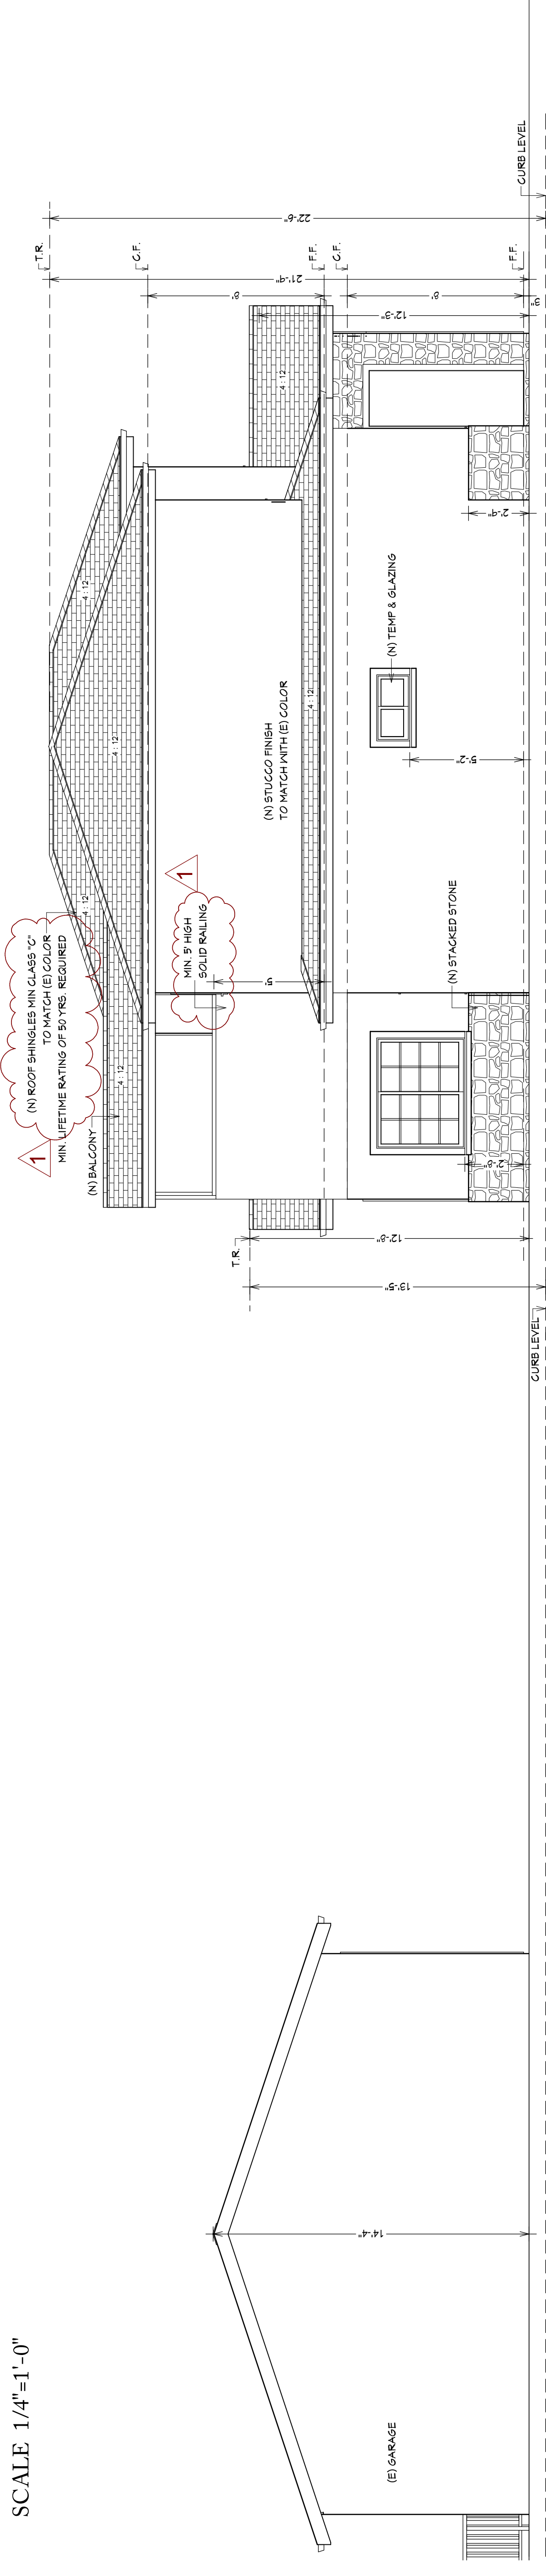

PROPOSED LEFT ELEVATION
SCALE 1/4"=1'-0"

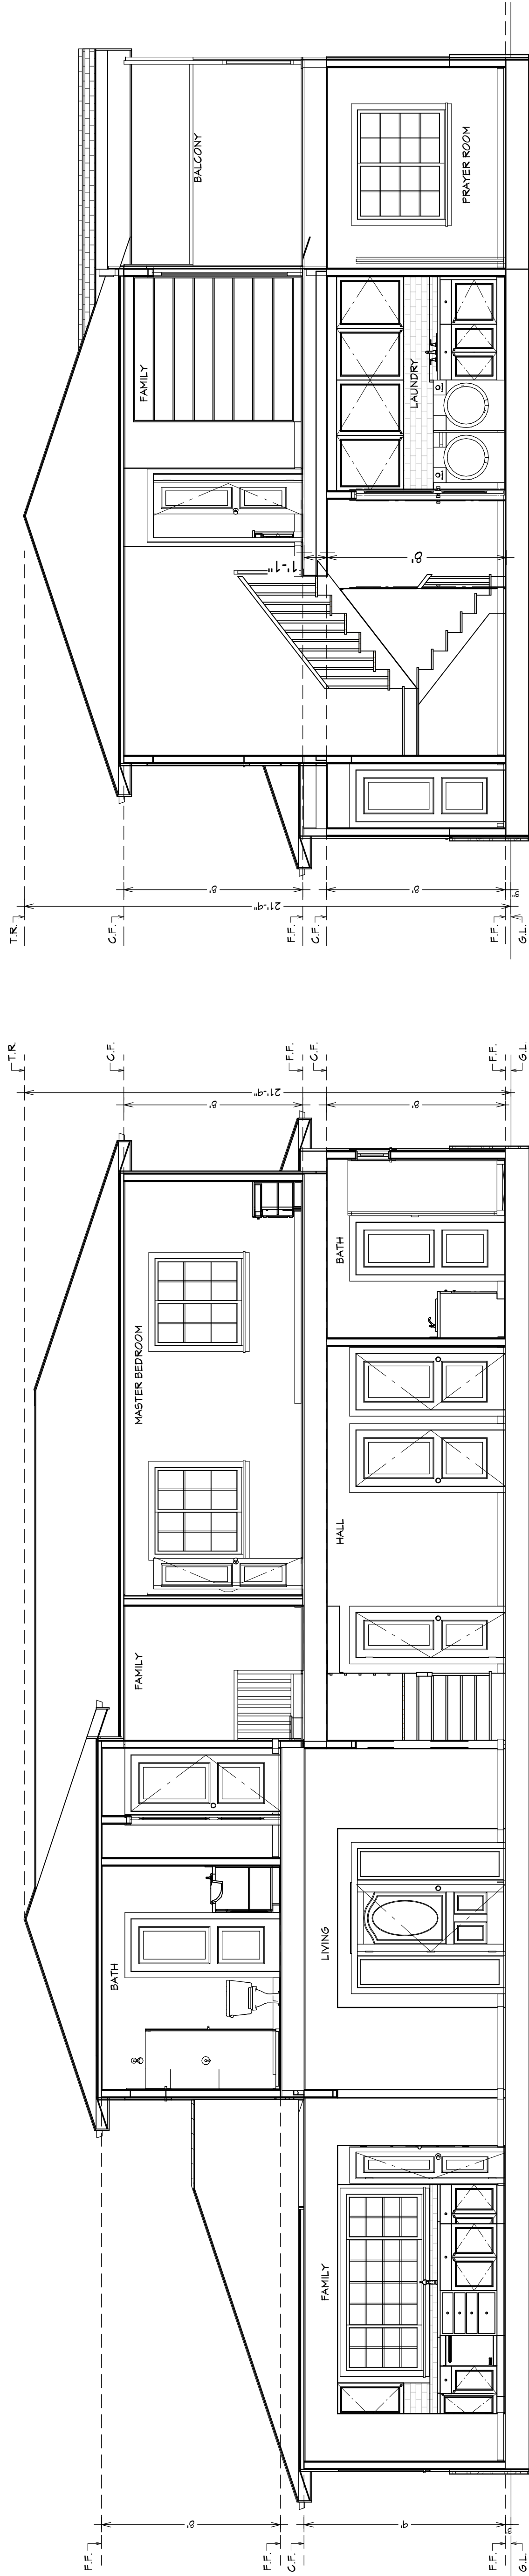

PROPOSED CROSS SECTION CS-1
SCALE 1/4"=1'-0"

PROPOSED CROSS SECTION CS-2
SCALE 1/4"=1'-0"

FLOOR PLAN NOTES:

ALL WINDOWS SHALL BE DUAL PANE UNLESS OTHERWISE NOTED. AND SAFETY GLASS (TEMPERED GLASS) TO BE PROVIDED FOR DOORS AND WINDOWS ADJACENT TO OPENINGS. ALL WINDOWS IN BATHS, AND IN WINDOWS WHERE EXPOSED BOTTOM EDGE OF GLAZING IS LESS THAN 18" ABOVE FLOOR.

CONTRACTOR TO PROVIDE CERTIFICATE OF COMPLIANCE FOR INSULATION FOR R-13 WALL, R-19 CEILING OR BETTER.

WATER METER MUST BE INSTALLED PRIOR TO FINAL INSPECTION AND MUST NOT BE LOCATED IN DRIVE OR APPROACH WHERE REQUIRED.

ALL WEATHER STRIPPING, CAULKING, AND SEALING OF EXTERIOR DOORS, WINDOWS, AND BLDG. ENVELOPE OPENINGS, AS REQUIRED BY THE C.R.C. SHALL BE SUBJECT TO FIELD INSPECTION.

ALL MANUFACTURED DOORS AND WINDOWS SHALL BE CERTIFIED AND LABELED.

NAILING SPECIFIED WITHIN THE STRUCTURE CALCULATIONS AND DETAIL SHALL BE DONE USING COMMON NAILS. PROVIDE I.C.C APPROVAL PRIOR TO THE INSTALLATION OF AN ALTERNATE FASTENER.

PIPING IN UNCONDITIONED SPACE LEADING TO AND FROM WATER HEATERS SHALL BE INSULATED WITH AN INSTALLED THERMAL RESISTANCE OF R-3 OR GREATER FOR FIVE FEET OF PIPE CLOSEST TO THE WATER HEATER, OR WHATEVER SHORTER LENGTH IS IN UNCONDITIONED SPACES.

FOR KITCHEN, A CLEAR PASSAGEWAY OF NOT LESS THAN 3- FEET BETWEEN THE COUNTER FRONTS AND APPLIANCE OR COUNTER FRONTS AND WALLS. CBC 1208.1

BATHROOMS & KITCHEN:

- a. 22" MIN SHOWER DOOR CLEARANCE
- b. TEMPER GLAZING FOR THE SHOWER DOOR AND SLIDING WINDOWS. CEMENT BOARD SUBSTRATE FOR SHOWER WALLS.
- c. LAVATORY FACETS TO HAVE A FLOW RATE OF 1.5 GPM OR LESS AT 60 PSI. (CALGREEN 4.303.1)
- d. WATER CLOSETS TO HAVE A FLOW RATE OF 1.28 GALLONS/FLUSH OR LESS. (CALGREEN 4.303.1)
- e. CEMENT BOARD SUBSTRATE (IE. DUROCK OR WONDERBOARD ETC) FOR TILE APPLICATION SURROUNDING THE BATH TUB WALLS.
- f. KITCHEN FAUCETS TO HAVE A FLOW RATE OF 1.8 GPM OR LESS AT 60 PSI. (CALGREEN 4.303.1)
- g. SHOWER COMPARTMENTS AND WALLS ABOVE BATHTUBS WITH INSTALLED SHOWER HEADS SHALL BE FINISHED WITH A NONABSORBENT SURFACE TO HEIGHT NOT LESS THAN 6 FEET ABOVE THE FLOOR PER CRC R307.2.

ALL HOSE BIBBS INSTALLED SHALL BE PROTECTED BY AN APPROVED NON-REMOVABLE TYPE BACK FLOW PREVENTION DEVICE.

BATHROOMS, WATER CLOSET COMPARTMENTS, LAUNDRY ROOMS, ETC., SHALL BE PROVIDED WITH NATURAL VENTILATION BY MEANS OF OPENABLE EXTERIOR OPENINGS W/AN AREA OF NOT LESS THAN 1/20 OF THE FLOOR AREA W/MIN. OF 1-1/2 SQ.F.T. OR 5 AIR CHANGES PER HOUR.

WALL SURFACE BEHIND CERAMIC TILE OR OTHER FIN. WALL MATERIALS SUBJECT TO WATER SPLASH SHALL BE CONSTRUCTED OF MATERIALS NOT ADVERSELY AFFECTED BY WATER. (APPROVED WR GYP. BD. INSTALLED ACC. TO C.B.C 4712.)

PRIOR TO BUILDING FINAL INSPECTION AN 'APPLIANCE CERTIFICATE', SIGNED BY THE INSTALLER OR GEN. CONTRACTOR, SHALL BE POSTED IN A CONSPICUOUS LOCATION.

TUB/SHOWER AND WATER CLOSET REQUIREMENTS:

- a. THE MIXING VALVE IN A SHOWER (INCLUDING OVER A TUB) SHALL BE PRESSURE BALANCING SET AT A MAXIMUM 120 DEGREE F. THE WATER-FILLER VALVE IN BATHTUBS/WHIRLPOLS SHALL HAVE A TEMPERATURE LIMITING DEVICE SET AT A MAXIMUM OF 120 DEGREE F. THE WATER HEATER THERMOSTAT CANNOT BE USED TO MEET THESE PROVISIONS. (CPC 408.3, 409.4)
- b. NEW OR RECONFIGURED SHOWER STALL SHALL BE A MINIMUM FINISHED INTERIOR OF 1,024 SQUARE INCHES, BE CAPABLE OF ENCOMPASSING A 30 INCH DIAMETER CIRCLE. ANY DOORS SHALL SWING OUT OF THE ENCLOSURE HAVE A CLEAR OPENING OF 22 INCHES MINIMUM. (CPC 408.5, 408.6)
- c. SHOWER STALLS AND BATHTUB WITH SHOWER HEADS INSTALLED, SHALL HAVE WALLS FINISHED WITH A NON-ABSORBENT SURFACE FOR A MINIMUM OF 6 FEET ABOVE FLOOR. (CBC 1210 AND CRC R307.2)
- d. THE WATER CLOSET SHALL HAVE A CLEARANCE OF 30 INCHES WIDE (15 INCHES ON CENTER) AND 24 INCHES IN FRONT) (CPC 402.5).
- e. WHERE THE WATER CLOSET (OR OTHER PLUMBING FIXTURE) COMES INTO CONTACT WITH THE WALL OR FLOOR THE JOINT SHALL BE CAULKED AND SEALED TO BE WATERTIGHT" (CPC 402.2)

LOCATE AND EXPOSE ALL PROPERTY CORNERS AND STRING THE SIDE YARD PROPERTY LINES PRIOR TO FOUNDATION INSPECTION.

INSULATION NOTES:

AFTER INSTALLING INSULATION, THE INSULATION INSTALLER SHALL POST IN A CONSPICUOUS LOCATION IN THE BUILDING A CERTIFICATE SIGNED BY THE INSTALLER AND THE BUILDER STATING THAT THE INSTALLATION CONFORMS WITH THE REQUIREMENTS OF TITLE 24, PART 2, CHAPTER 2 53, AND THE MATERIALS INSTALLED CONFORM WITH THE REQUIREMENTS OF TITLE 24, CHAPTER 2, SUB CHAPTER 2, ART. 3. THE CERTIFICATE SHALL STATE THE MANUFACTURER'S NAME AND MATERIALS INSTALLED 'R' VALUE, AND (IN APPLICATIONS OF LOOSE FILL INSULATION), THE MINIMUM INSTALLED WEIGHT PER SQUARE FOOT CONSISTENT WITH THE MANUFACTURER'S LABELED DENSITY FOR THE DESIRED 'R' VALUE. SECTION 1403(d) TITLE 24, CALC.

BUILDER SHALL PROVIDE THE ORIGINAL OCCUPANT WITH A LIST OF THE HEATING, COOLING, WATER HEATING AND LIGHTING SYSTEMS AND CONSERVATION OR SOLAR DEVICES INSTALLED IN THE BUILDING AND INSTRUCTIONS ON HOW TO USE THEM EFFICIENTLY. SEC. 1403(e) TITLE 24, CALCS.

GENERAL NOTES:

- 1. ALL WORK SHALL BE DONE IN ACCORDANCE WITH LOCAL CITY, COUNTY AND STATE STANDARDS, AND SECTIONS OF CBC, CRC, CALIFORNIA ENERGY CODE, CPC, CEC, IN THE EVENT OF CONFLICT, THE HIGHER STANDARDS AND SPECIFICATIONS SHALL PREVAIL.
- 2. IT IS THE RESPONSIBILITY OF THE CONTRACTOR TO VERIFY HORIZONTAL AND VERTICAL LOCATIONS OF ALL EXISTING UTILITIES PRIOR TO COMMENCING WORK. THE DESIGNER ASSUMES NO RESPONSIBILITY FOR LOCATION OF EXISTING UTILITIES SHOWN OR NOT SHOWN ON PLANS.
- 3. ELEVATIONS AND DISTANCES SHOWN ON PLANS ARE APPROXIMATE AND MAY VARY. IT SHALL BE THE CONTRACTOR RESPONSIBILITIES TO VERIFY SUCH ELEVATIONS AND DISTANCES IN THE FIELD FOR ANY DISCREPANCIES.
- 4. PRIOR TO COMMENCING WORK, ALL NECESSARY BUILDING, PLUMBING, ELECTRICAL PERMITS SHALL BE OBTAINED FROM THE APPROVED AGENCY BY THE OWNER/CONTRACTOR AT HIS COST.
- 5. THE CONTRACTOR SHALL COORDINATE ALL WORK WITH OTHER SUBCONTRACTORS, PG&E, PACIFIC BELL AND OTHER PARTICIPANT ENTITIES.
- 6. FIELD VERIFY ALL WORK AND DIMENSIONS PRIOR TO CONSTRUCTION.
- 7. USE 2X4 STUDS @ 16" O.C. DF#2, AND AN EXTRA STUD UNDER TRUSS.
- 8. FINGER JOINTED STUDS IN STRUCTURAL WALLS (BEARING OR SHEAR) SHALL BE APPROVED AND ARE NOT ALLOWED AT HOLDDOWN LOCATIONS.
- 9. ALL SLIDING GLASS DOORS, SHOWER DOORS AND TUB ENCLOSURES SHALL BE TEMPERED GLASS AND LABELED SAFETY GLAZING. ALL WINDOWS SHALL MEET THE MINIMUM STANDARD AS ESTABLISHED BY THE CRC.
- 10. PROVIDE AN EXHAUST FAN CAPABLE OF PROVIDING 75 CFM TO REST ROOMS.
- 11. FLASH ALL EXTERIOR OPENINGS W/CL OR ALUMINUM ON KRAFT PAPER OR 15# FELT, SO AS TO BE TOTALLY WATER PROOF AS PER CBC 1402.
- 12. PROVIDE SMOKE DETECTORS AT ALL BEDROOMS & HALLWAYS AS REQUIRED (MIN. 3' FROM AC RETURN/VENTS).
- 13. NAILING SHALL MEET REQUIREMENTS OF CBC TABLE 2304.9.1. CRC R602.3(i)

ADDITIONAL NOTES:

- 1. JOB CARDS TO BE AVAILABLE FOR SIGNATURE AT JOB SITE.
- 2. PROVIDE A DIMENSIONED COPY OF THE FLOOR PLAN FOR THE COUNTY ASSESSOR'S OFFICE.
- 3. PROVIDE CERTIFICATE OF COMPLIANCE OR OTHER CERTIFICATE OF FEES PAID FROM THE SCHOOL DISTRICT HAVING JURISDICTION OVER THE SITE FOR PROPOSED CONSTRUCTION.
- 4. ADDRESS NUMBERS TO BE VISIBLE FROM THE ROAD WITH NUMERALS THAT ARE 3" HIGH OR HIGHER.
- 5. SURFACE WATER SHALL BE DRAINED AWAY FROM THE BUILDING FOR THE FIRST 5' BY AT LEAST 2% GRADE. THE OVERALL LOT DRAINAGE MUST BE NOT LESS THAN 1%.
- 6. A FIRE ESCAPE WINDOW SHALL BE PROVIDED IN EVERY BEDROOM WHERE THERE IS NOT A DOOR TO THE EXTERIOR WITH A SILL HIGH OF NOT MORE THAN 44" ABOVE THE FLOOR. SUCH WINDOW SHALL HAVE A CLEAR OPERABLE AREA OF NOT LESS THAN 5.7 SQ. FT. WITH NO DIMENSION LESS THAN 24" IN HEIGHT OR 20" IN WIDTH THAT WILL OPEN ONTO A STREET, ALLEY, YARD OR EXTERIOR COURT.
- 7. MINIMUM FINISHED WIDTH FOR A CORRIDOR IS NOT LESS THAN 36".
- 8. WATER CLOSET (TOILET) COMPARTMENT MUST HAVE NOT LESS THAN 15" CENTERLINE OF BODET TO RIM AND NOT LESS THAN 24" CLEAR IN FRONT OF THE UNIT AS PER CPC 407.6.
- 9. BETWEEN GARAGE AND RESIDENCE INSTALL MINIMUM 1/2" GYPSUM BOARD ONE-HOUR FIRE-RESISTANT WALLBOARD FROM CONCRETE TO ROOF SHEATHING OF GARAGE SIDE OF ALL COMMON WALLS.
- 10. GLASS WINDOWS AND DOORS THAT ARE SUBJECT TO HUMAN IMPACT, WITH 24" OF DOOR, CLOSER THAN 60" ABOVE AN EXTERIOR WALKING SURFACE OR WITHIN 18" OF AN INTERIOR FLOOR MUST BE TEMPERED GLASS OR REQUIRES A PROTECTIVE GRILL AS PER CRC R308.4.
- 11. WATER HEATERS, FURNACES AND ELECTRIC OUTLETS MUST BE INSTALLED AT LEAST 18" ABOVE GARAGE FLOOR OR CONCRETE SLAB STRAP WATER HEATER FOR SEISMIC BRACING.
- 12. LATH PLASTER SHALL COMPLY WITH SECTION 2512.1.
- 13. PROVIDE WEEP SCREDS NOT LESS THAN 4" ABOVE THE EARTH OR NOT LESS THAN 2" ABOVE PAVED AREAS.
- 14. FOAM TYPE UNDERLAY REQUIRES A WATERPROOF FACING STUCCO. SUBMIT SPECIFICATIONS AND ICC REPORT NUMBER OF TYPE TO BE USED.
- 15. SHOWER STALLS AND TUBS ENCLOSURES TO HAVE SAFETY GLAZING. SHOWER DOORS MAY NOT BE LESS THAN 22" MINIMUM WIDTH.
- 16. MECHANICAL VENTILATION SYSTEMS MUST SUPPLY 5 AIR CHANGES PER HOUR IN BATH AND LAUNDRY ROOMS.
- 17. PROVIDE 12" SQ. TUB ACCESS OR SOLVENT WELD TUB TRAP JOINTS PER CPC.
- 18. PROVIDE BACKDRAFT DAMPERS TO ALL VENTS TO THE OUTSIDE.
- 19. DISTANCE BETWEEN RANGE TOP AND CABINET ABOVE SHALL NOT BE LESS THAN 30" UNPROTECTED, 24" PROTECTED AND NOT LESS THE RANGE MANUFACTURERS SPECS. FOR HORIZONTAL DISTANCE (OR MIN. 6" IF NOT SPECIFIED).
- 20. WATERPROOF GYPSUM BOARD UNDERLAY AT SHOWERS, TUBS AND OTHER SURFACES ADVERSELY AFFECTED BY WATER IS NOT ALLOWED AS PER G.A-216 OR ASTM C840.
- 21. INTERIOR WALL SURFACES TO BE 1/2" GYPSUM WALLBOARD (FLAMESPREAD GLASS III OR BETTER) UNLESS SPECIFIED OTHERWISE.
- 22. BUGSCREEN TO BE INSTALLED PRIOR TO FINAL INSPECTION.
- 23. NEW ROOFING TO BE CLASS "C" ROOF COVERING OR BETTER. THE INSTALLER SHALL PROVIDE A CERTIFICATION TO THE BUILDING DIVISION PRIOR TO FINAL INSPECTION.



NO.	DESCRIPTION	BY	DATE
1	CORRECTION FROM DESIGN REVIEW 1		10.12.16
2	CORRECTION FROM DESIGN REVIEW 2		11.16.16

FLOOR PLAN NOTES & CAL GREEN NOTES
SHEET TITLE:

PROJECT DESCRIPTION:
1314 Lillian Ave., SUNNYVALE, CA. 94087

JF CONSULTING
3001 S. Winchester Blvd., #8 Campbell, CA. 95008 TEL: 408.512.8400 - Email: JFPPLANS@GMAIL



11/17/2016
SHEET:
A-11

Solar Access & Shadow Analysis


PM Analysis

SHADOW AREA CALCULATION


TOTAL ROOF AREA OF BUILDING A : 3297 SQ.FT.
TOTAL SHADOW AREA: 10.18 SQ.FT.
TOTAL % OF AREA OF SHADOW : 10.18/3297 =0.30%

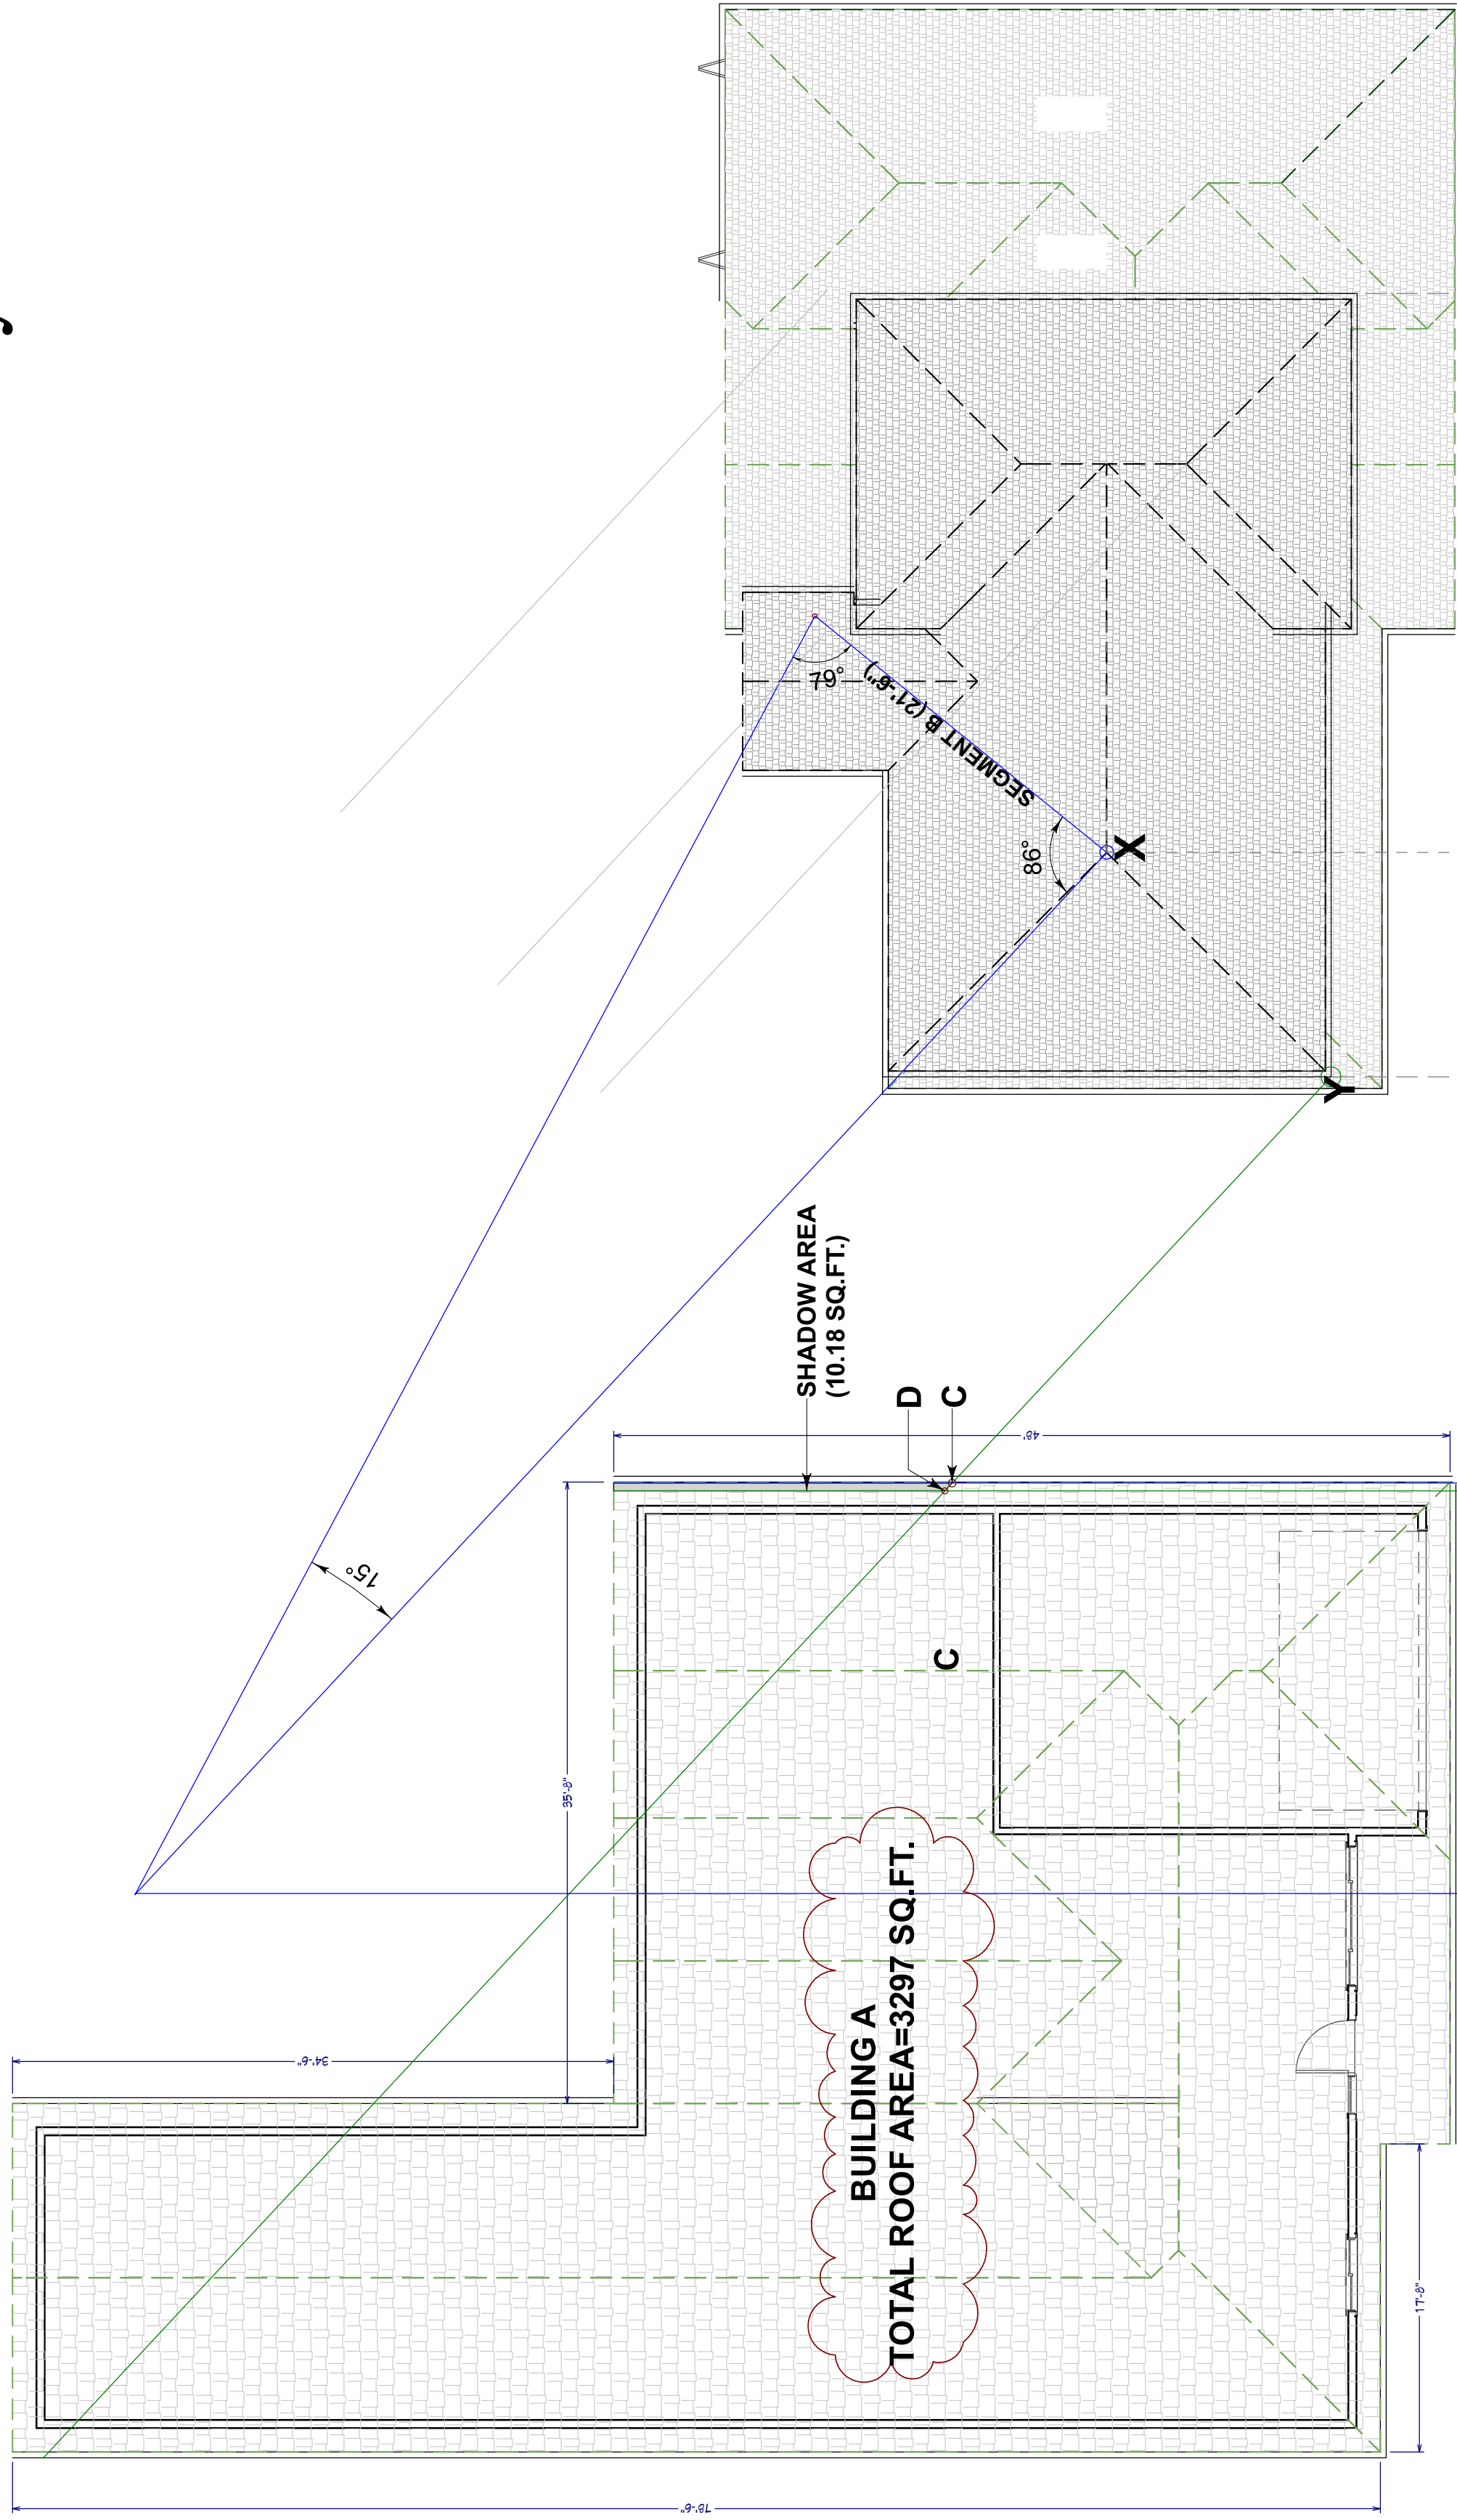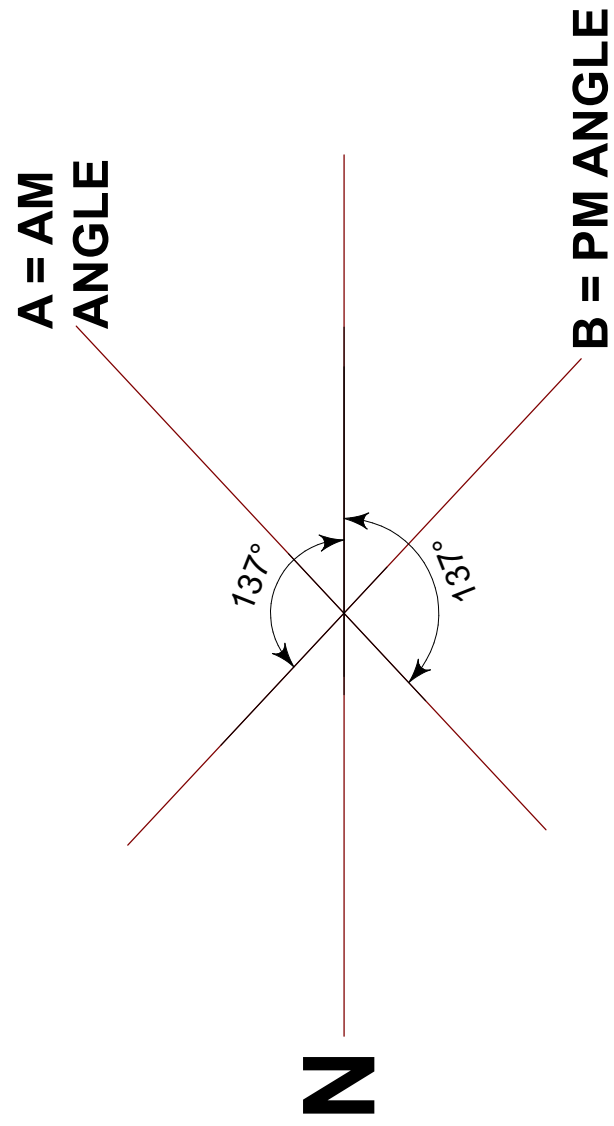


ADJACENT BUILDING -A- ROOFING PLAN
SCALE 1/8"=1'-0"

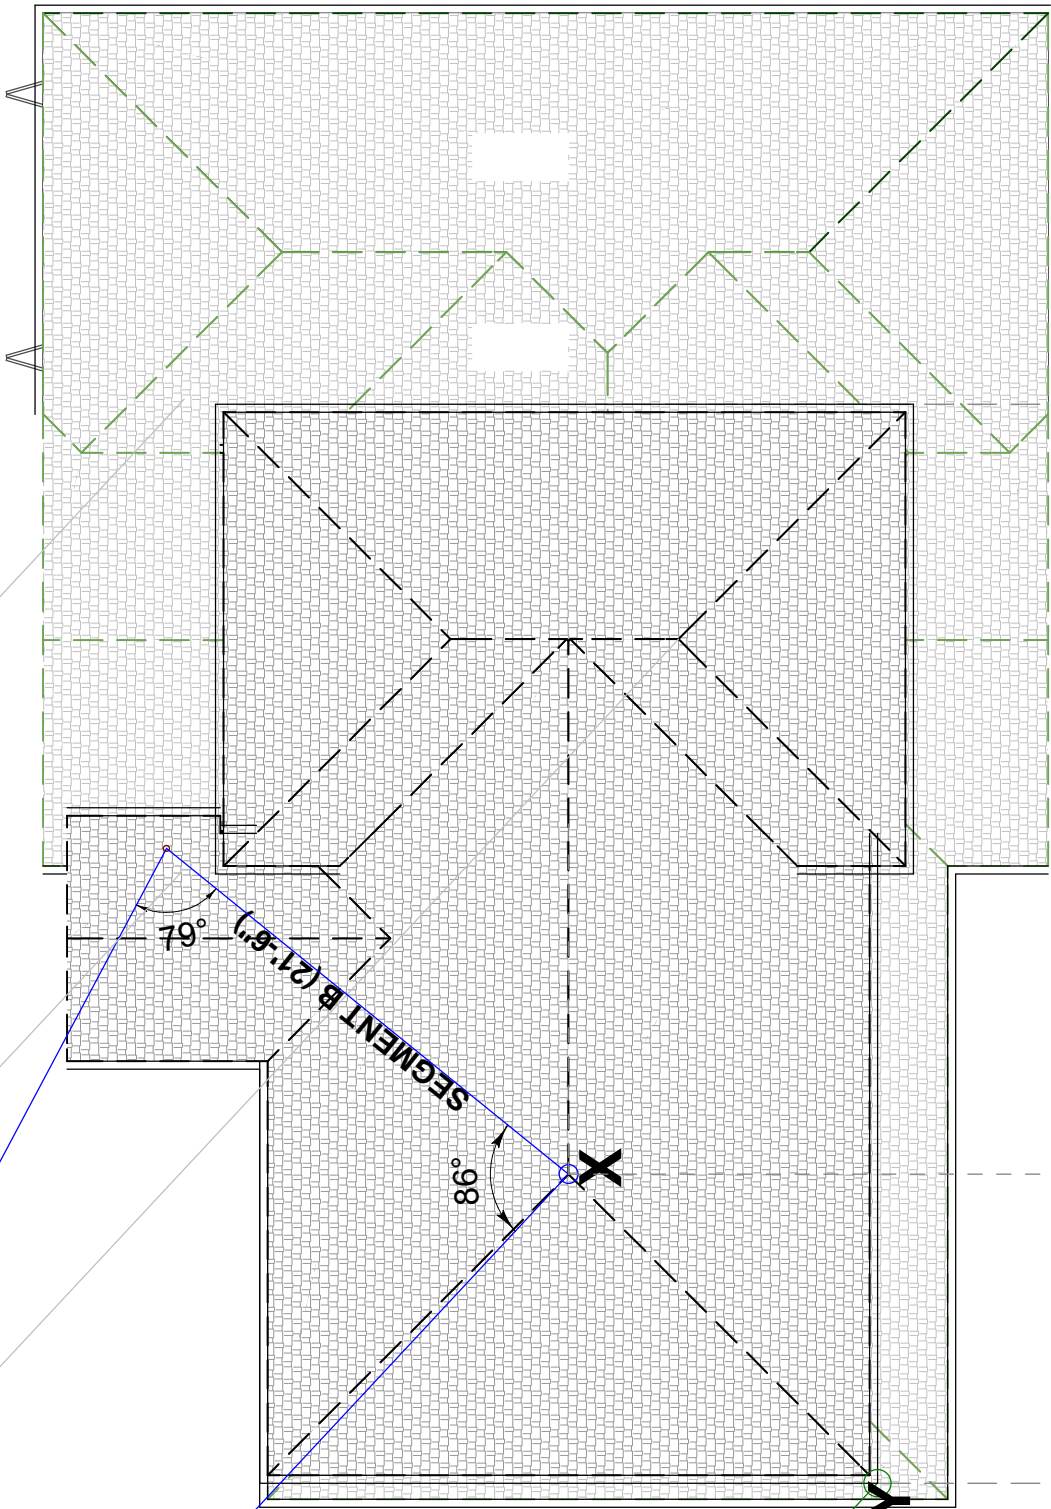


PROPOSED BUILDING ROOFING PLAN
SCALE 1/8"=1'-0"

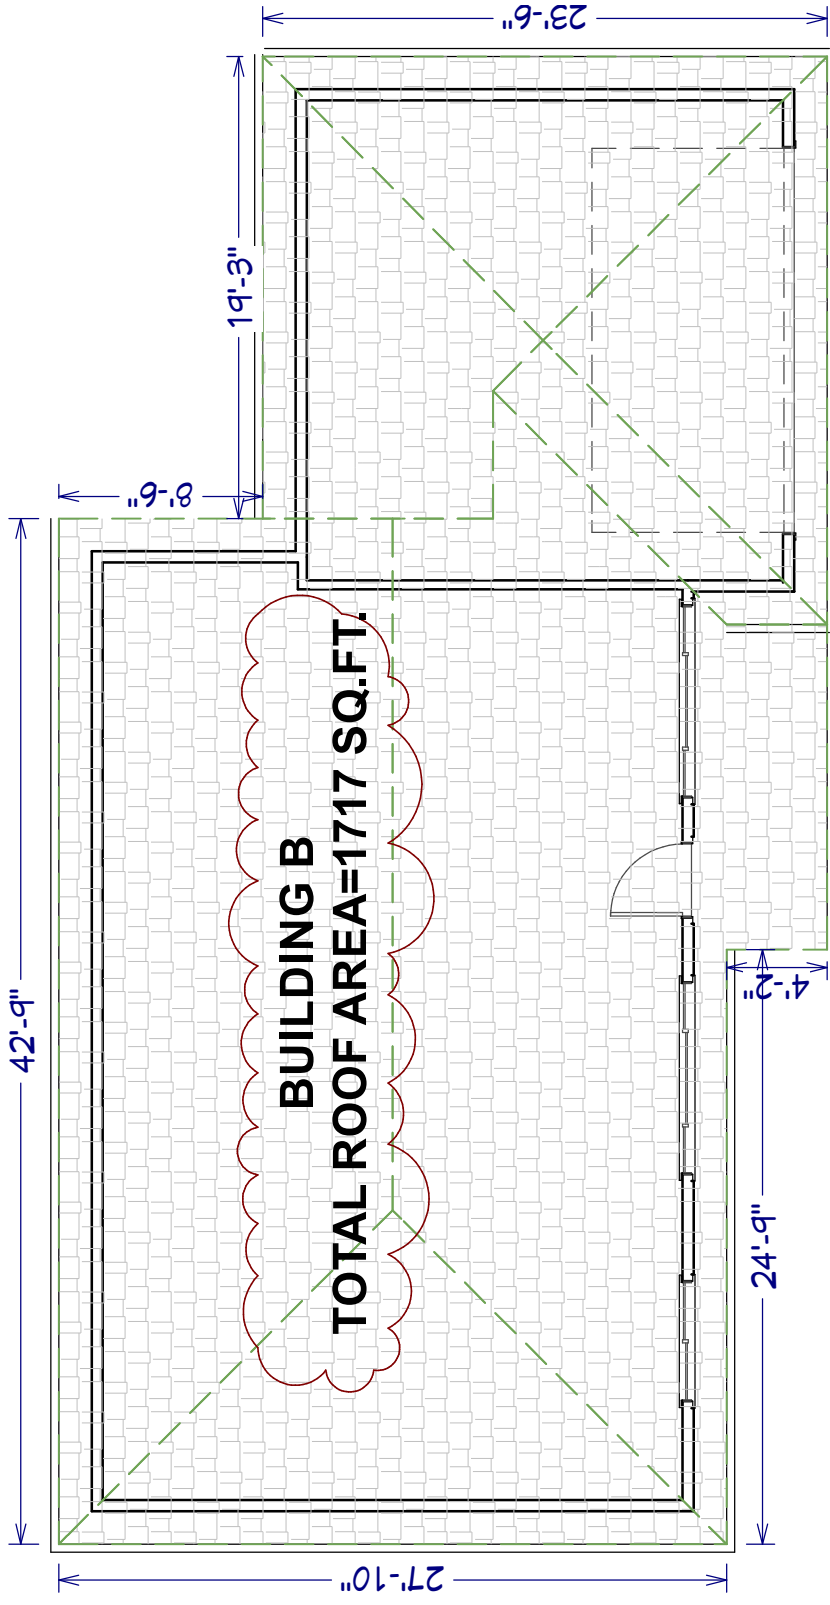

ADJACENT BUILDING -B- ROOFING PLAN
SCALE 1/8"=1'-0"

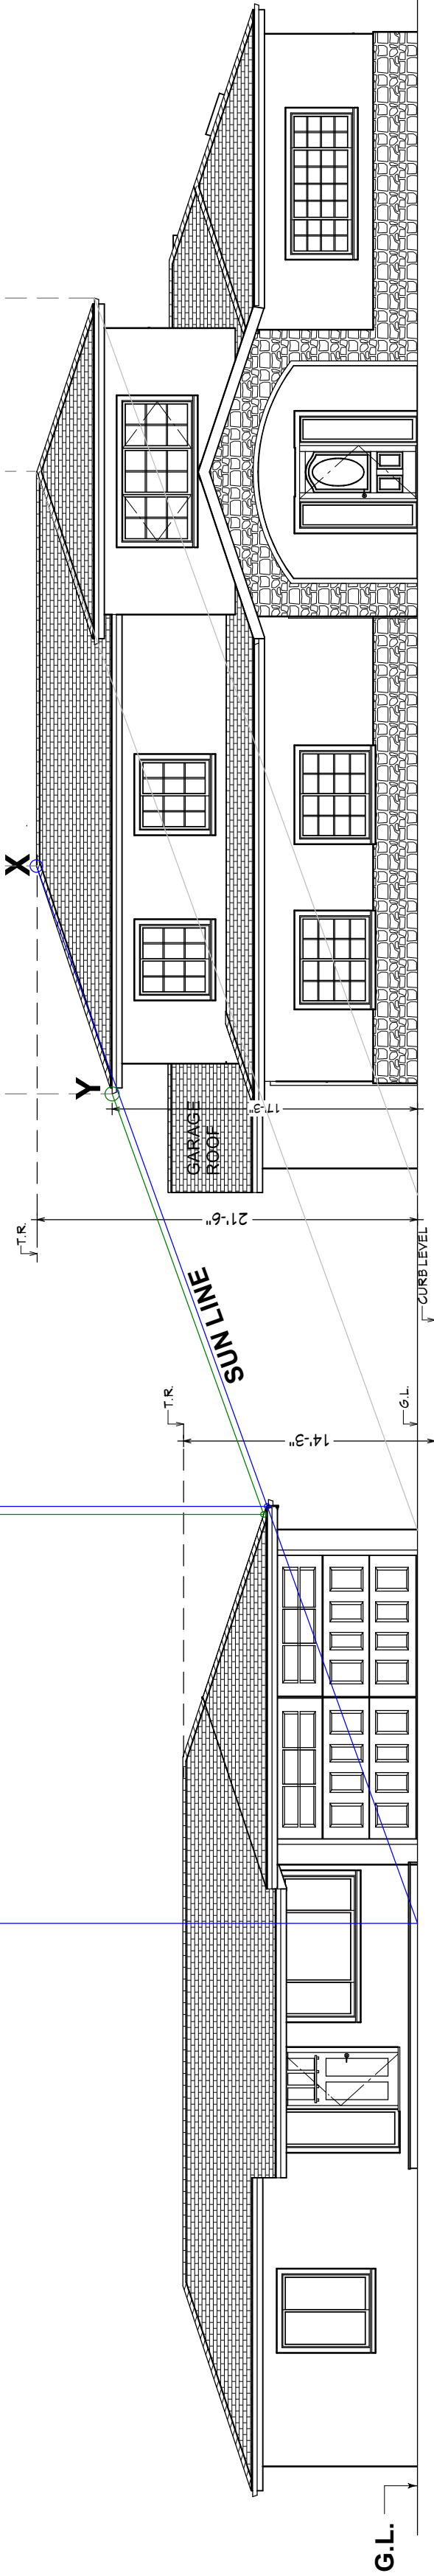

ADJACENT BUILDING -A- FRONTELEVATION
SCALE 1/8"=1'-0"

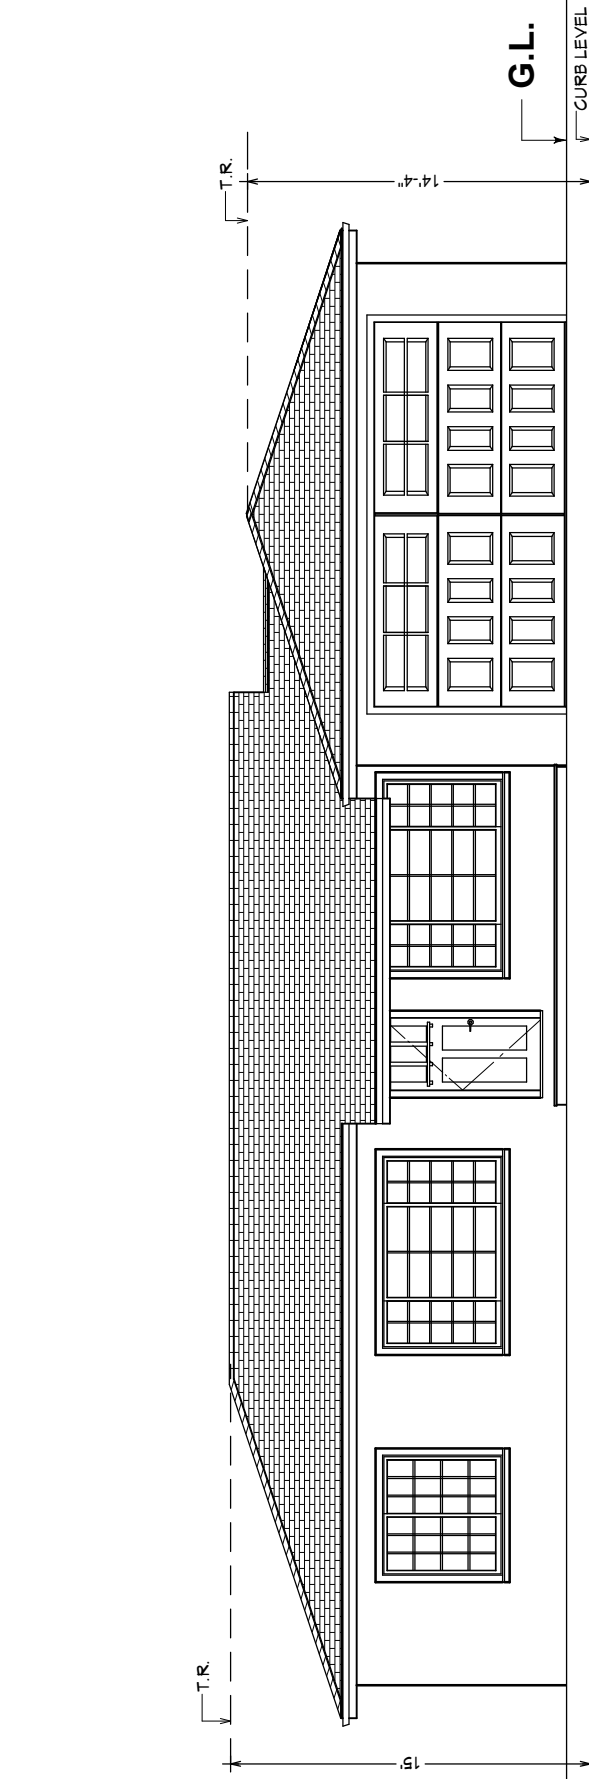

ADJACENT BUILDING -B- FRONTELEVATION
SCALE 1/8"=1'-0"

	PROJECT DESCRIPTION:	
	1314 Lillian Ave., SUNNYVALE, CA 94087	
SHEET TITLE:		ADDITION & REMODELING
NO.		DESCRIPTION
1		CORRECTION FROM DESIGN REVIEW 1
2		CORRECTION FROM DESIGN REVIEW 2
BY		DATE
11.16.16		10.12.16

PROJECT DESCRIPTION:	
1314 Lillian Ave., SUNNYVALE, CA 94087	
SHEET TITLE:	
NO.	
1	
2	
BY	
11.16.16	
10.12.16	

PROJECT DESCRIPTION:	
1314 Lillian Ave., SUNNYVALE, CA 94087	
SHEET TITLE:	
NO.	
1	
2	
BY	
11.16.16	
10.12.16	

PROJECT DESCRIPTION:	
1314 Lillian Ave., SUNNYVALE, CA 94087	
SHEET TITLE:	
NO.	
1	
2	
BY	
11.16.16	
10.12.16	

PROJECT DESCRIPTION:	
1314 Lillian Ave., SUNNYVALE, CA 94087	
SHEET TITLE:	
NO.	
1	
2	
BY	
11.16.16	
10.12.16	



PROJECT DESCRIPTION:	
1314 Lillian Ave., SUNNYVALE, CA 94087	
SHEET TITLE:	
NO.	
1	
2	
BY	
11.16.16	
10.12.16	

Solar Access & Shadow Analysis


AM Analysis

SHADOW AREA CALCULATION

TOTAL ROOF AREA OF BUILDING A: 3297 SQ.FT.
TOTAL SHADOW AREA: 7SQ.FT.
TOTAL % OF AREA OF SHADOW: 7/3297 =0.21%

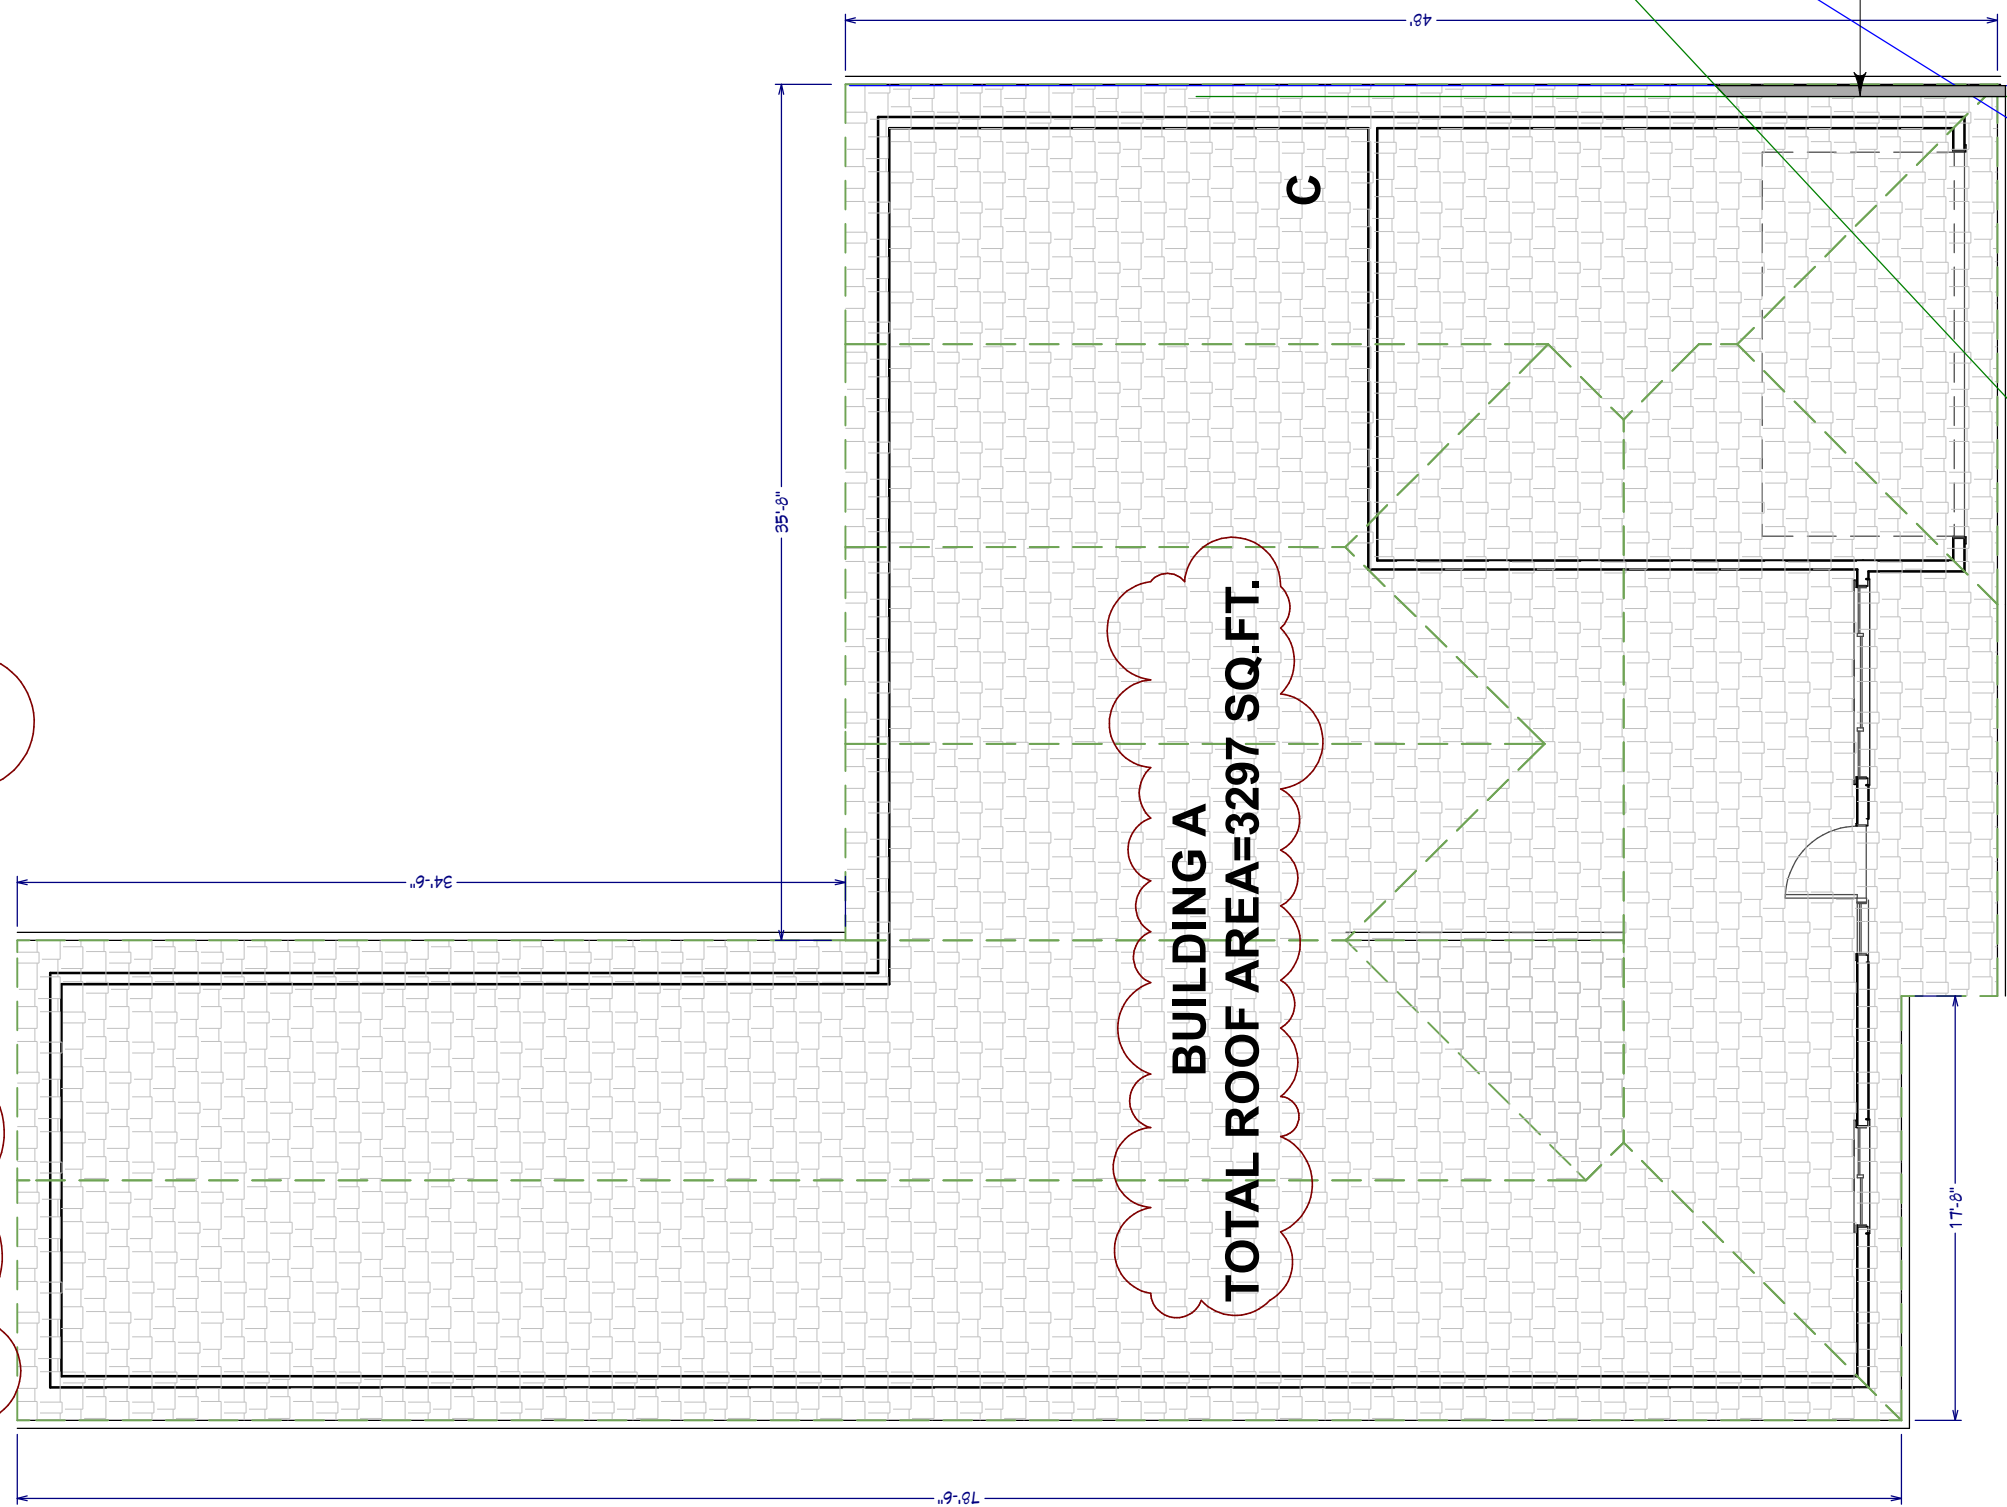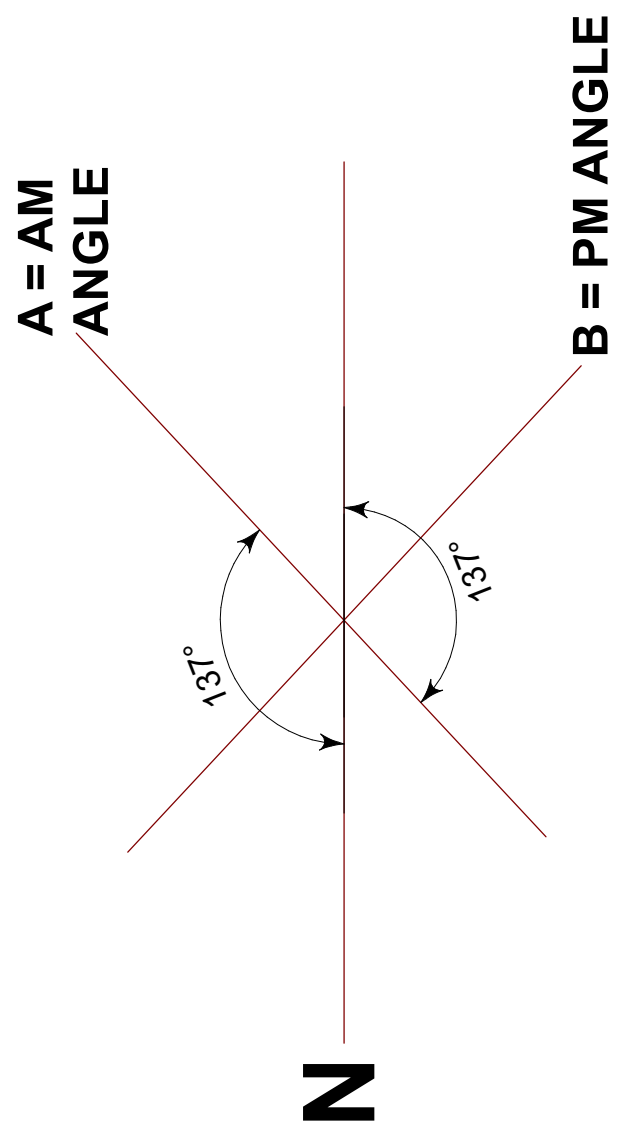


ADJACENT BUILDING - A-ROOFING PLAN
SCALE 1/8"=1'-0"

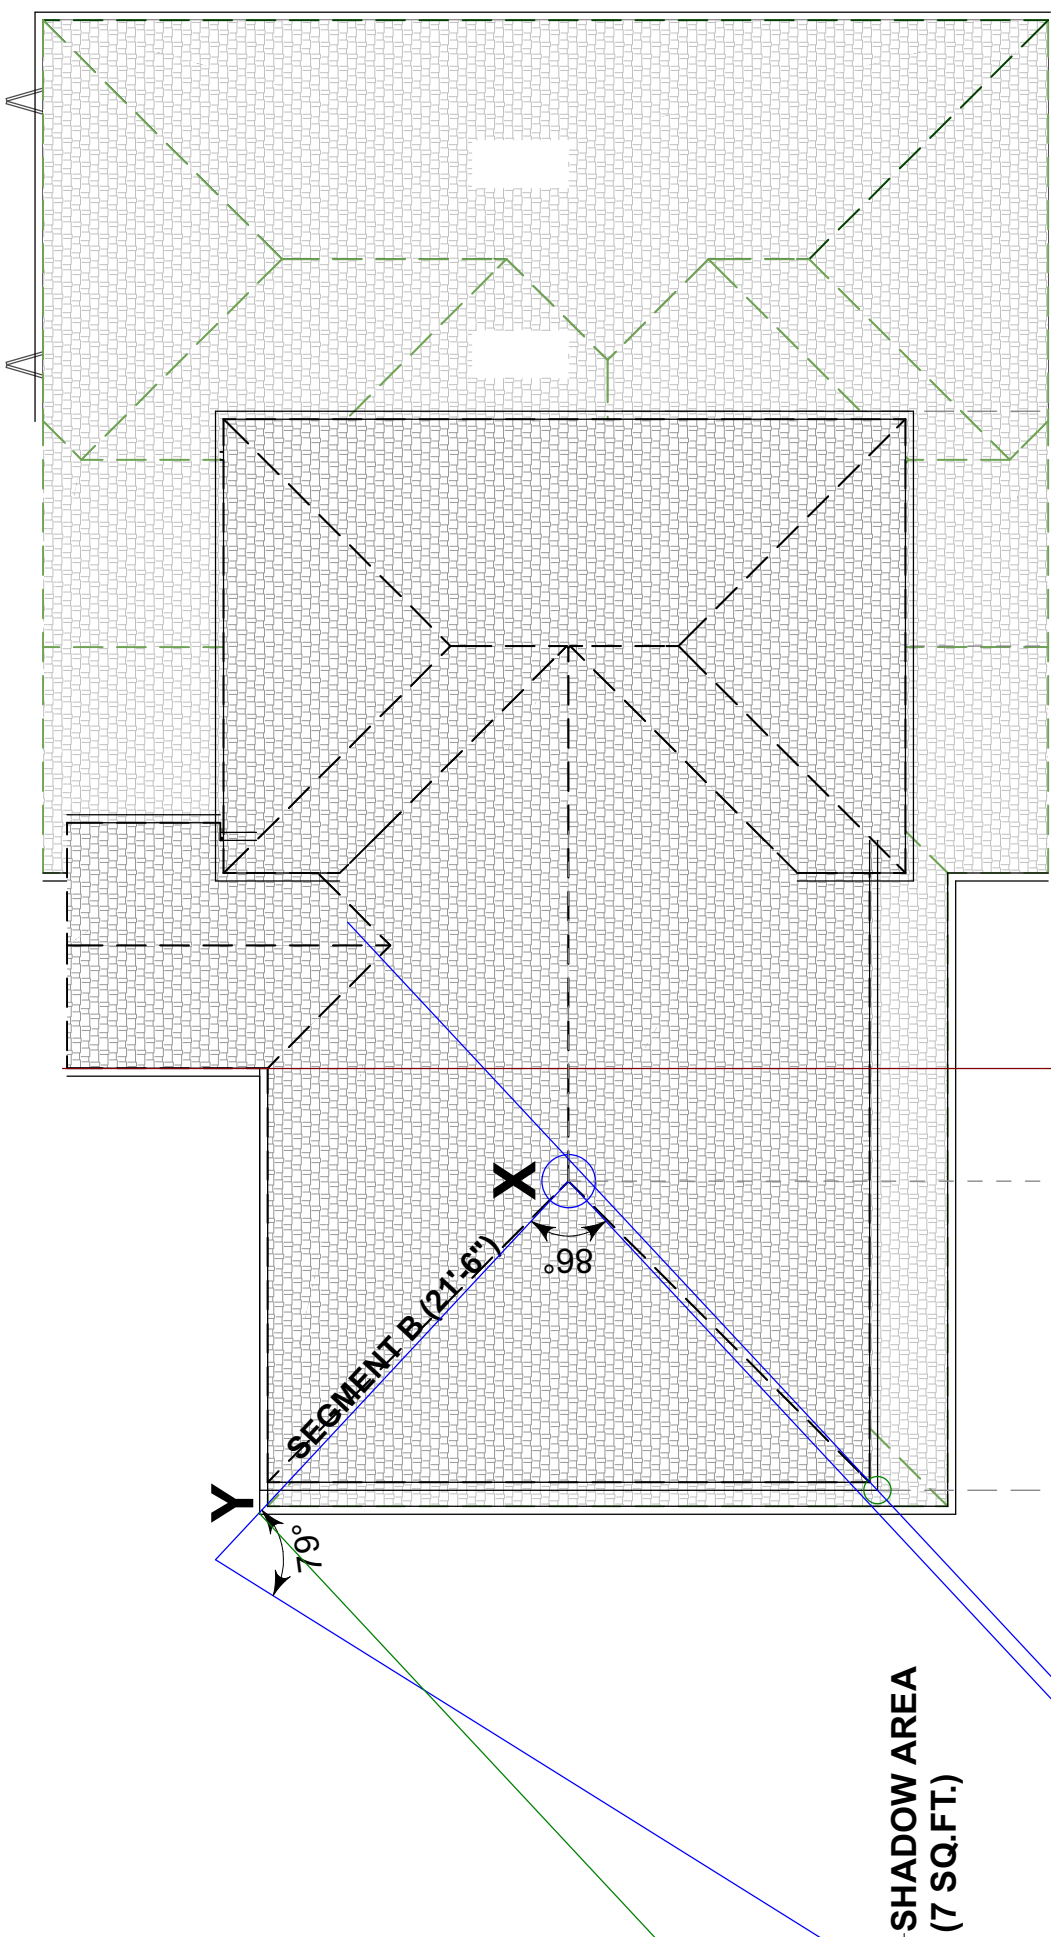


PROPOSED BUILDING ROOFING PLAN


SCALE 1/8"=1'-0"

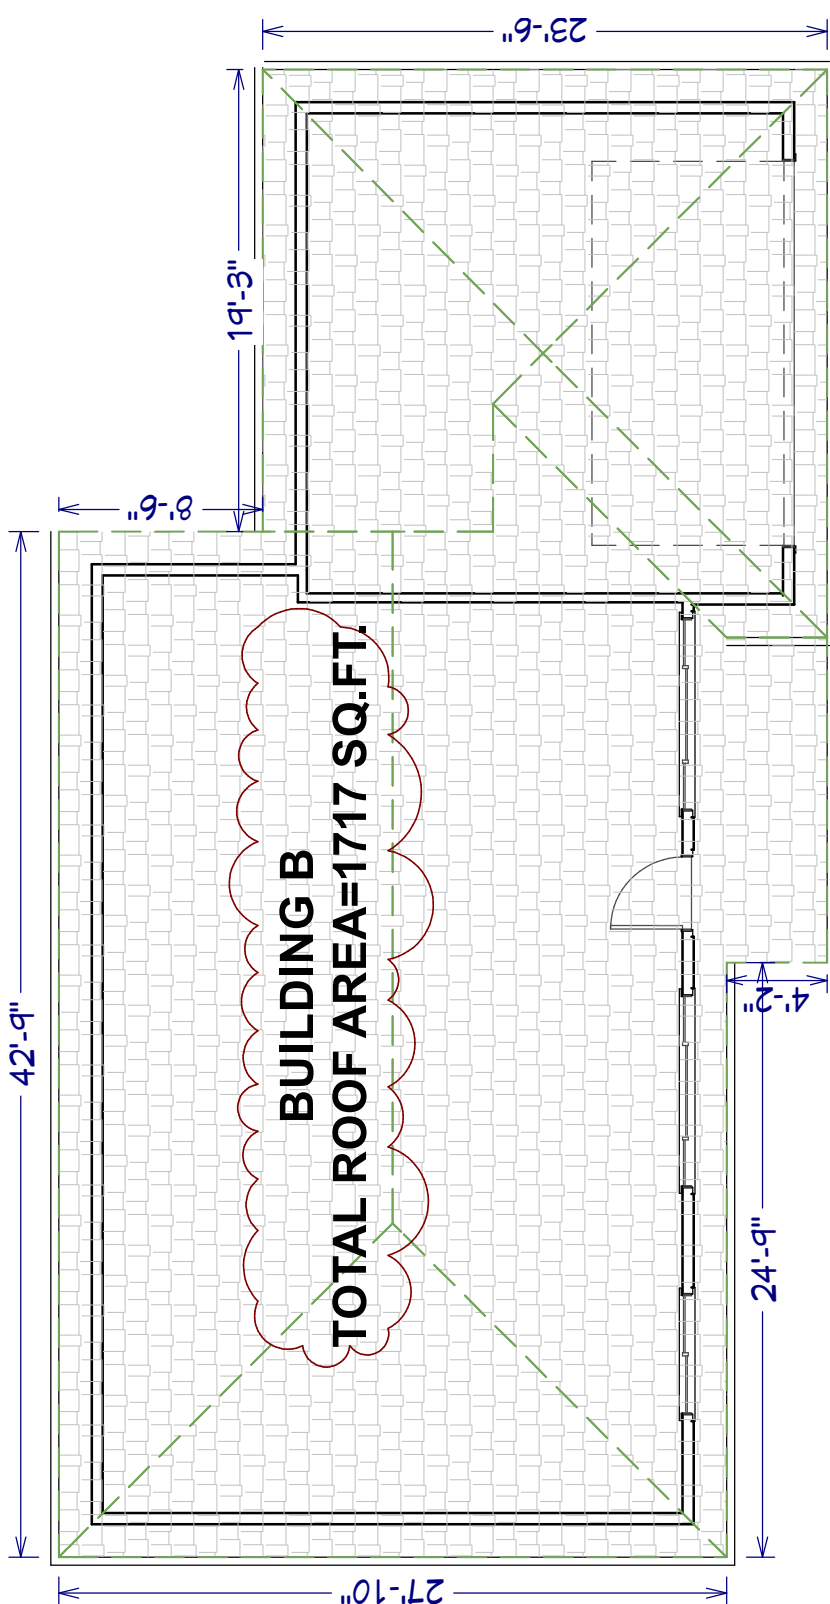

ADJACENT BUILDING - B - ROOFING PLAN
SCALE 1/8"=1'-0"

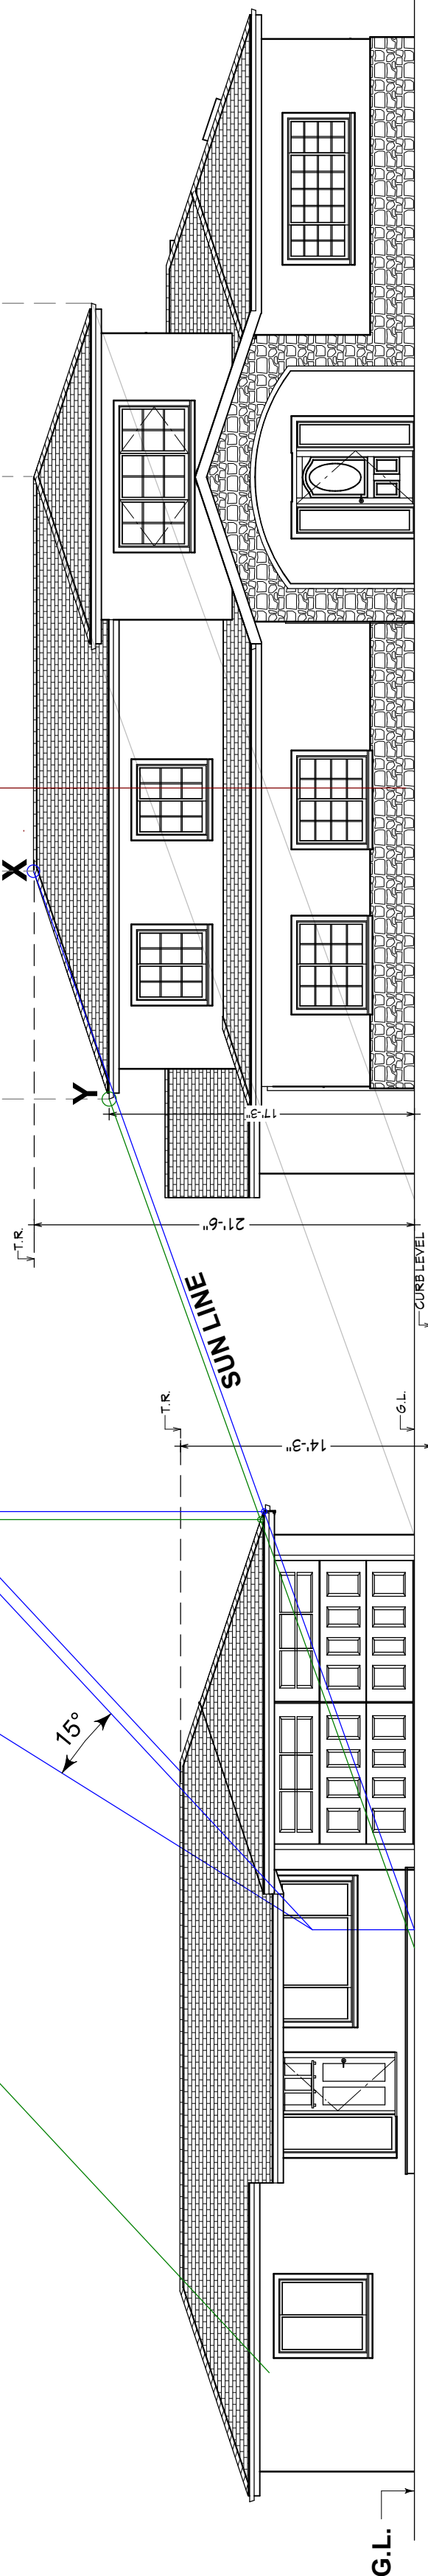

ADJACENT BUILDING- A- FRONTELEVATION
SCALE 1/8"=1'-0"

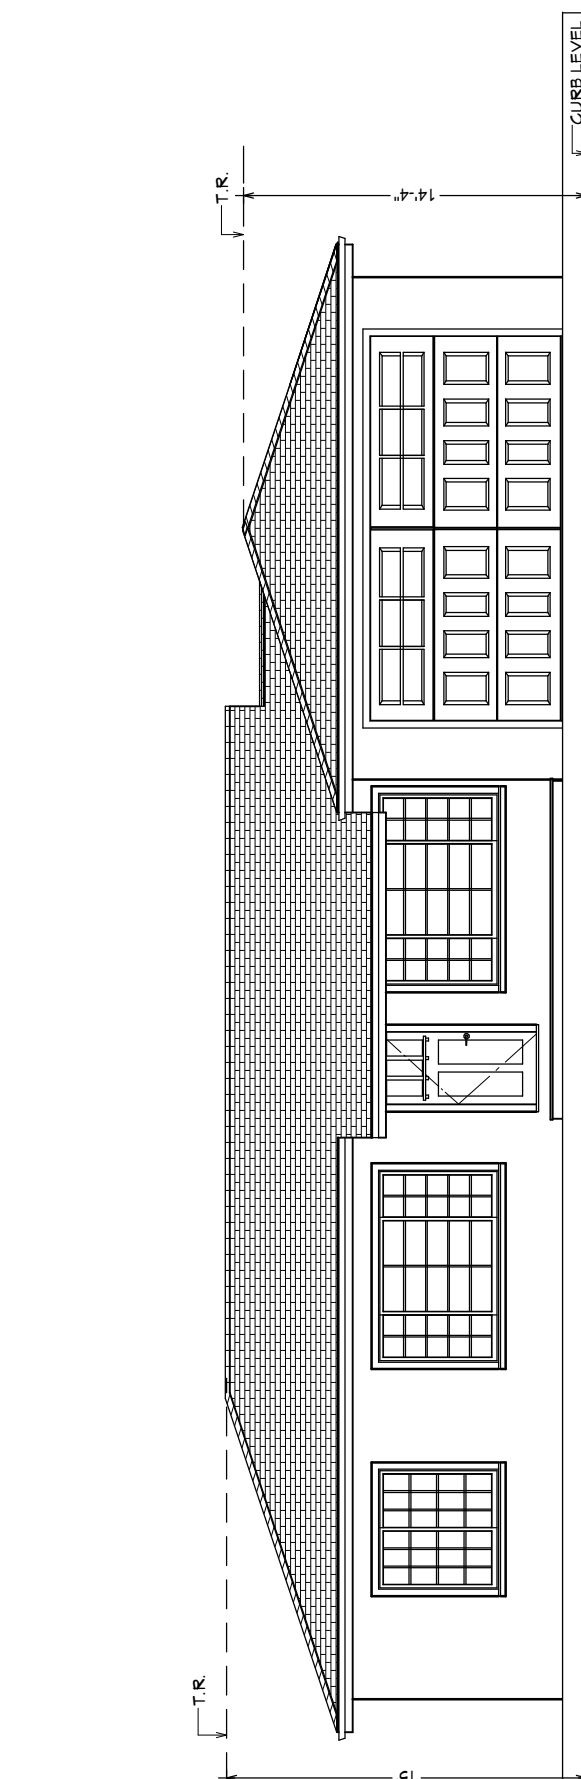

ADJACENT BUILDING- B- FRONT ELEVATION
SCALE 1/8"=1'-0"


NO.	DESCRIPTION	BY	DATE
1	CORRECTION FROM DESIGN REVIEW 1		10.12.16
2	CORRECTION FROM DESIGN REVIEW 2		11.16.16

SHADOW ANALYSIS

PROJECT DESCRIPTION:
 ADDITION & REMODELING
 1314 Lillian Ave.,
 SUNNYVALE, CA 94087

JF CONSULTING
3001 S. Winchester Blvd., #8
Campbell, CA 95008
TEL: 408.512.8400 - E-mail: jfplans@gmail.com

11/17/2016

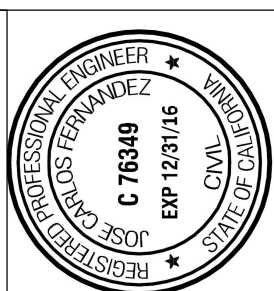

SHEET:

A-13