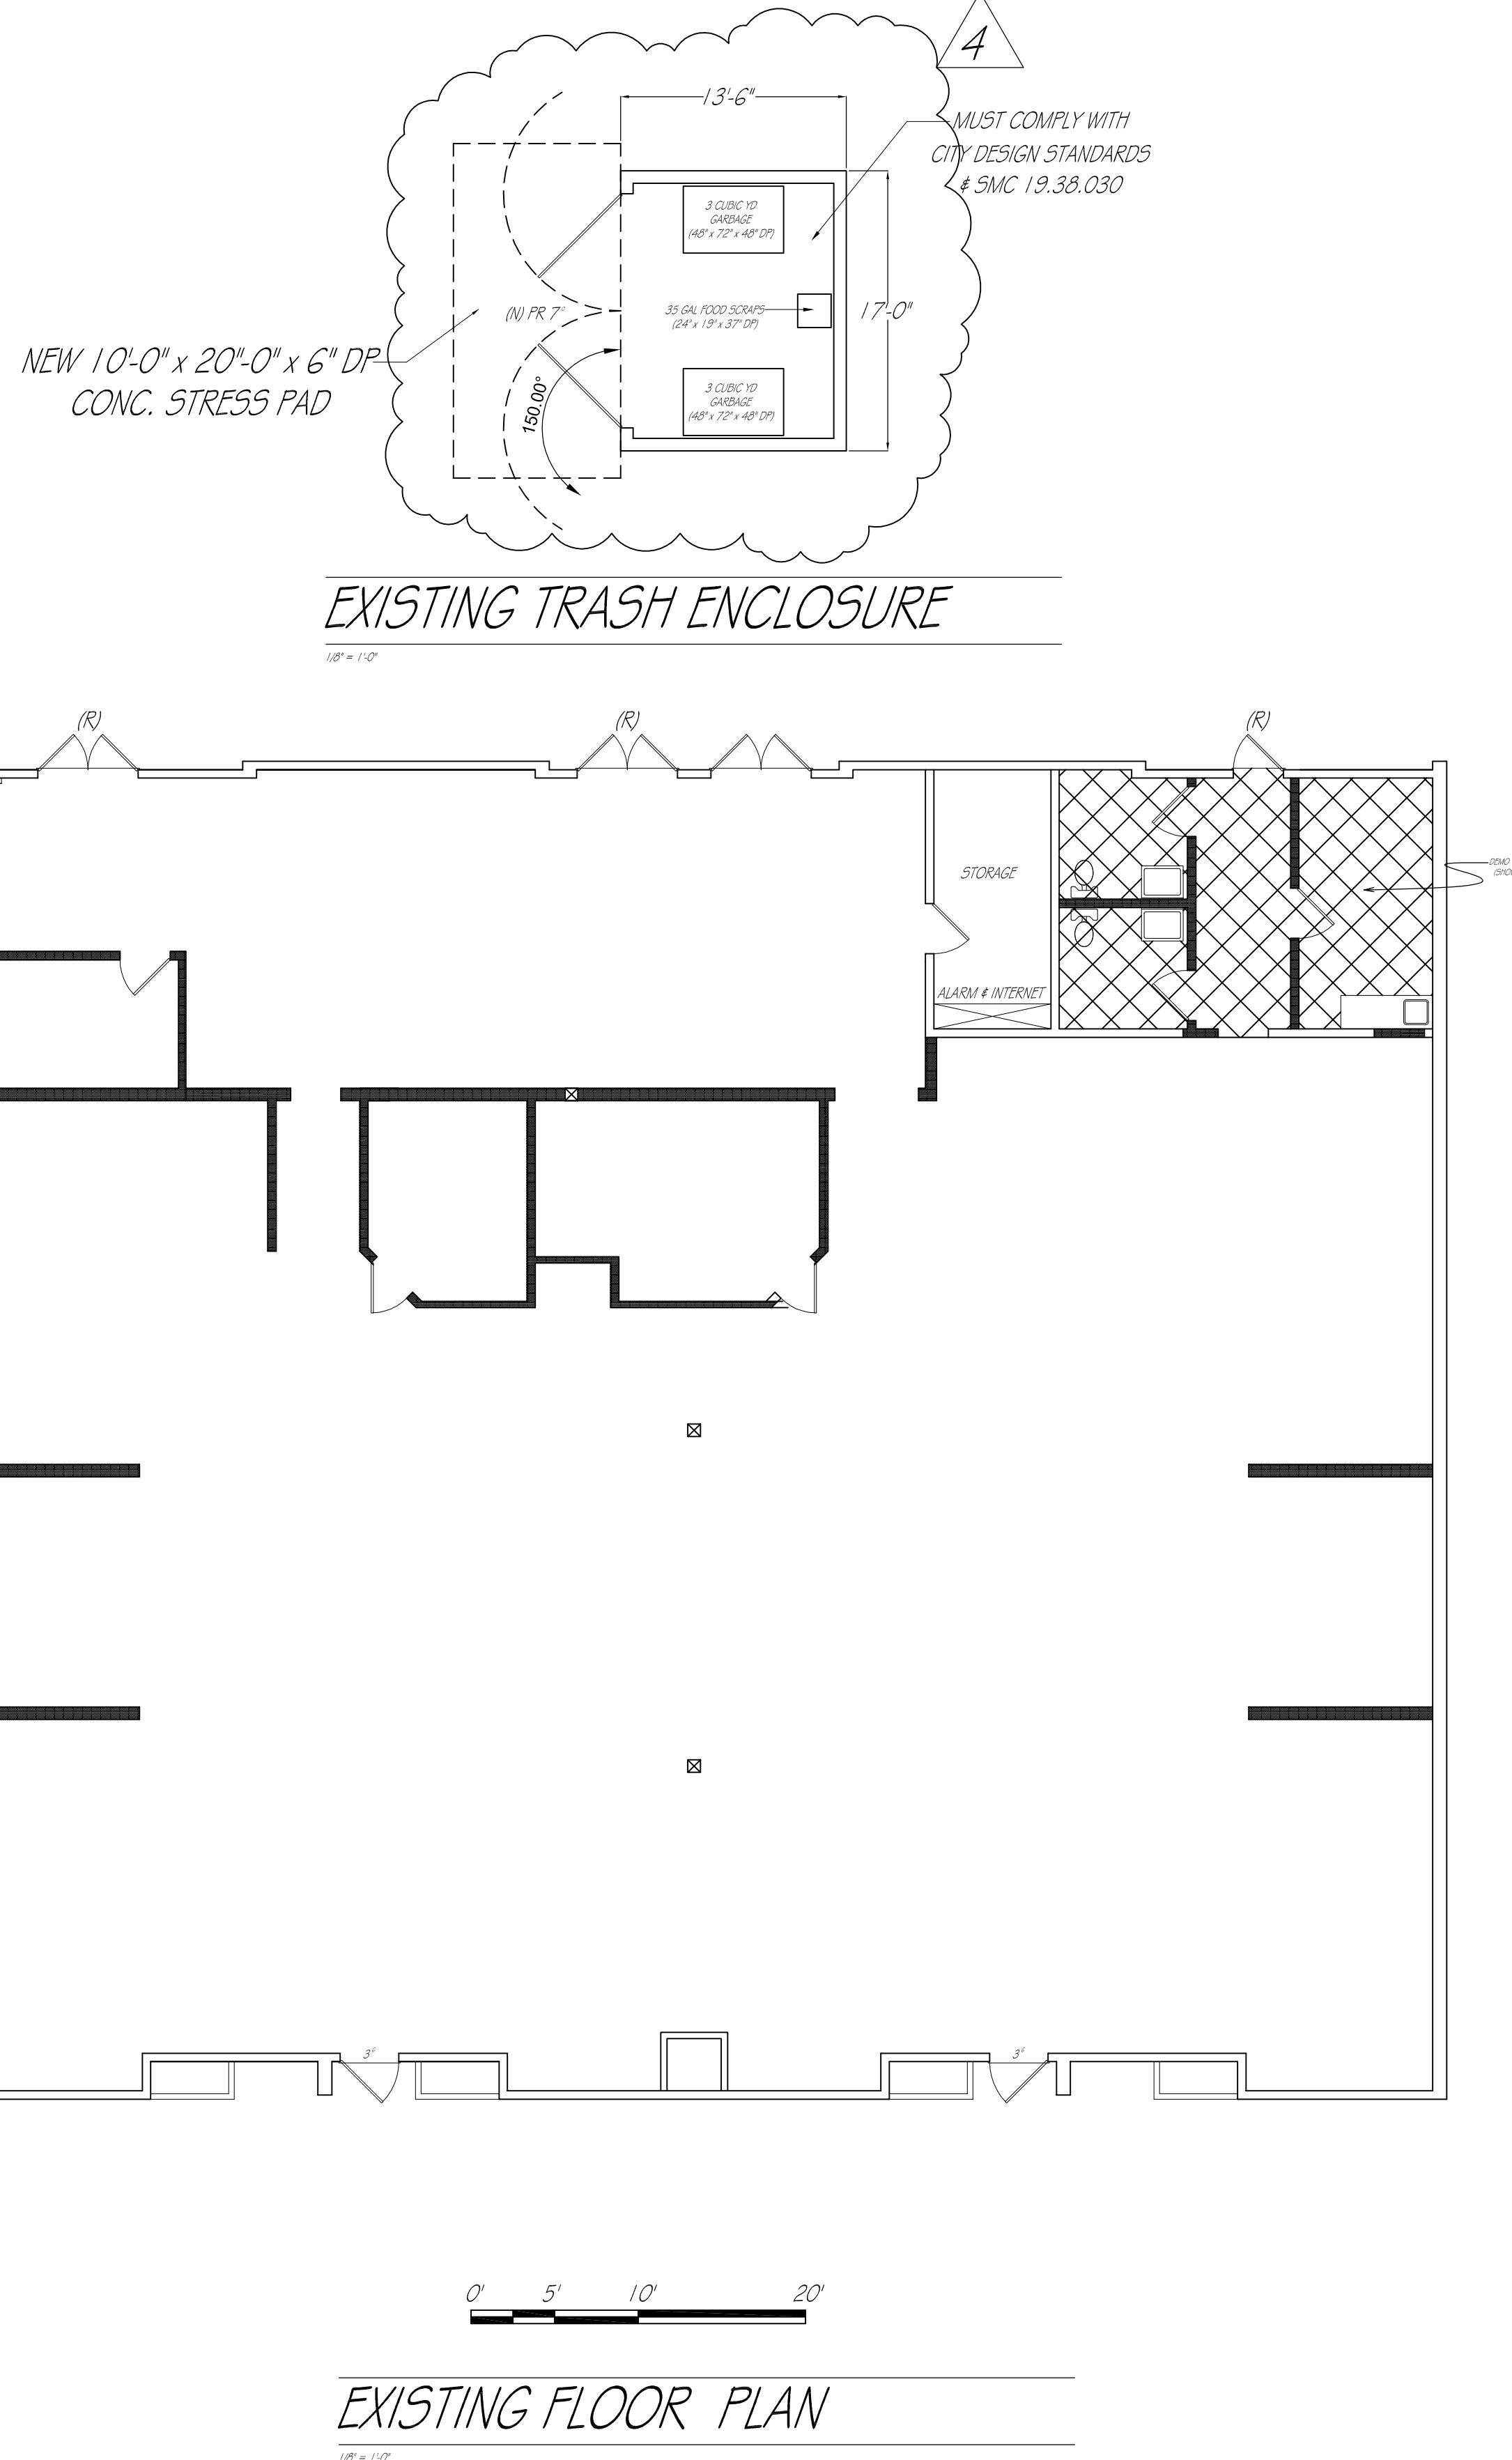
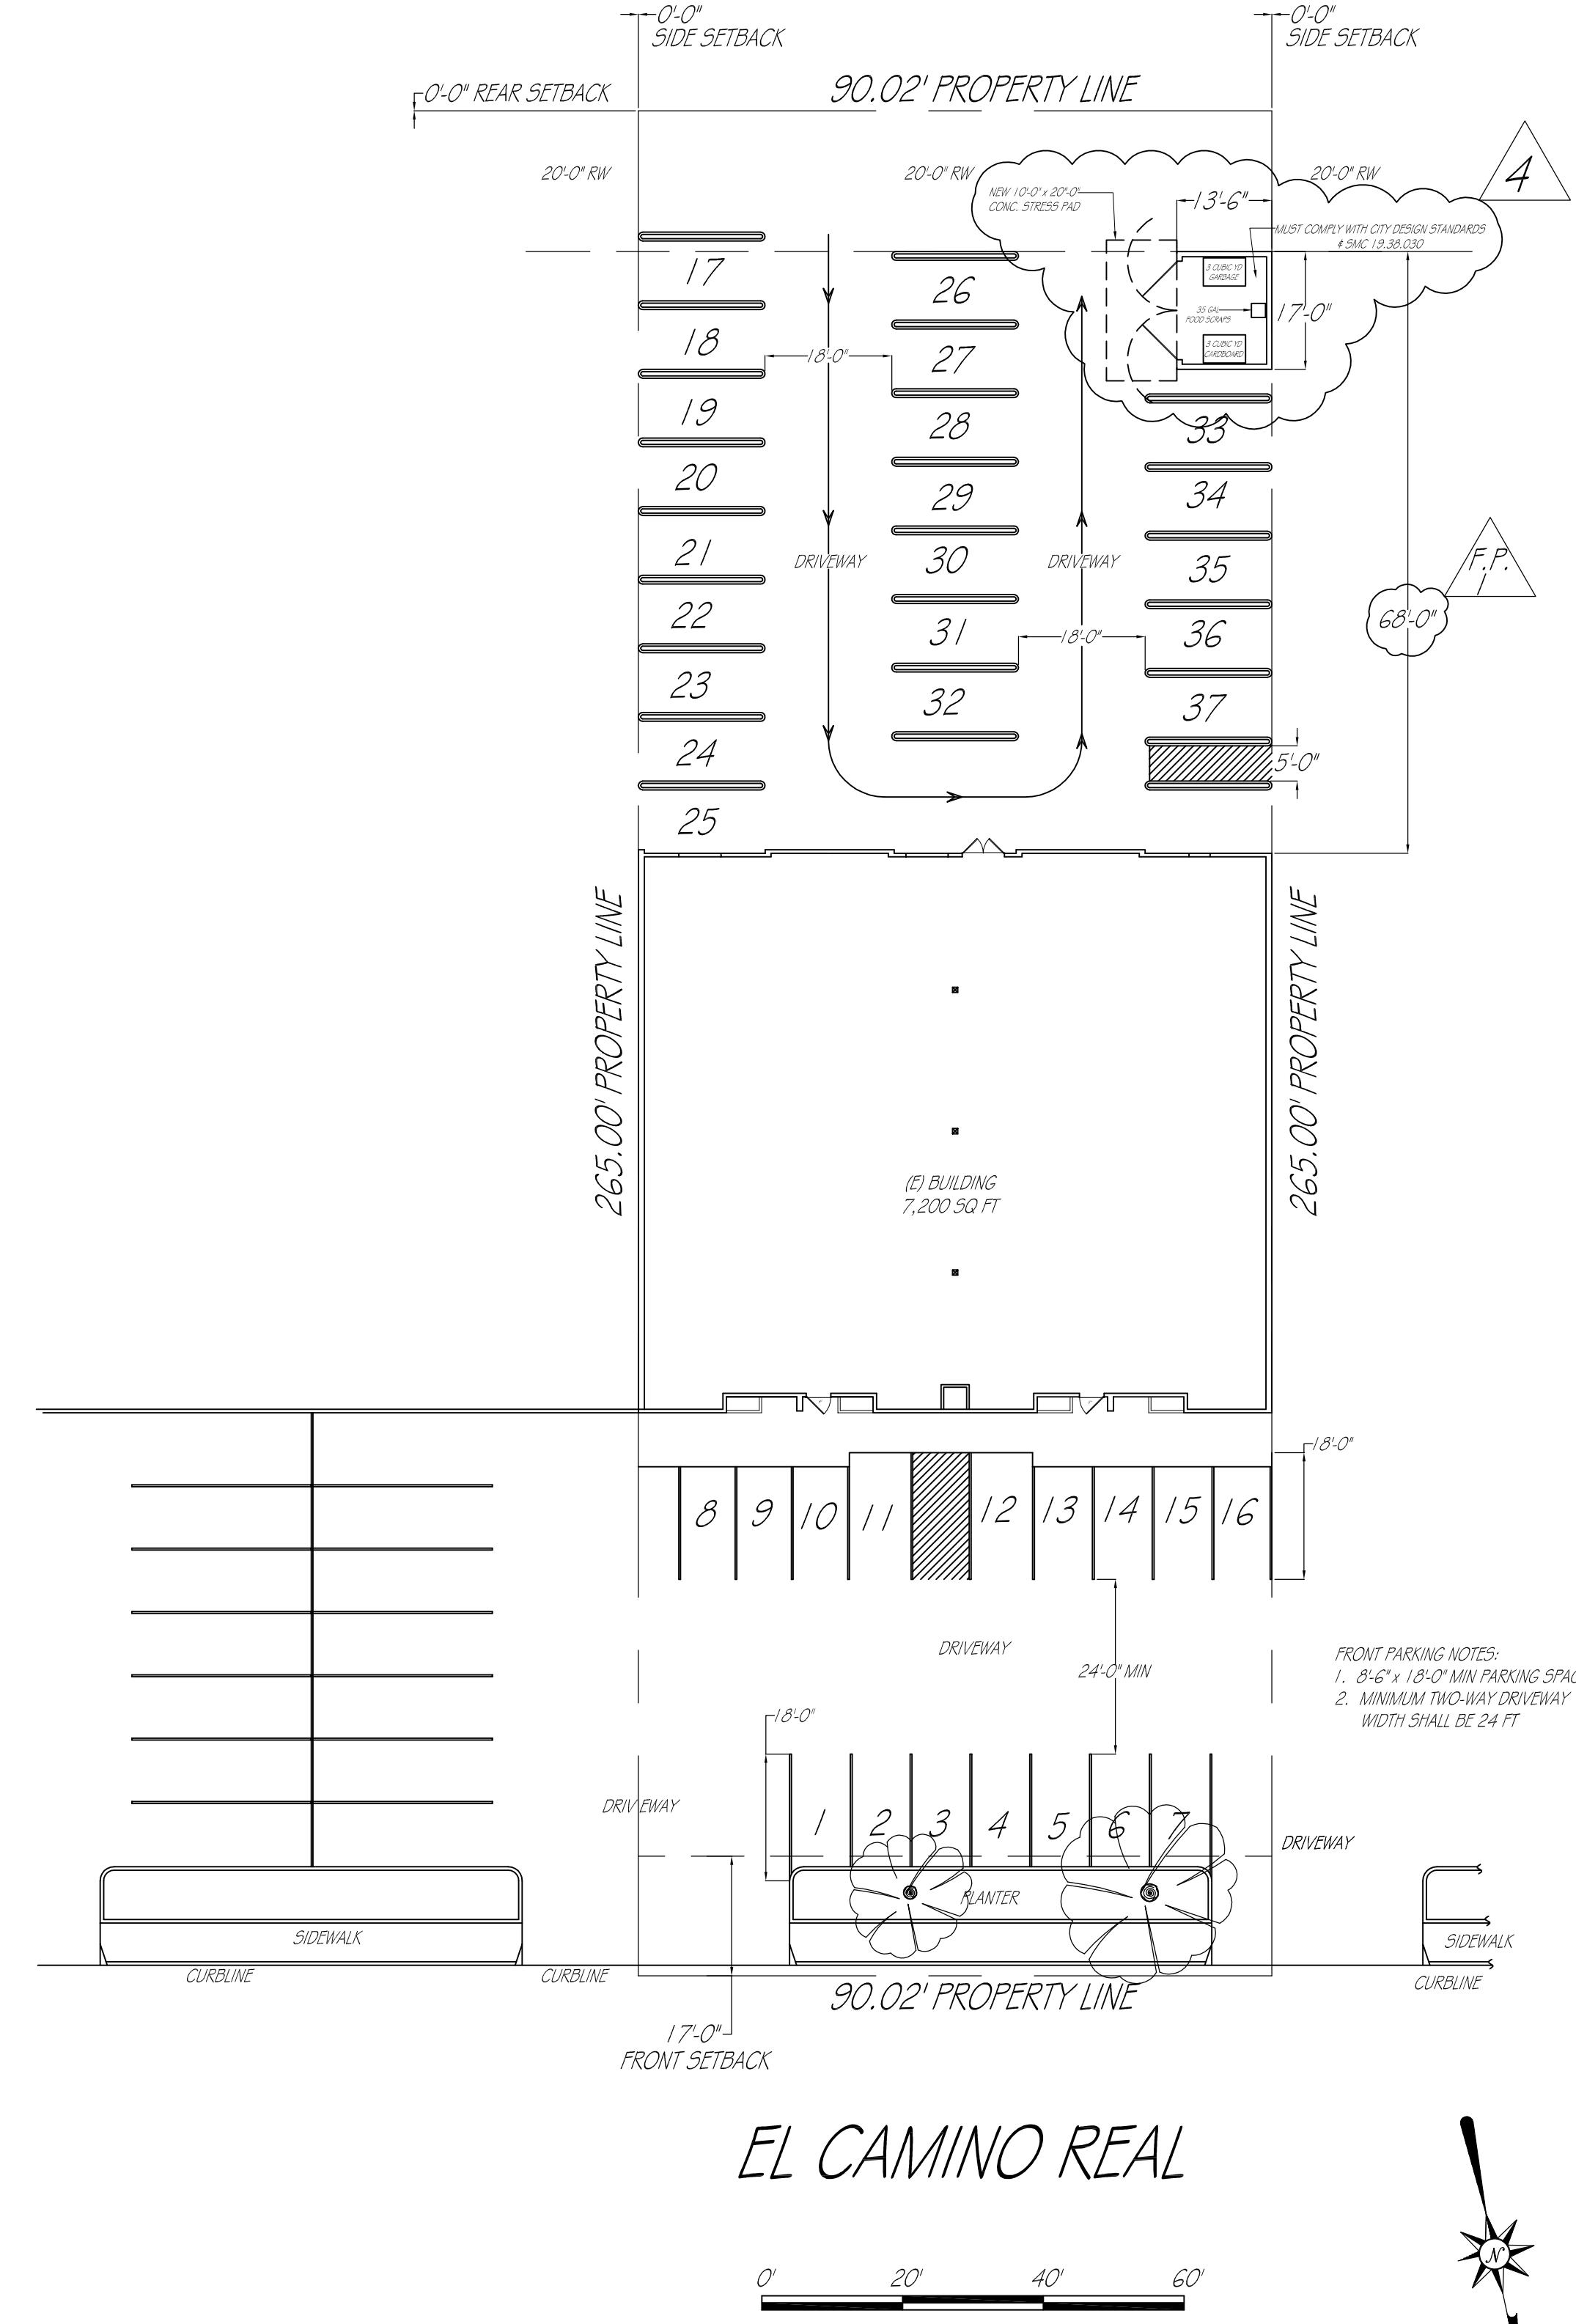


**GENERAL NOTES**


- A. CONSTRUCTION TYPE: VB  
 B. OCCUPANCY CATEGORY: A-3  
 C. HERS VERIFICATION IS REQUIRED IF THE DUCT EXTENSION IS 40FT OR MORE.  
 D. BUILDING DOES HAVE SPRINKERS.

REAR PARKING NOTES:  
 1. 8'-6" x 18'-0" MIN PARKING SPACES  
 2. MINIMUM ONE WAY DRIVEWAY WIDTH SHALL BE 12 FT  
 3. REAR PARKING LOT TO BE REPAVED & RE-STRIPPED  
 4. THE TRASH ENCLOSURE SHALL BE REPAVED & REPAINTED.

**PROPERTY DESCRIPTION**

OWNER: GEORGE ROLLA  
 ADDRESS: 942 W. EL CAMINO REAL  
 SUNNYVALE, CA 94087  
 408-464-3787  
 ZONING: C-2-ECR  
 PARCEL: 201-19-028  
 ACREAGE: .547 ACRE

PROJECT DESCRIPTION: TENANT IMPROVEMENT - BILLIARDS HALL

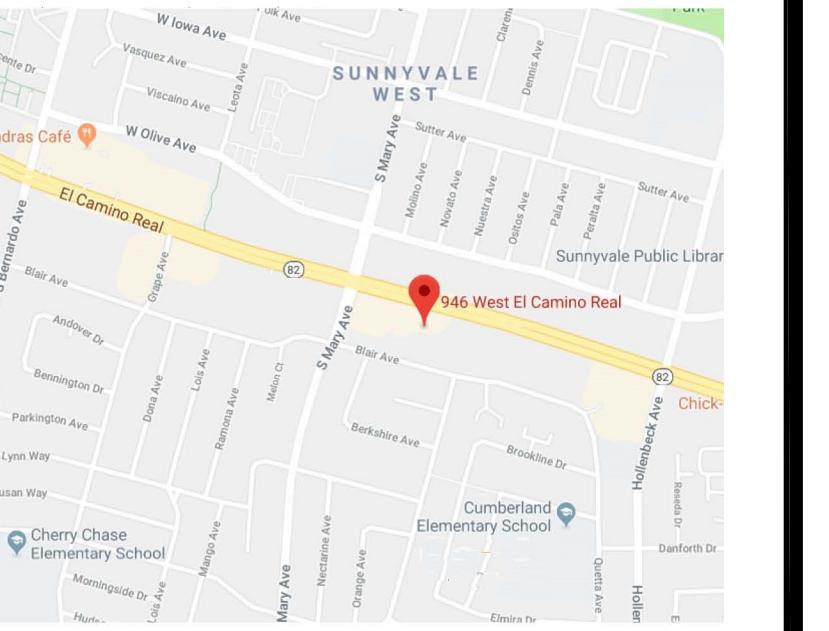**VICINITY MAP**

REVISION	BY
△ 12-02-18 PLAN CHECK COMMENTS	
△ 04-05-19 PLAN CHECK COMMENTS	

DRAWN BY:  
 RICK REYNOLDS  
 BOULDER CREEK, CA 95006  
 408-320-3616  
 EMAIL: PRECISIONFITDESIGNS@YAHOO.COM

**CONSULTANT DIRECTORY**

SURVEYOR: N/A  
 SOILS ENGINEER: N/A  
 STRUCTURAL ENGINEER: N/A  
 ENERGY CONSULTANT: N/A

**ARCHITECTURAL SHEETS**

- 4 A-1.0 SITE / EXISTING PLAN  
 A-1.1 CIRCULATION PLAN  
 A-1.2 LIGHTING PLAN  
 A-1.2a LIGHTING PLAN  
 A-2 PROPOSED FLOOR PLAN  
 A-3 PROPOSED ELECTRICAL PLAN  
 A-4 EXTERIOR ELEVATION PLAN  
 A-5 FRONT ELEVATION RENDERING  
 A-6 REAR ELEVATION RENDERING

**COVERAGE & F.A.R.**

SITE PLAN: 23,855.00 SQ. FT. = .547 ACRES  
 EXISTING COVERAGE: 7,200.00 SQ. FT. = 29.7%  
 PROPOSED COVERAGE: 7,200.00 SQ. FT. = 29.7%  
 EXISTING: 7,094.00 SQ. FT. = 29.7%  
 PROPOSED: 7,094.00 SQ. FT. = 29.7%

**LEGEND**

	EXISTING TO REMAIN
	EXISTING WALLS, CASEWORK, FIXTURES, ETC., TO BE REMOVED
	EXISTING TO REMAIN
	EXISTING TO BE REMOVED
	EXISTING TO BE RELOCATED

DATE	10/02/18
SCALE	1/8" = 1'-0"
SHEET	A-1.0
SHEET SIZE	24 x 36

**SITE / EXISTING PLAN**  
 201-19-028  
 946 EL CAMINO REAL, SUNNYVALE, CA 94087

NOTE \*  
 THIS DRAWING, THE IDEAS, DESIGNS, PLANS AND SPECIFICATIONS ARE PROPRIETARY TO OWNER/BUILDER AND WERE DESIGNED AND DEVELOPED FOR USE SOLELY IN CONNECTION WITH THIS PROJECT. NO TRANSFER OF ANY RIGHT IS INTENDED EXCEPT UPON THE WRITTEN PERMISSION OF OWNER/BUILDER. THIS DRAWING IS NOT TO BE REPRODUCED OR COPIED IN WHOLE OR IN PART OR USED FOR OTHER PURPOSES THAN THE SPECIFIED PROJECT.

REVISION	BY
	12-02-18 PLAN CHECK COMMENTS



**CIRCULATION PLAN**  
N.T.S.

DRAWN BY:  
RICK REYNOLDS  
BOULDER CREEK, CA 95006  
408-320-3616  
EMAIL:PRECISIONFITDESIGNS@YAHOO.COM

**CIRCULATION PLAN**  
**201-19-028**  
**946 BILLIARDS**  
942-948 W. EL CAMINO REAL, SUMMVALLE, CA 94087


NOTE \*

THIS DRAWING, THE IDEAS, DESIGNS, PLANS AND SPECIFICATIONS ARE PROPRIETARY TO OWNER/BUILDER AND WERE DESIGNED AND DEVELOPED FOR USE SOLELY IN CONNECTION WITH THIS PROJECT. NO TRANSFER OF ANY RIGHT IS INTENDED EXCEPT UPON THE WRITTEN PERMISSION OF OWNER/BUILDER. THIS DRAWING BE REPRODUCED OR COPIED IN WHOLE OR IN PART OR USED FOR OTHER PURPOSES THAN THE SPECIFIED PROJECT.


DATE	10/02/18
SCALE	N.T.S.
SHEET	A-1.1
SHEET SIZE	24 x 36

Luminaire Schedule						
Symbol	Qty	Model Number	Arrangement	Lumens	LLF	Description
■	3	ALED4T150 - Cool - RAB02138MO	SINGLE	18464	1.000	150 Watt LED Wall Pack w/ 5000K Color Temp. and Forward Throw Optic (16' Mounting Height)

Calculation Summary							
Label	CalcType	Units	Avg	Max	Min	Avg/Min	
Back Lot	Illuminance	Fc	2.59	9.8	0.1	25.90	98.00

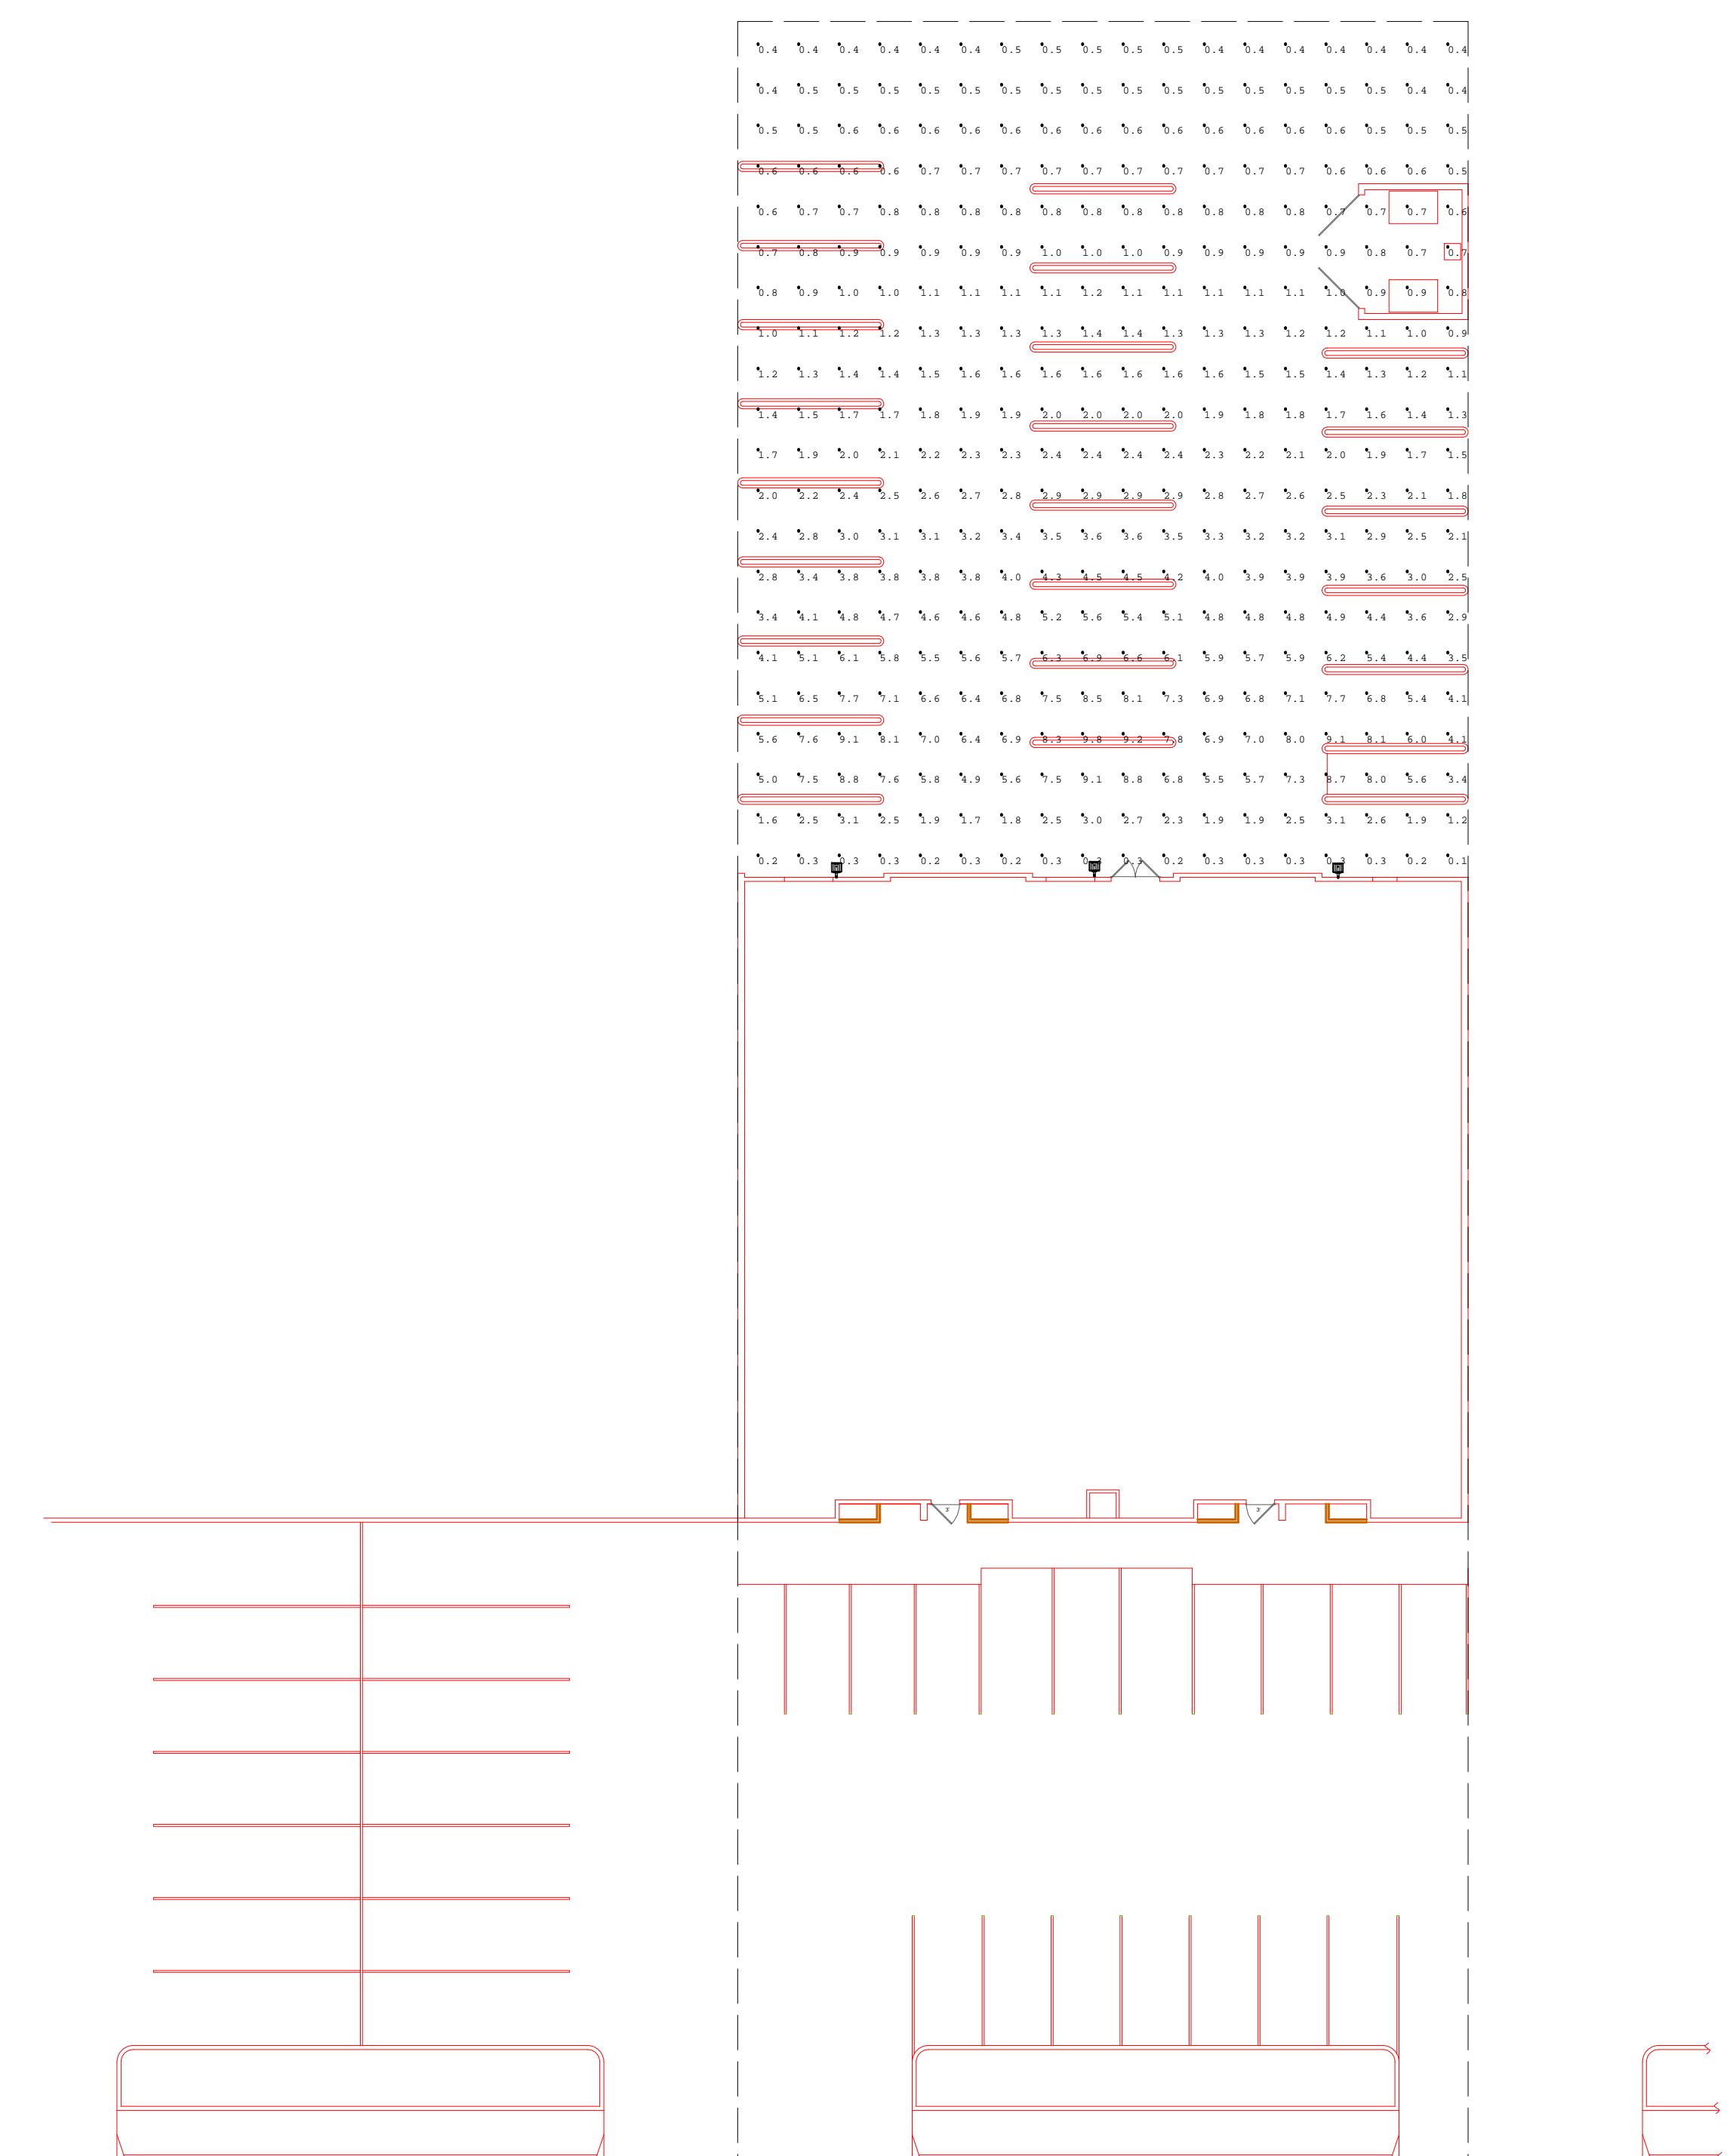

WPLED4T150

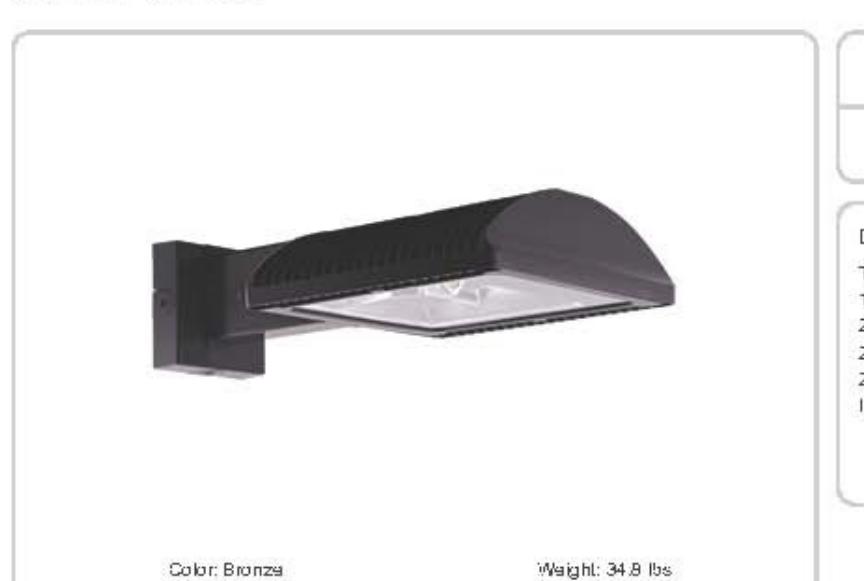

Project:	Type:
Prepared By:	Date:
Driver Info	LED Info

Driver Info: Constant Current: 150W  
120V: 1.31A  
208V: 0.80A  
240V: 0.69A  
277V: 0.60A  
Input Watts: 155.8W  
Efficiency: 118.5 LP/W

LED Info: Color: 5000K (Cool)  
Color Accuracy: 71 CRI  
L70 Lifespan: 100,000 hours  
Lumen: 18,464  
Efficiency: 118.5 LP/W

Color: Bronze

Weight: 34.8 lbs

Color Uniformity:

Mounting:

UL Listing:

Satisfactory for wet locations

DLC Listed:

The product is on the Design Lights Consortium (DLC) Qualified Products List and is eligible for rebates from DLC Member Utilities.

DLC Product Code: P0000174K

IESNA LM-79 &amp; LM-80 Testing:

RAB LED luminaires and LED components have been tested by an independent laboratory in accordance with IESNA LM-79 and LM-80.

LED Characteristics

Lifespan:

100,000-hour LED lifespan based on IES LM-80 results and TM-21 calculations

LEDs:

Multi-chip, high-output, long-life LEDs

Color Consistency:

7-step MacAdam Ellipse Tinning to achieve consistent fixture-to-fixture color

Color Stability:

LED color temperature is warranted to shift no more than 200K in CCT over a 5-year period

IP Rating:

Ingress Protection rating of IP66 for dust and water

Maximum Ambient Temperature:

Suitable to use in 40°C (104°F)

Cold Weather Starting:

Minimum starting temperature is -40°C (-40°F)

Thermal Management:

Superior thermal management with external "Air-Flow" fins

Housing:

Die-cast aluminum housing, lens frame and mounting arm

Color Temperature:

Color Accuracy:

Mounting:

Heavy-duty mounting arm with "O" ring seal &amp; stainless steel screws

Reflector:

Speaker vacuum-machined polycarbonate

Gaskets:

High-temperature silicone gaskets

Finish:

Formulated for high durability and long-lasting color

Green Technology:

Mercury and UV free, RoHS-compliant components

Construction:

Color Uniformity:

Mounting:

Heavy-duty mounting arm with "O" ring seal &amp; stainless steel screws

Reflector:

Speaker vacuum-machined polycarbonate

Gaskets:

High-temperature silicone gaskets

Finish:

Formulated for high durability and long-lasting color

Green Technology:

Mercury and UV free, RoHS-compliant components

Color Temperature:

Color Accuracy:

Mounting:


Heavy-duty mounting arm with "O" ring seal &amp; stainless steel screws

Reflector:

Speaker vacuum-machined polycarbonate

CCTV Camera System	Symbol	Qty	Type	LED LIGHTING FIXTURE
		3		

CCTV System - Rear Parking		CAMERA SPEC	SYMBOL	QTY		
HIK VISION OUTDOOR DOME CAMERA		4 MP 2.8 MM Lens		4		

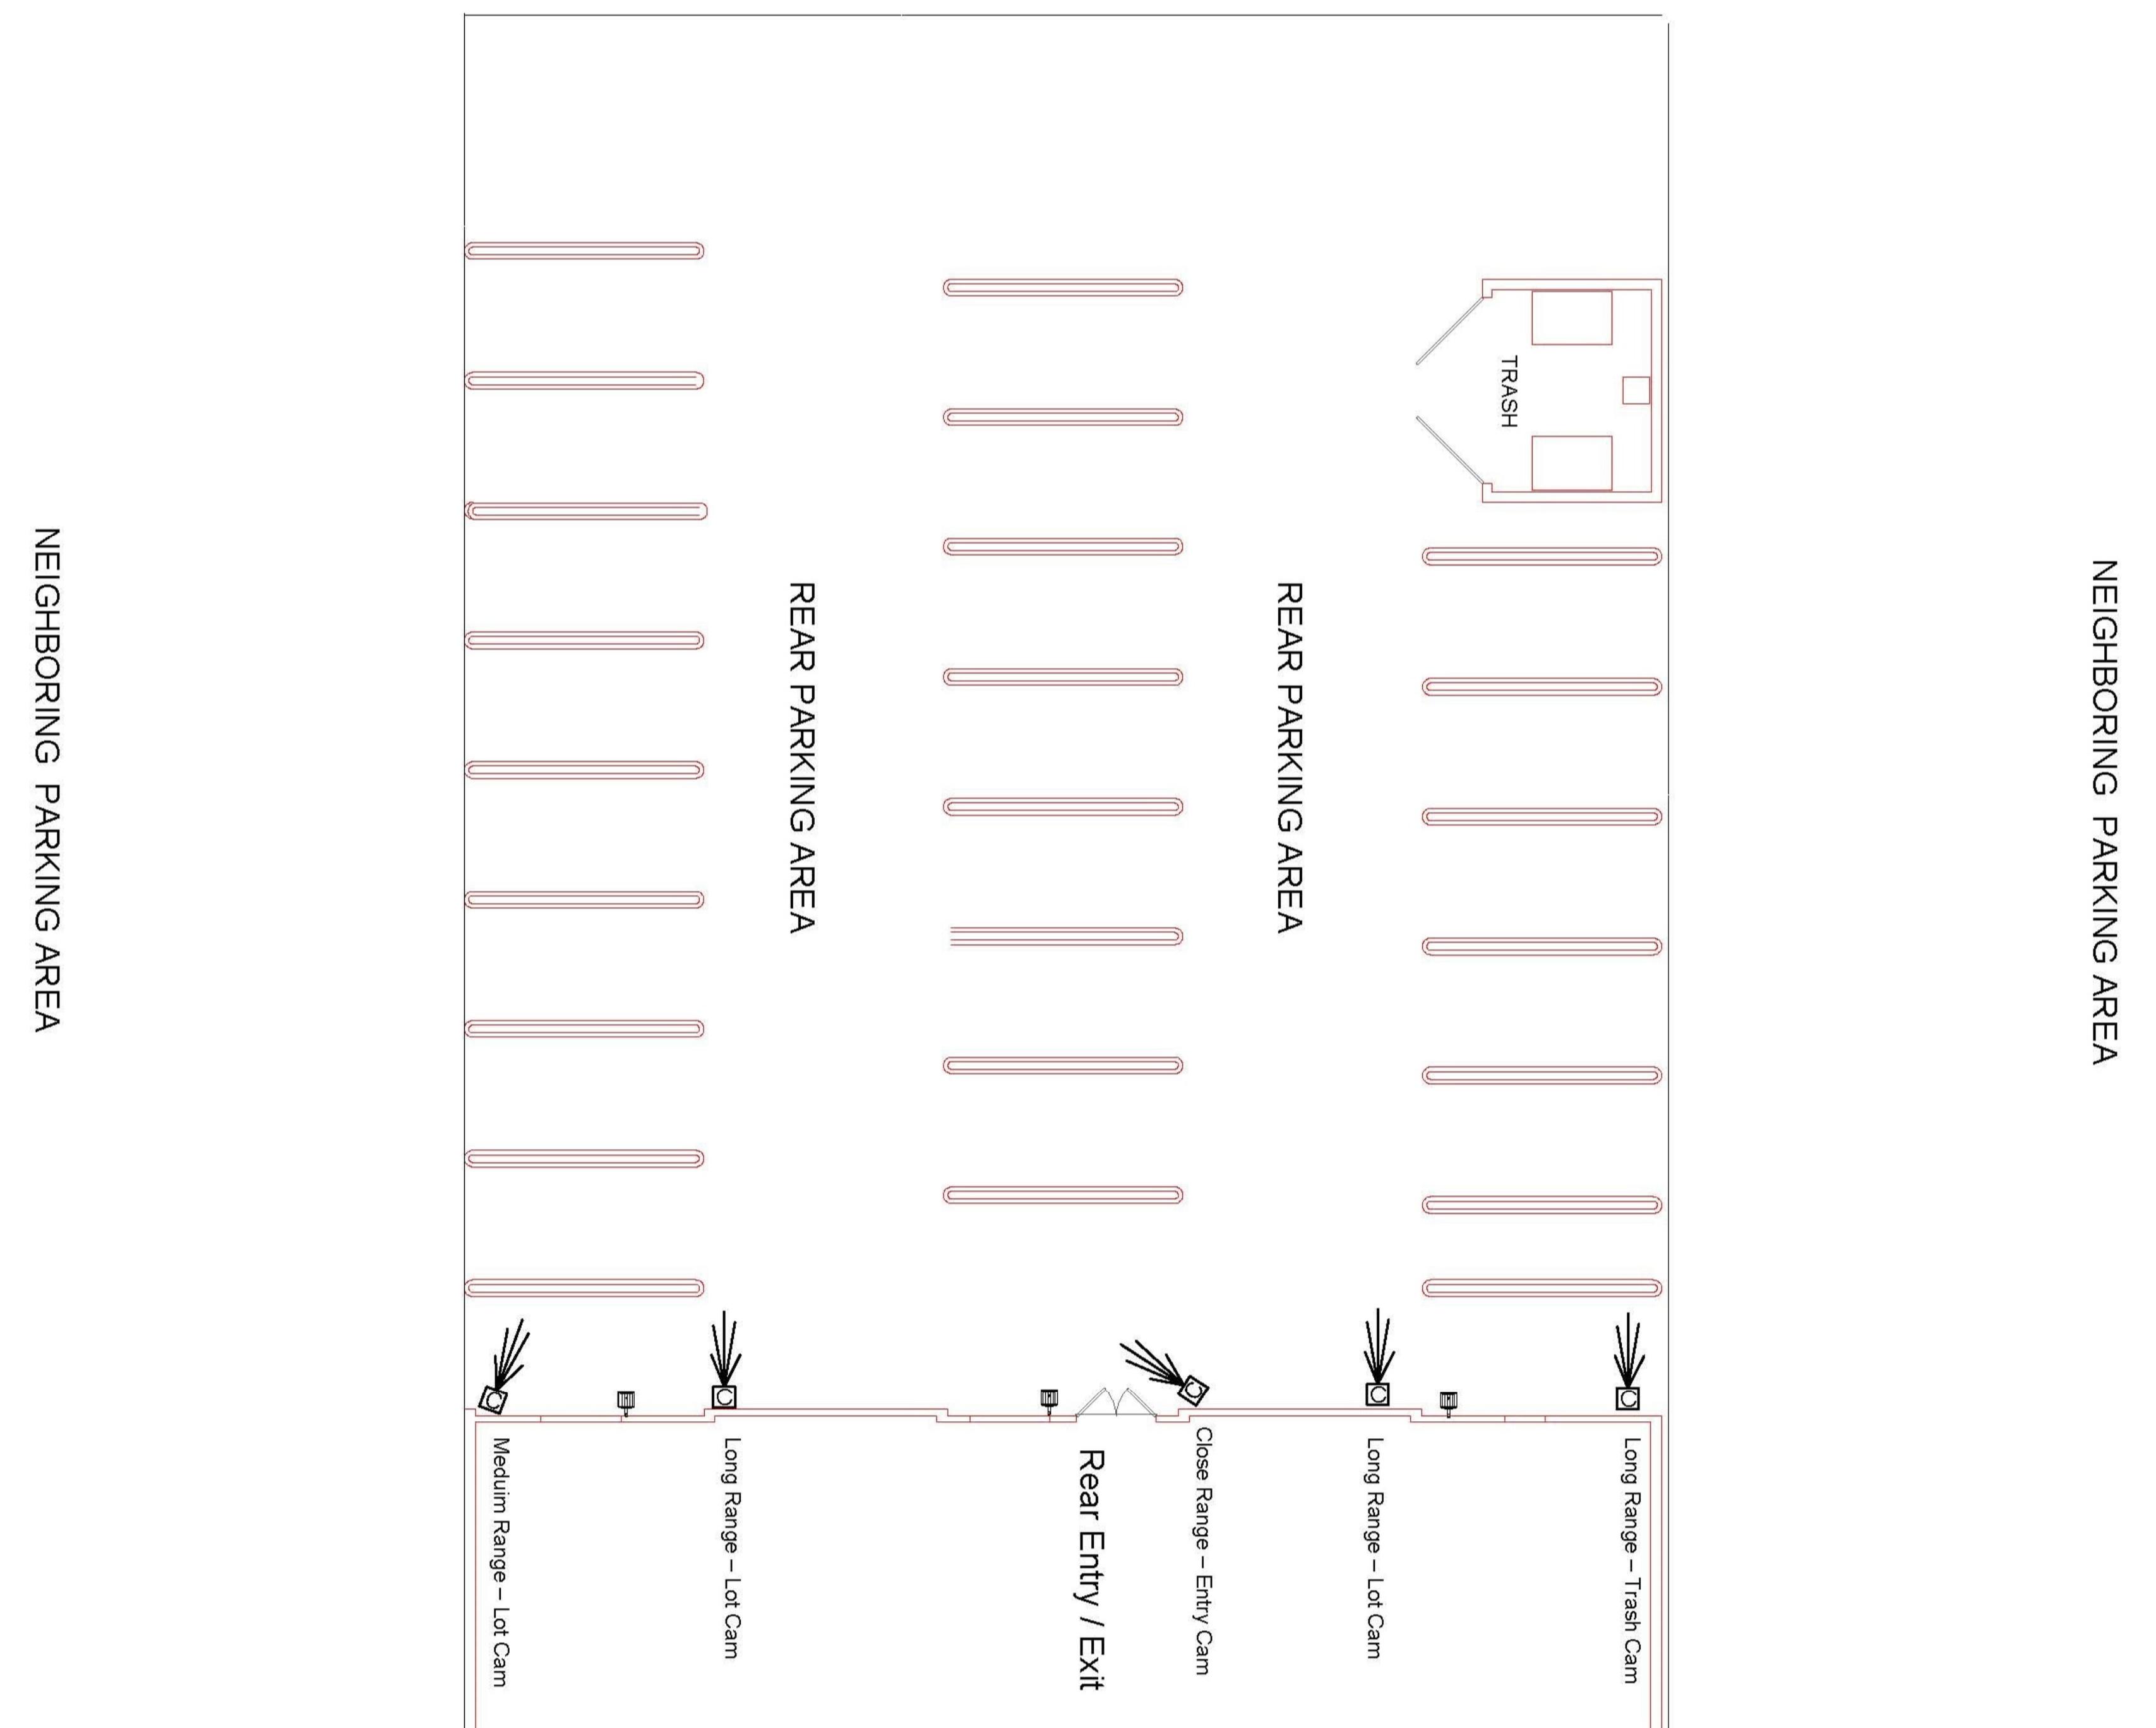


Good Faith proposal for outdoor cameras in the rear parking area.  
Actual Device model and specifications may vary slightly when contracting begins.


FOR PURCHASING INFORMATION OF APPROVED  
EQUIPMENT SPECIFIED ON THIS PLAN CONTACT:

Matt Taylor  
TPS, Inc.  
PO BOX 2096  
Los Gatos, CA 95031-2096  
O 408-354-8997  
C 408-691-6996  
Matt@taylorprotection.com

A-1.2a

DATE: 04/08/2019  
CONTACT: Matt Taylor 408-691-6996 C.  
PROJECT: Billiards CCTV  
LOCATION: 946 E Camino - Sunnyvale, CA 94087

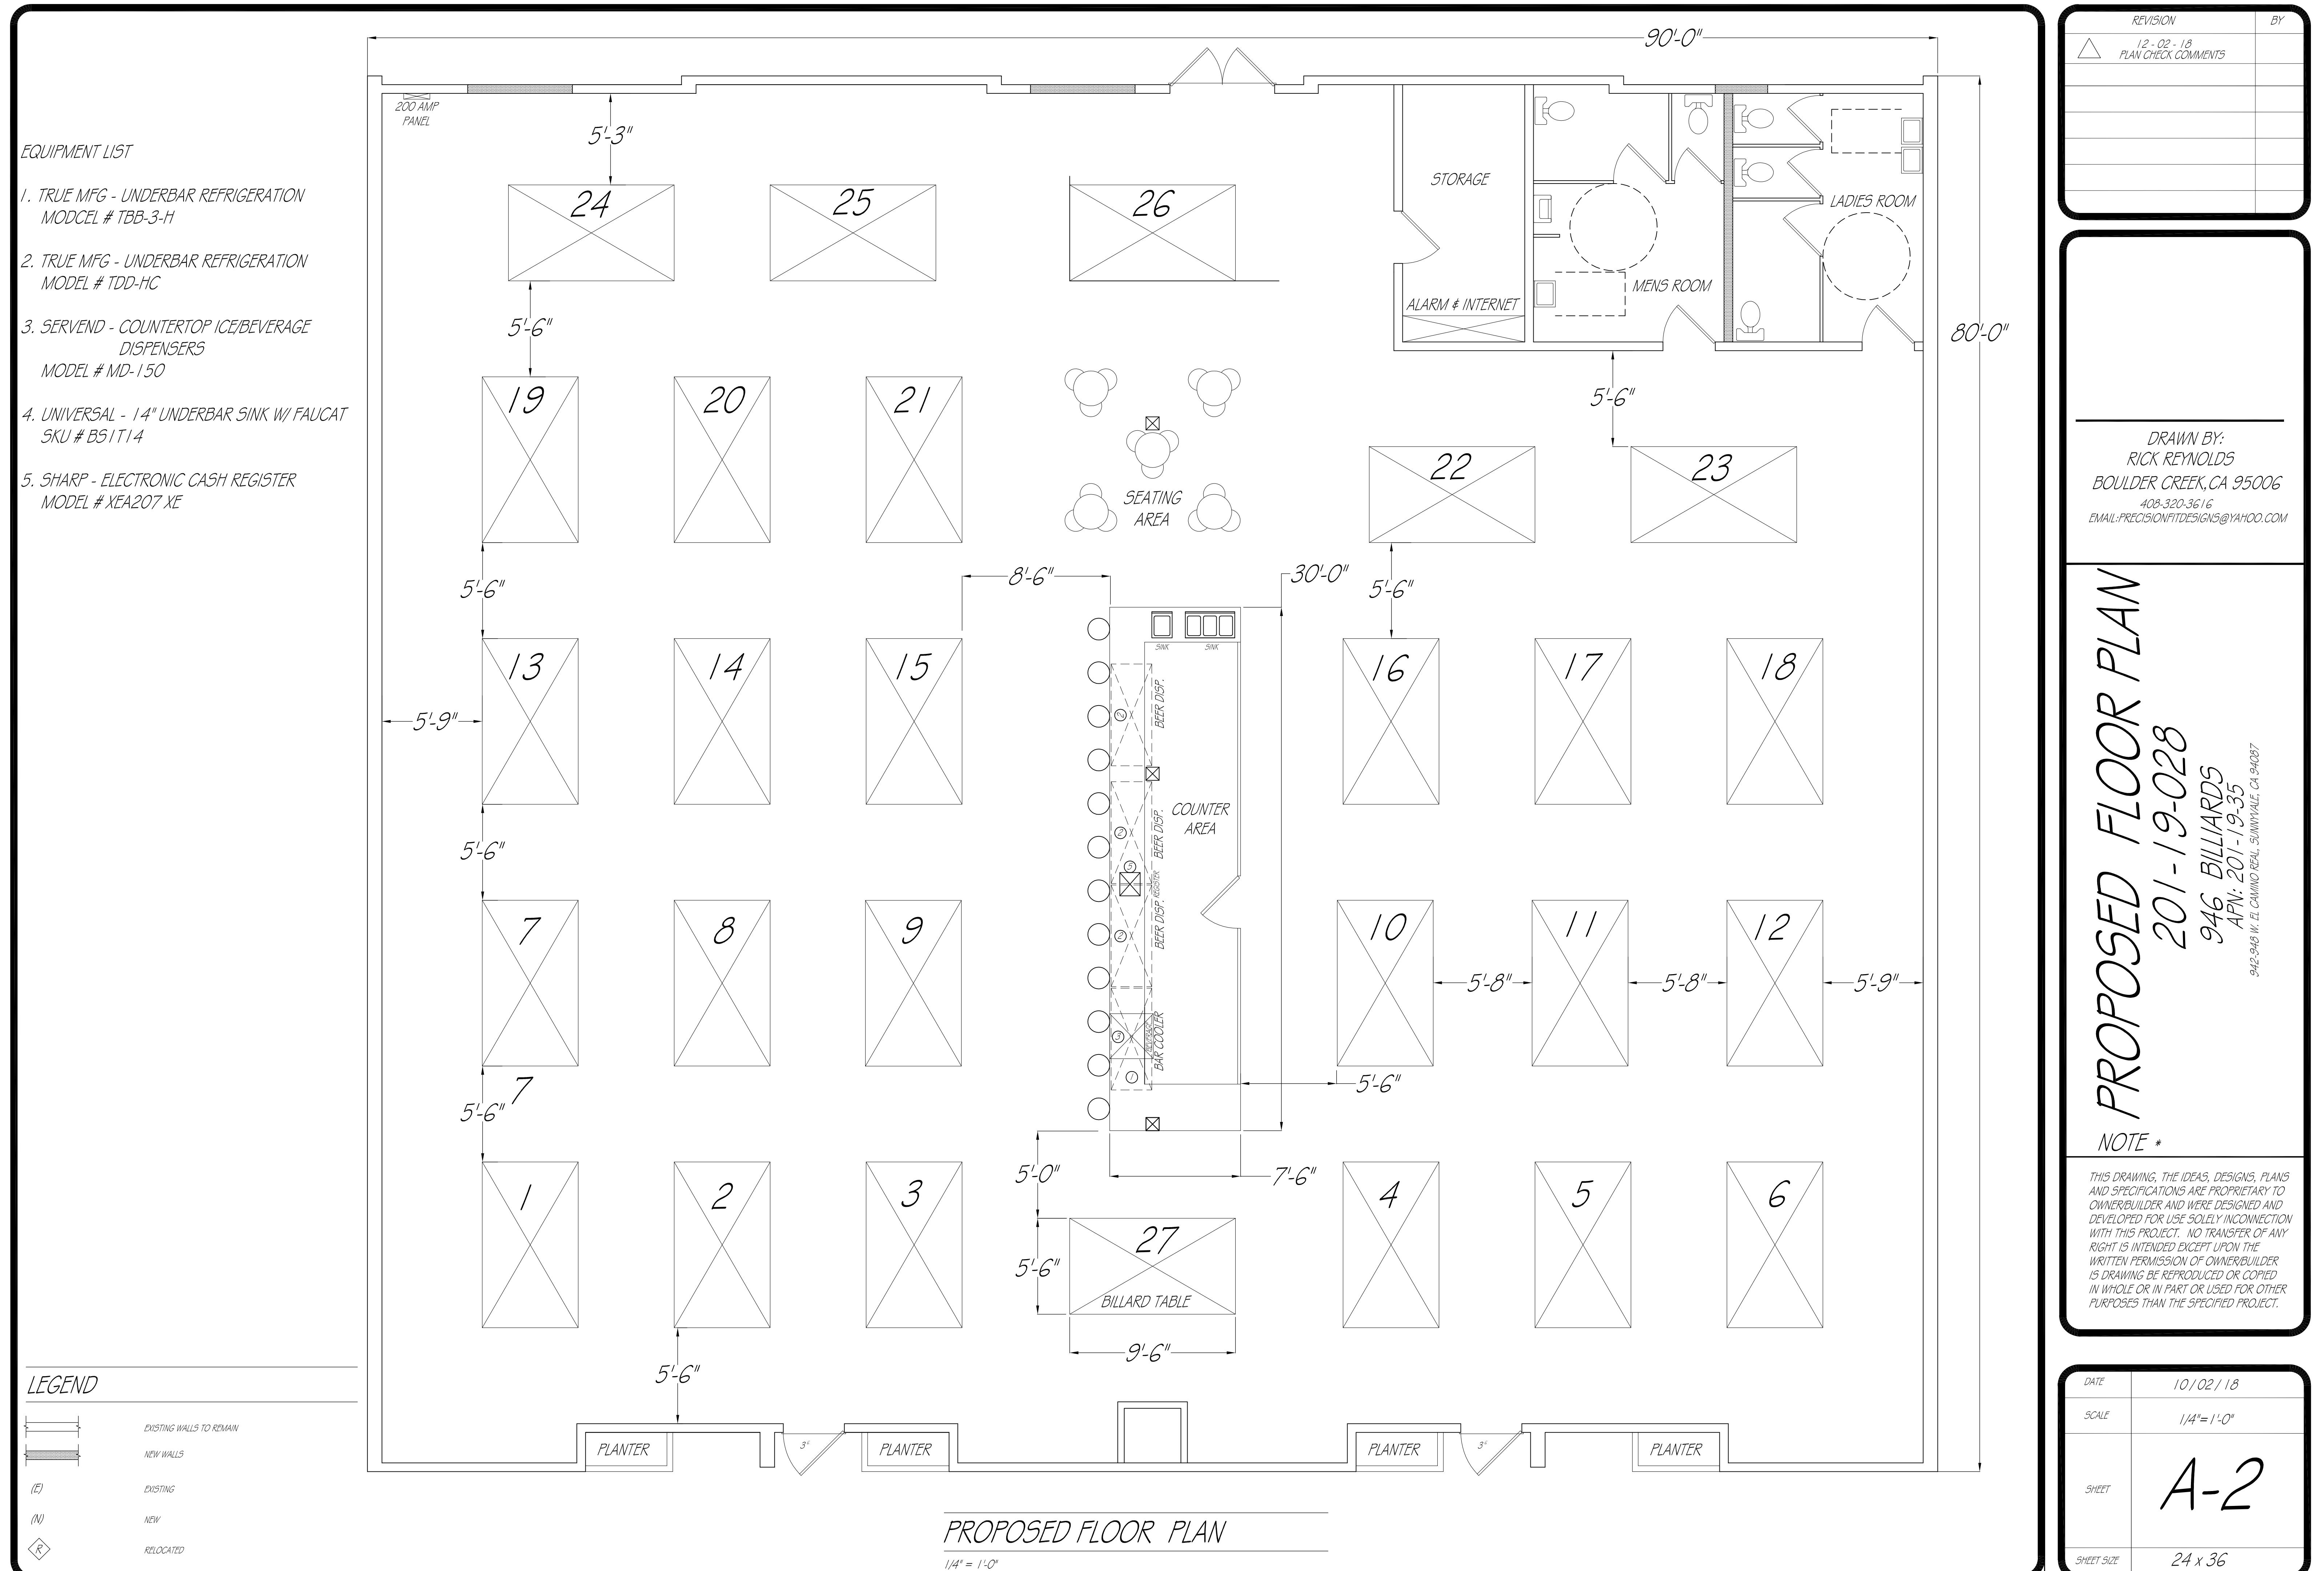

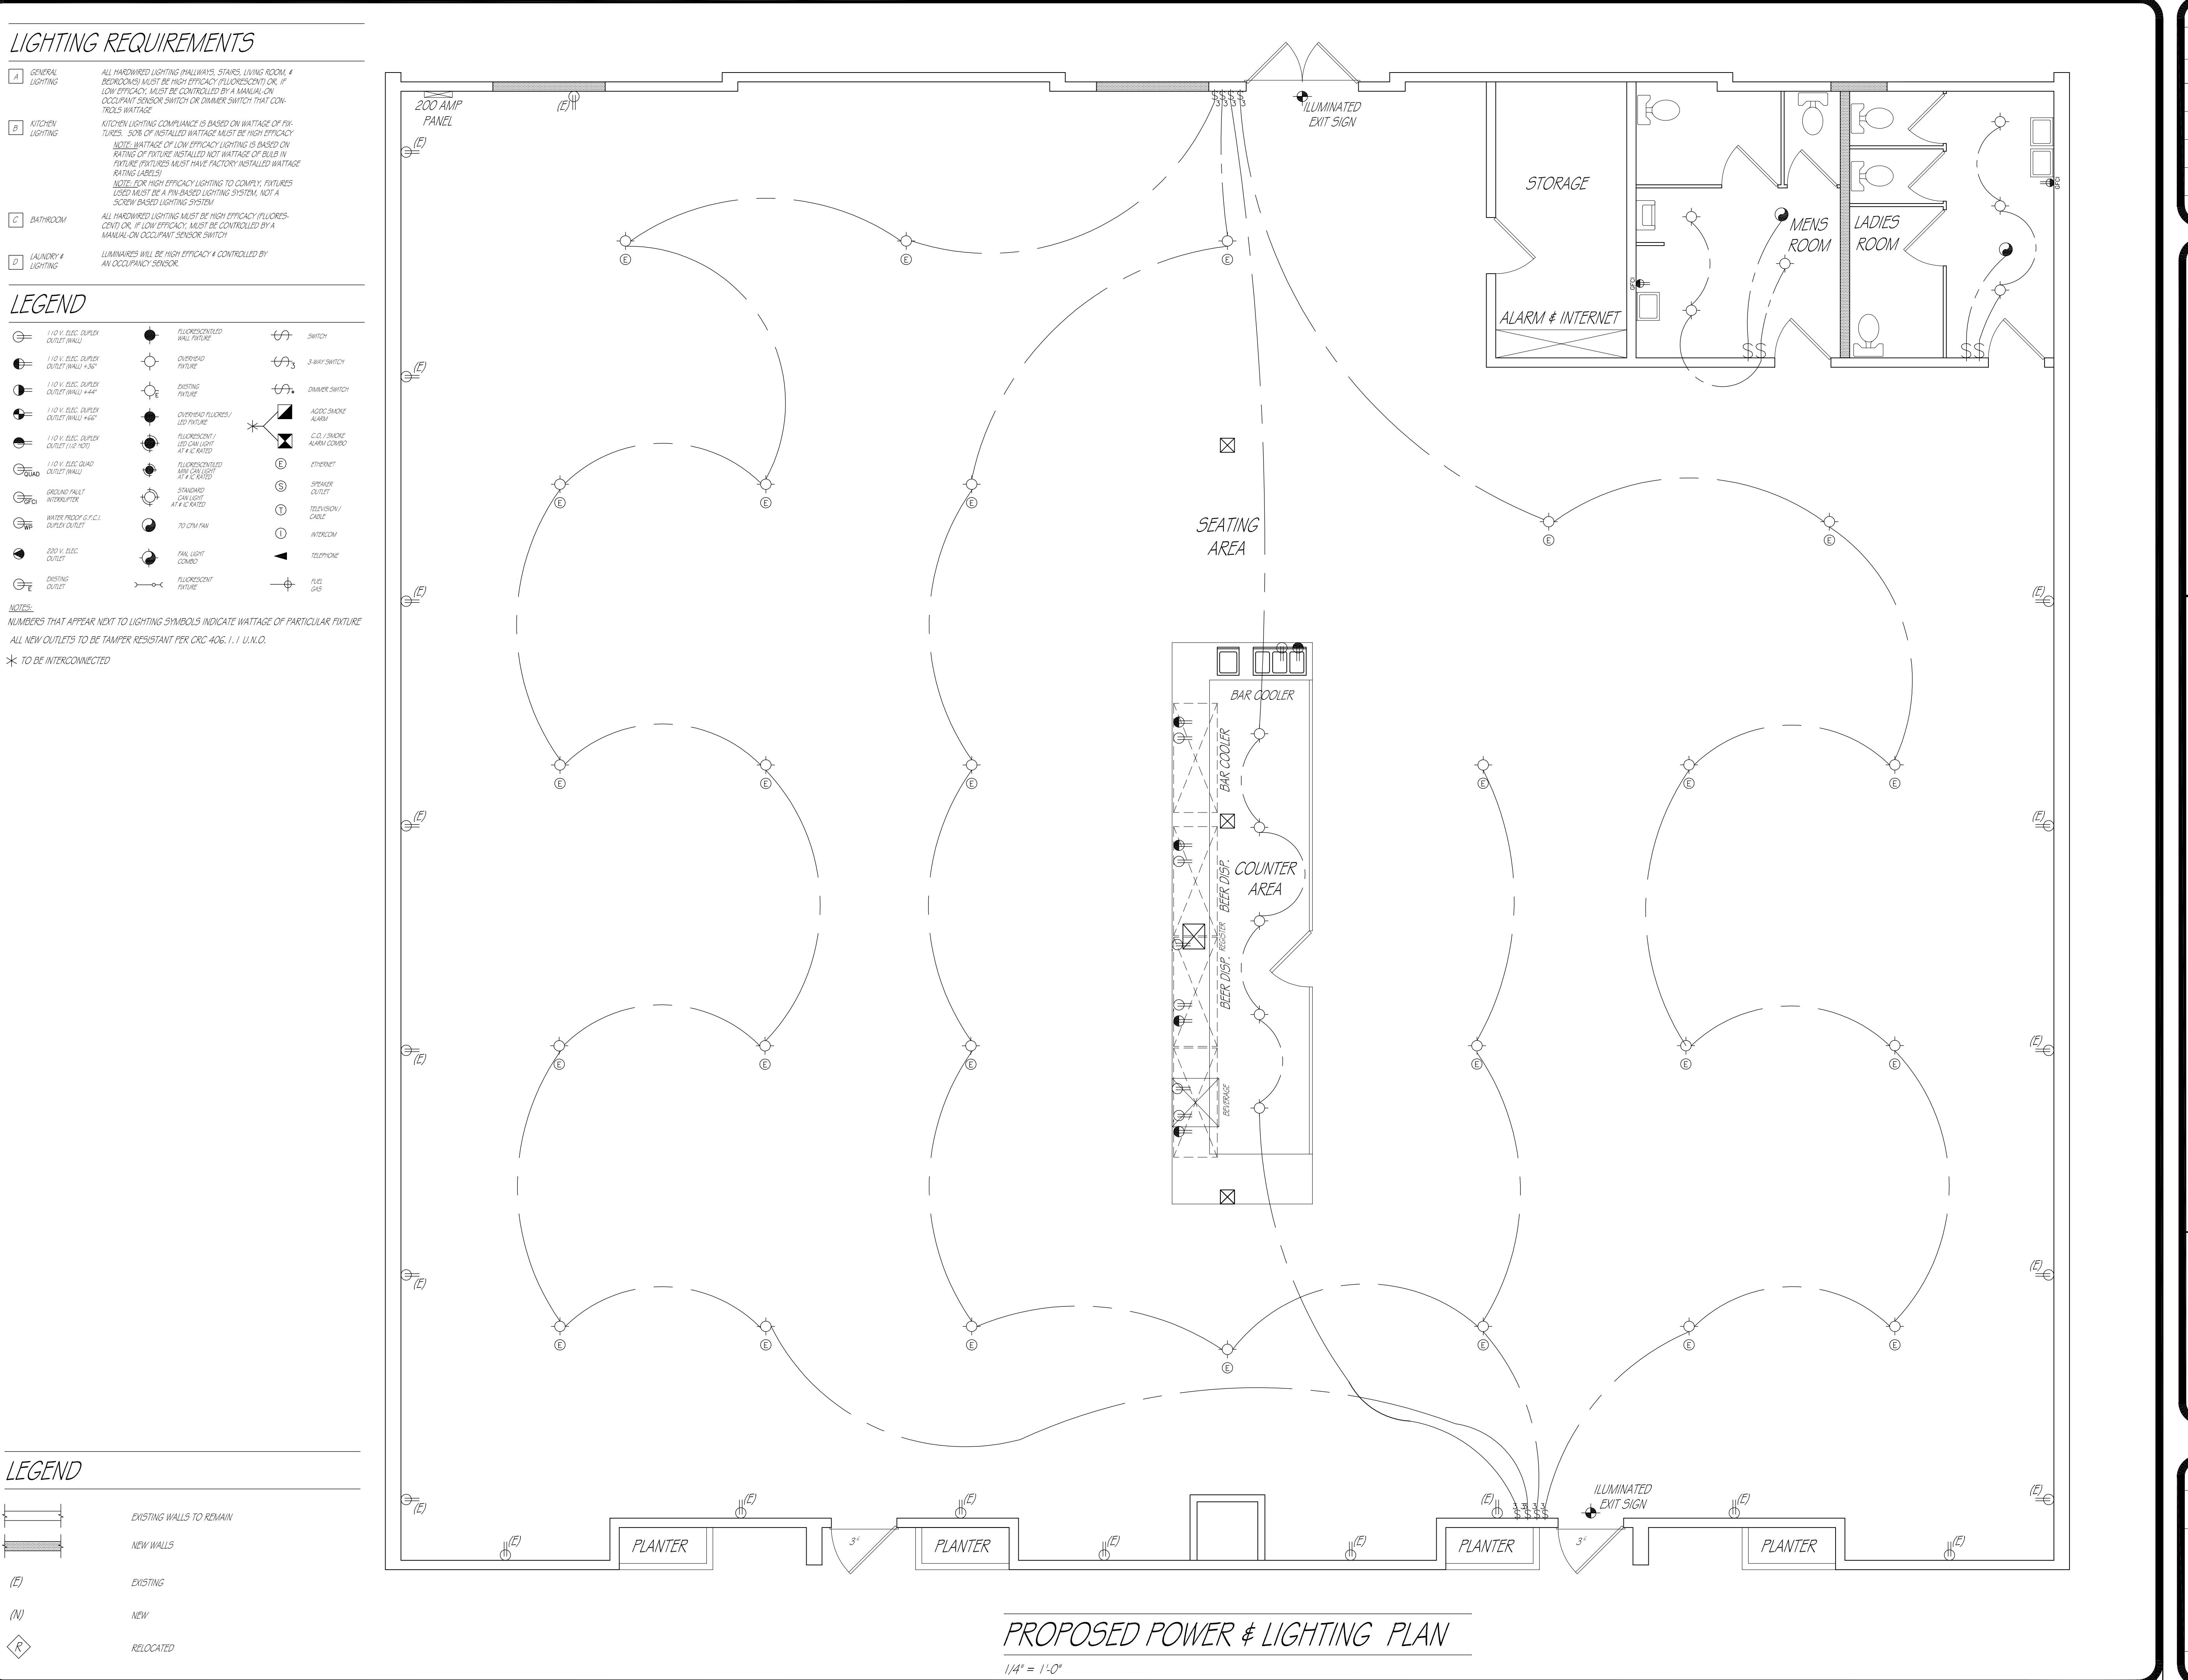

REVISION	BY
△ 12-02-18	PLAN CHECK COMMENTS

DRAWN BY:  
RICK REYNOLDS  
BOULDER CREEK, CA 95006  
408-320-3616  
EMAIL:PRECISIONFITDESIGNS@YAHOO.COM


# PROPOSED ELECTRICAL PLAN

201-19-028

946 BILLIARDS  
APL: 201-19-35  
942-948 W. EL CAMINO REAL, SUNNYVALE, CA 94087

DATE	10/02/18
SCALE	1/4" = 1'-0"
SHEET	A-3
SHEET SIZE	24 x 36

NOTE \*  
THIS DRAWING, THE IDEAS, DESIGNS, PLANS AND SPECIFICATIONS ARE PROPRIETARY TO OWNER/BUILDER AND WERE DESIGNED AND DEVELOPED FOR USE SOLELY IN CONNECTION WITH THIS PROJECT. NO TRANSFER OF ANY RIGHT IS INTENDED EXCEPT UPON THE WRITTEN PERMISSION OF OWNER/BUILDER. DRAWING IS DRAWING BE REPRODUCED OR COPIED IN WHOLE OR IN PART OR USED FOR OTHER PURPOSES THAN THE SPECIFIED PROJECT.

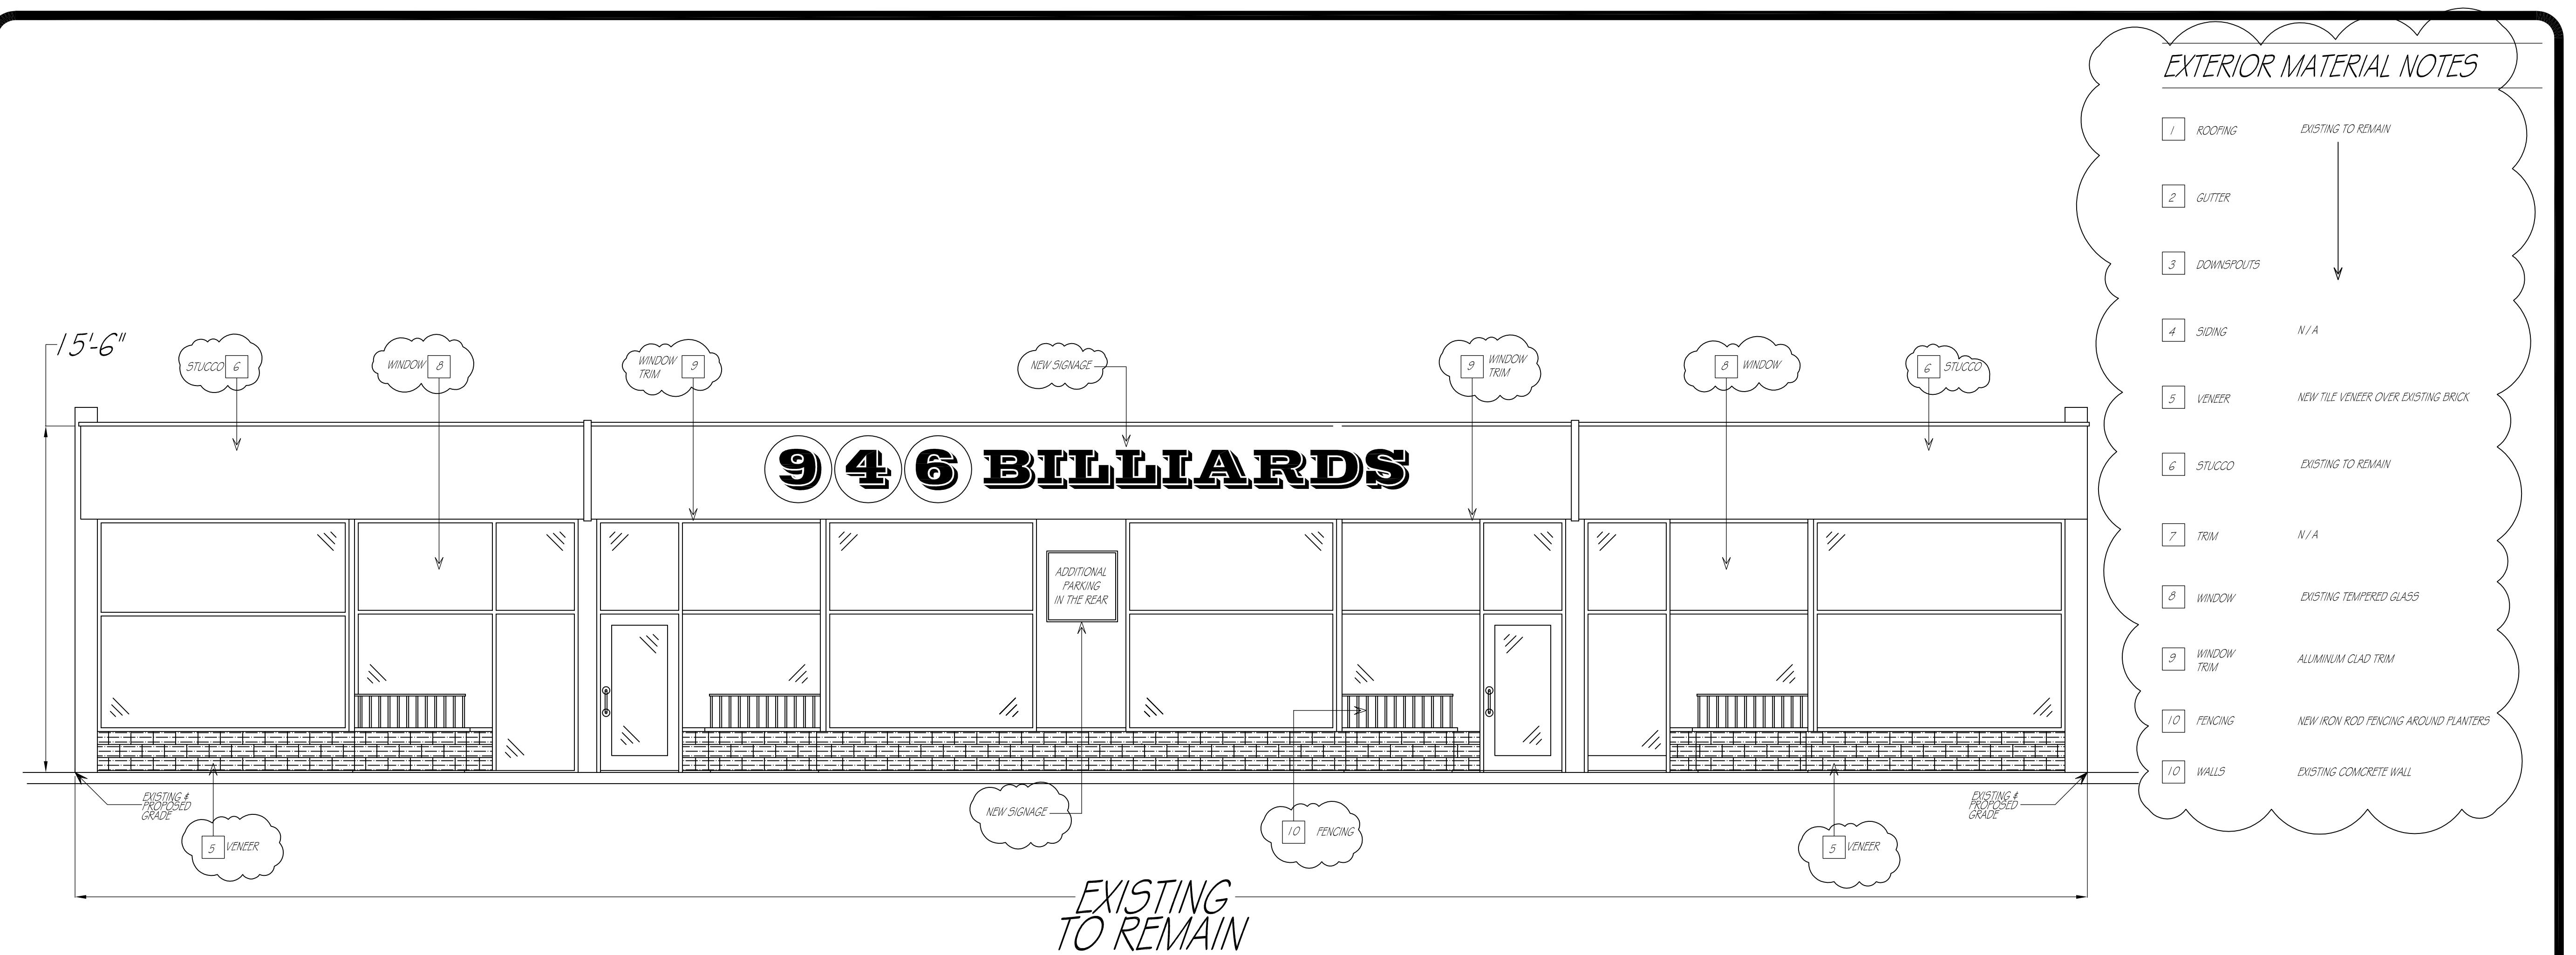


REVISION	BY

DRAWN BY:  
RICK REYNOLDS  
BOULDER CREEK, CA 95006  
408-320-3616  
EMAIL:PRECISIONFITDESIGNS@YAHOO.COM

**ELEVATION PLAN**  
201-19-028  
946. BILLIARDS  
APN: 201-19-35  
942-946 W. EL CAMINO REAL, SUNNYVALE, CA 94087

NOTE \*

THIS DRAWING, THE IDEAS, DESIGNS, PLANS AND SPECIFICATIONS ARE PROPRIETARY TO OWNER/BUILDER AND WERE DESIGNED AND DEVELOPED FOR USE SOLELY IN CONNECTION WITH THIS PROJECT. NO TRANSFER OF ANY RIGHT IS INTENDED EXCEPT UPON THE WRITTEN PERMISSION OF OWNER/BUILDER. NO DRAWING IS REPRODUCED OR COPIED IN WHOLE OR IN PART OR USED FOR OTHER PURPOSES THAN THE SPECIFIED PROJECT.

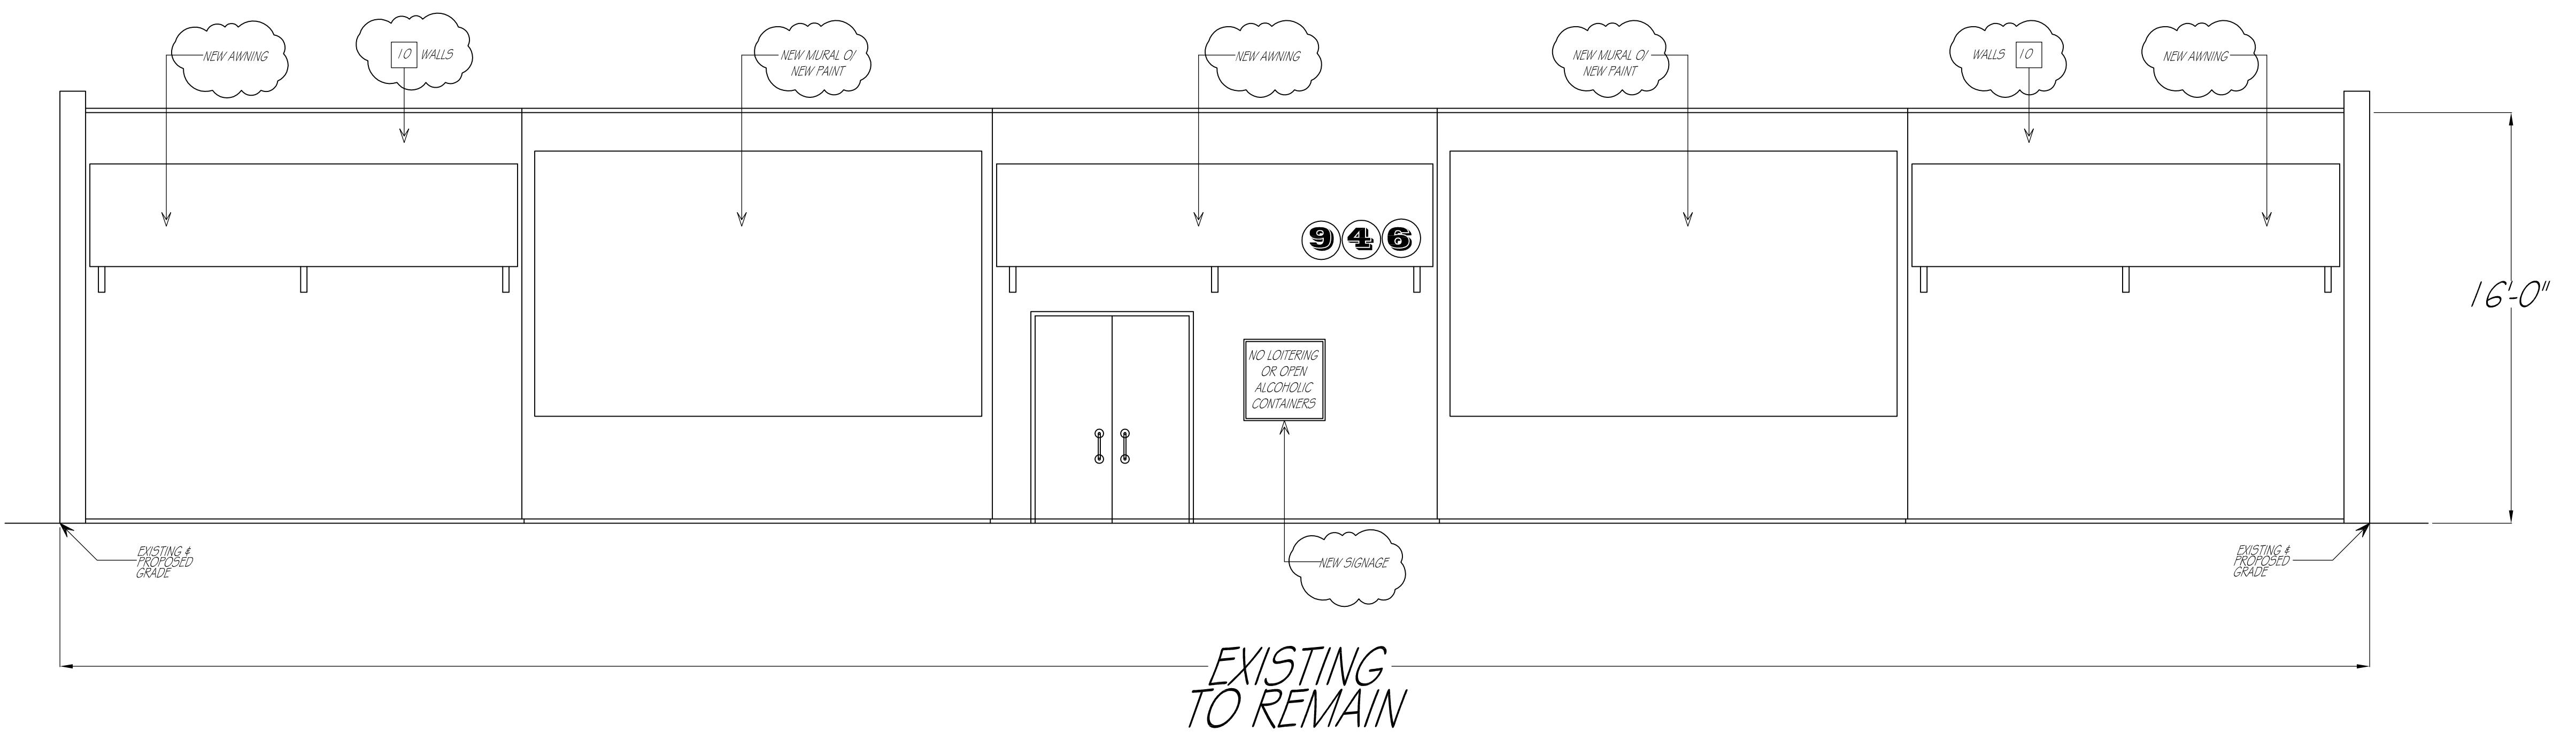

DATE	01/15/19
SCALE	1/4" = 1'-0"
SHEET	A-4
SHEET SIZE	24 x 36

**REVISIONS**  
A 04-05-19 PLAN CHECK COMMENTS

24 x 36



REVISION	BY
△	12-02-18 PLAN CHECK COMMENTS

DRAWN BY:  
RICK REYNOLDS  
BOULDER CREEK, CA 95006  
408-320-3616  
EMAIL:PRECISIONITDESIGNS@YAHOO.COM

FRONT ELEVATION  
RENDERING  
201-19-028  
946 BILLIARDS  
APN: 201-19-35  
942-948 W. EL CAMINO REAL, SUNNYVALE, CA 94087

NOTE \*

THIS DRAWING, THE IDEAS, DESIGNS, PLANS AND SPECIFICATIONS ARE PROPRIETARY TO OWNER/BUILDER AND WERE DESIGNED AND DEVELOPED FOR USE SOLELY IN CONNECTION WITH THIS PROJECT. NO TRANSFER OF ANY RIGHT IS INTENDED EXCEPT UPON THE WRITTEN PERMISSION OF OWNER/BUILDER. THIS DRAWING BE REPRODUCED OR COPIED IN WHOLE OR IN PART OR USED FOR OTHER PURPOSES THAN THE SPECIFIED PROJECT.

DATE	04/05/19
SCALE	N.T.S.
SHEET	A-5
SHEET SIZE	24 x 36



**REAR ELEVATION  
RENDERING  
201-19-028  
946 BILLIARDS  
APN: 201-19-35**

942-948 V. EL CAMINO REAL, SUNNYVALE, CA 94087

REVISION	BY
△	12-02-18 PLAN CHECK COMMENTS

DRAWN BY: RICK REYNOLDS BOULDER CREEK, CA 95006 408-320-3616 EMAIL: PRECISIONFITDESIGNS@YAHOO.COM

DATE	04/05/19
SCALE	N.T.S.
SHEET	A-6
SHEET SIZE	24 x 36